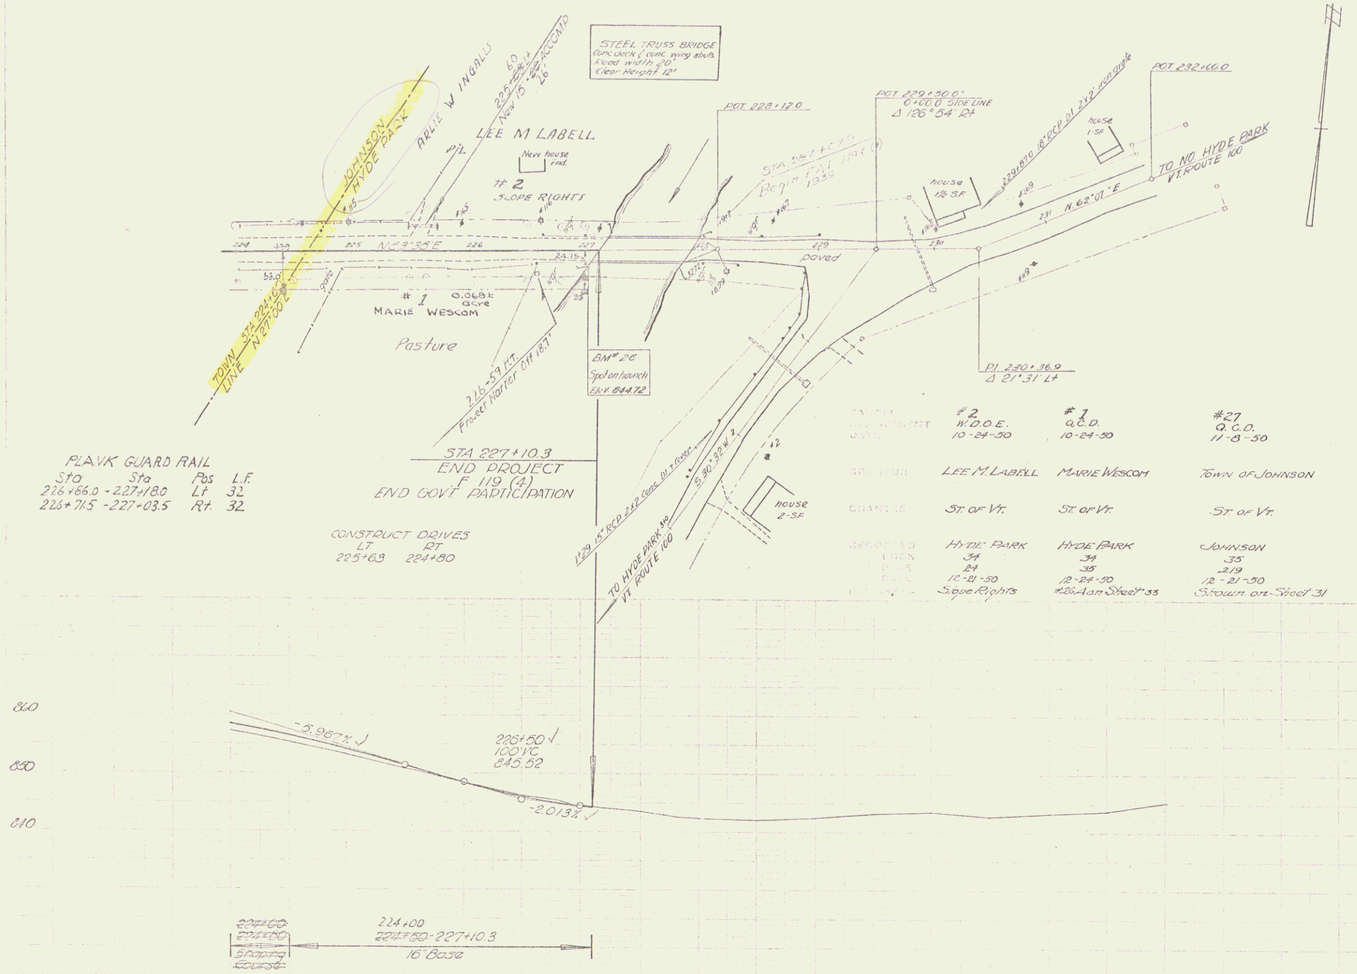

Lt. Rte 100C

JOHNSON - HYDE PARK
Series F 119(4)
Sheet 18 of 37

18