


ITEM 542 THREE CABLE GUARD RAIL
W/STEEL POSTS
STA 43+55 - STA 44+50 LT.
STA 43+45 - STA 44+25 RT.



EXISTING BRIDGE
COIL T-BEAM
CLEAR SPAN 31'-0"
PERPENDICULAR SPAN 28'-0"
CLEAR ROADWAY 20'-0"
CLEAR HEIGHT 3'
PAVED AREA 2'-0" W/
CONSTRUCTED 1986

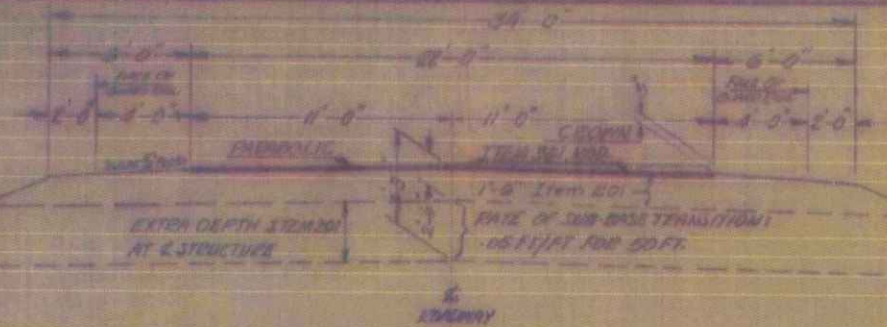

TYPICAL ROADWAY SECTION
SCALE: 1/2" = 1'-0"

BRIDGE BETTERMENT PROJECT
IN THE TOWN OF WAITSFIELD, COUNTY OF WASHINGTON, ON
HIGHWAY ROUTE 100, BEGINNING AT A POINT 0.400 MILES
NORTHERLY OF THE WARREN - WAITSFIELD TOWN-LINE AND
EXTENDING NORTHERLY 0.028 MILES.
PROJECT LENGTH = 0.028 MILES = 154 FEET.

1 2108.41
2 2180
3 2210
4 2240
5 2270
6 2300

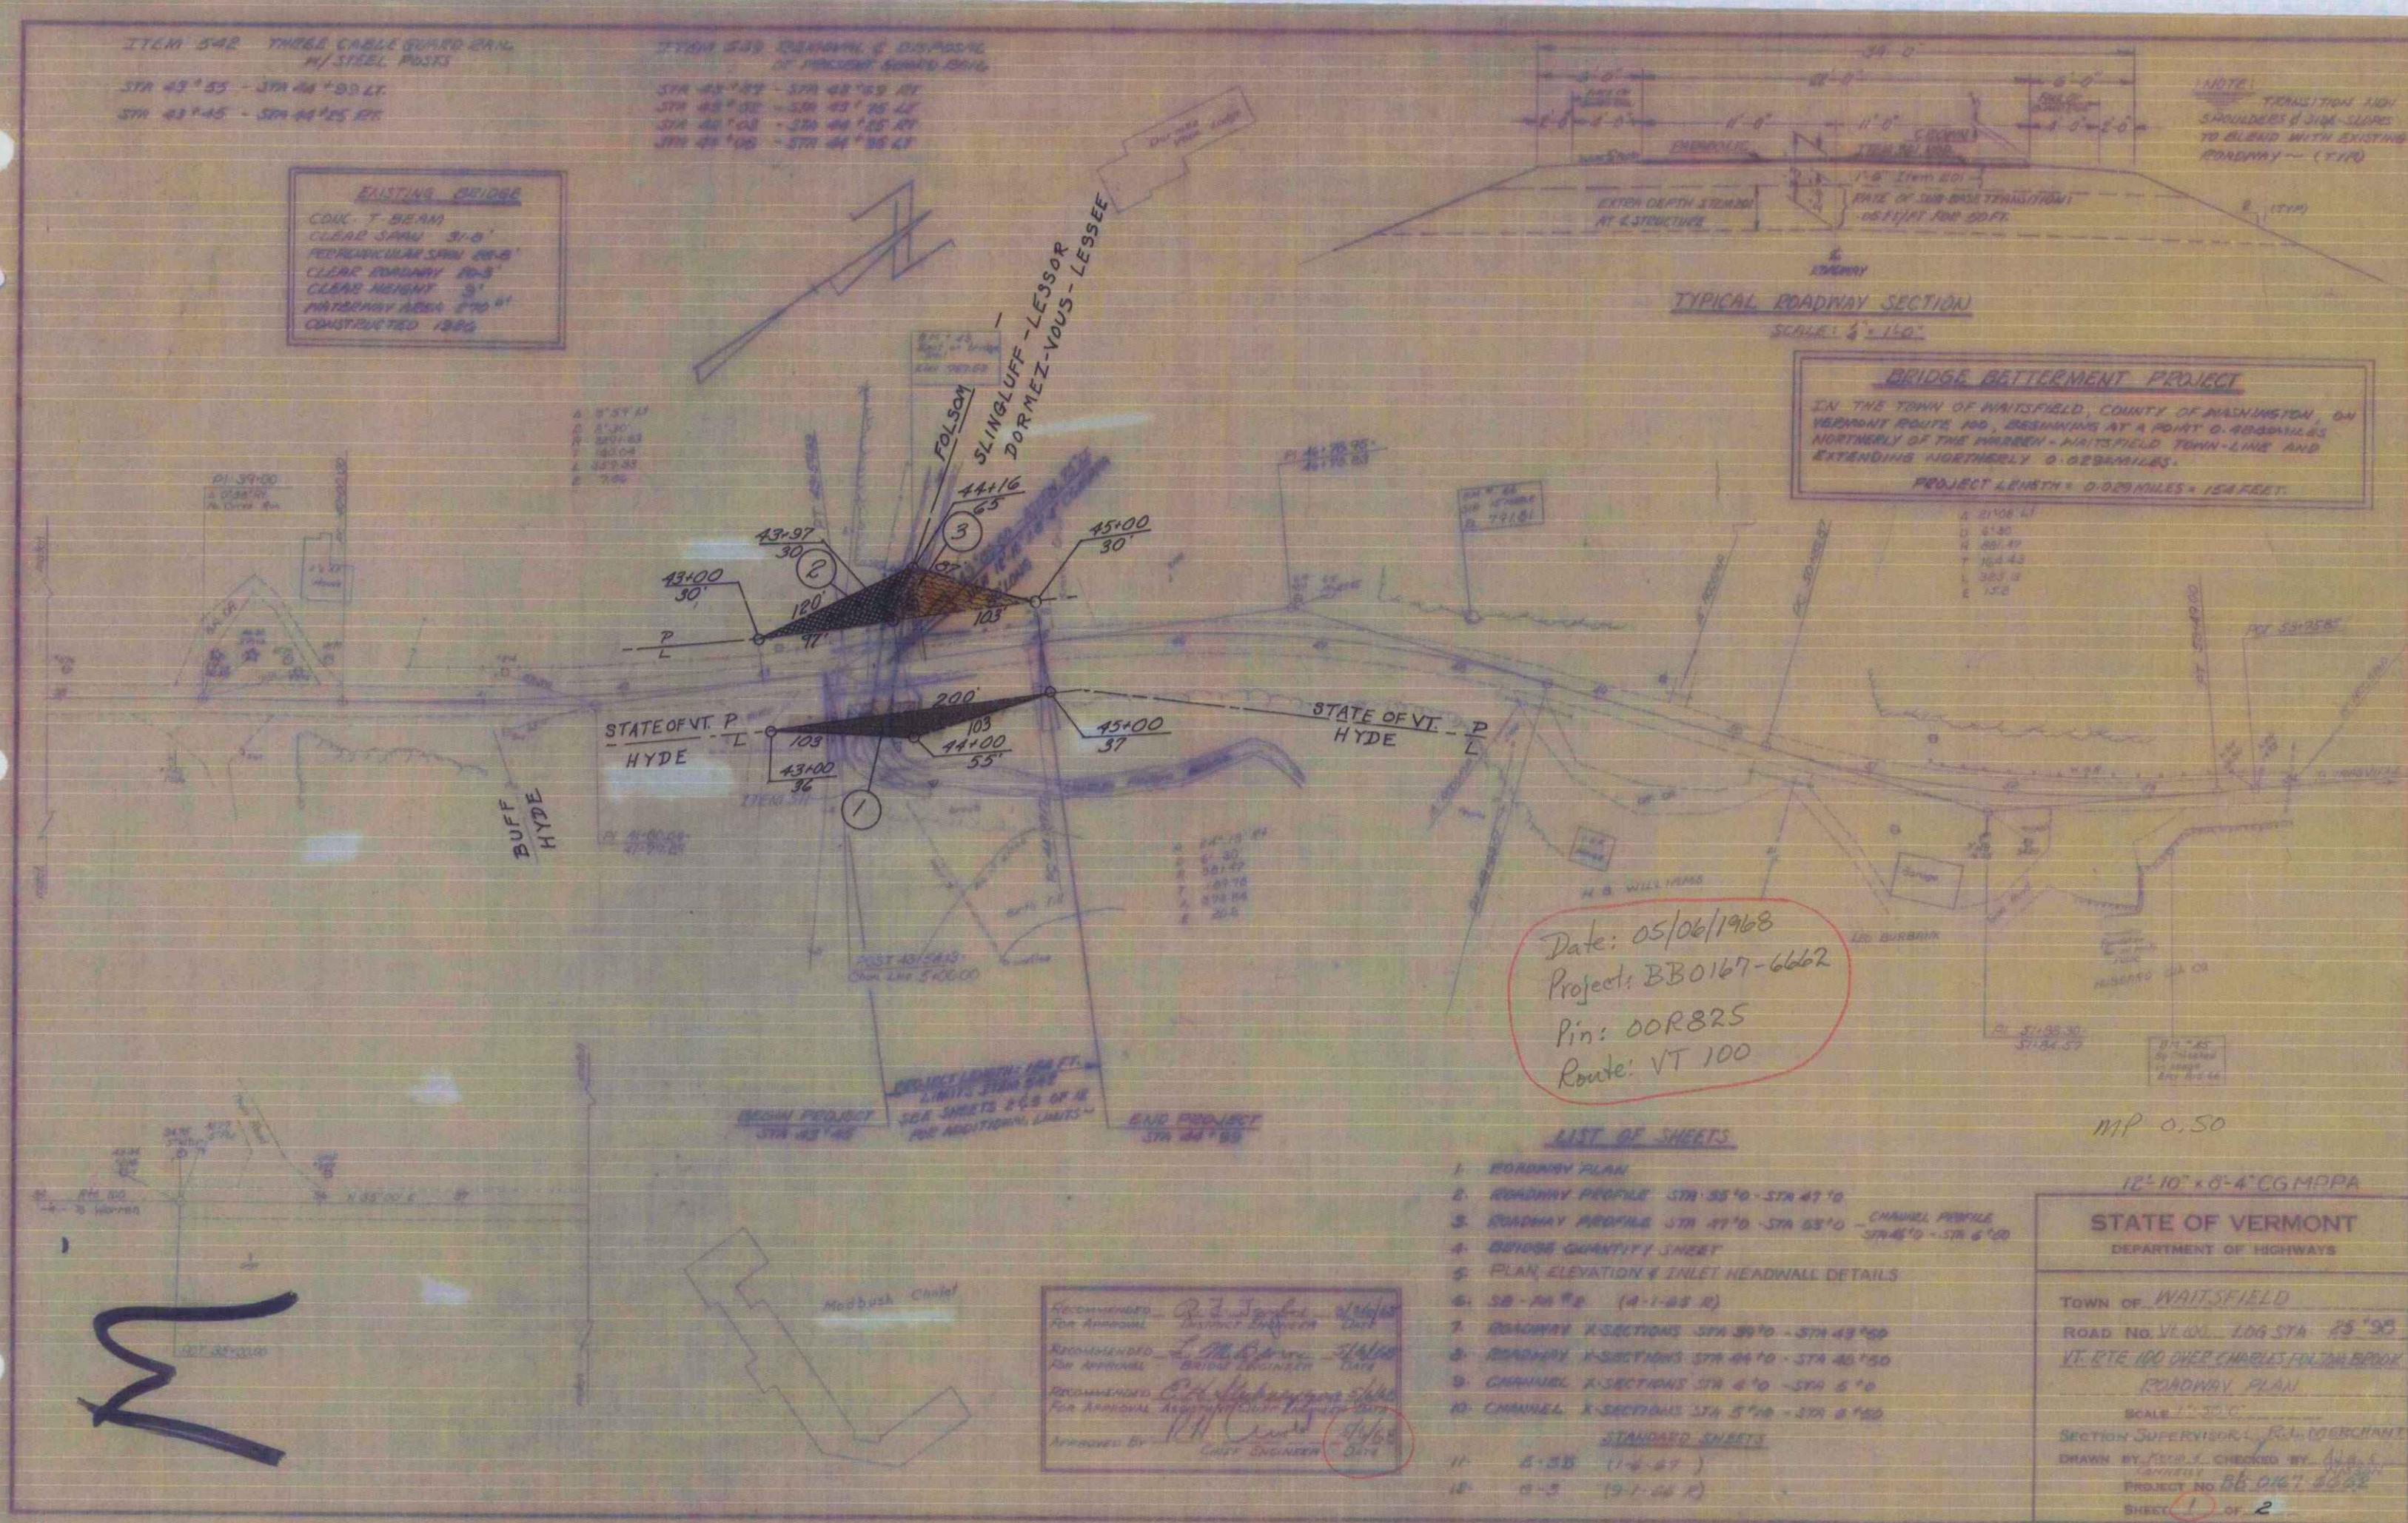

Date: 05/06/1968
Project: BB0167-6662
Pin: 00R825
Route: VT 100

- LIST OF SHEETS**
- ROADWAY PLAN
 - ROADWAY PROFILE STA 35+0 - STA 47+0
 - ROADWAY PROFILE STA 47+0 - STA 65+0 CHANNEl PROFILE STA 47+0 - STA 6+00
 - BRIDGE QUANTITY SHEET
 - PLAN, ELEVATION & INLET HEADWALL DETAILS
 - SB - PA 92 (A-1-88 R)
 - ROADWAY X-SECTIONS STA 39+0 - STA 43+00
 - ROADWAY X-SECTIONS STA 44+0 - STA 46+50
 - CHANNEl X-SECTIONS STA 4+0 - STA 6+0
 - CHANNEl X-SECTIONS STA 5+0 - STA 6+100
- STANDARD SHEETS
11 4-35 (1-4-67)
12 0-5 (9-1-66 R)

Recommended For Approval: [Signature] 5/16/68
Recommended For Approval: [Signature] 5/16/68
Recommended For Approval: [Signature] 5/16/68
Approved By: [Signature] 5/16/68
CITY ENGINEER

STATE OF VERMONT
DEPARTMENT OF HIGHWAYS
TOWN OF WAITSFIELD
ROAD NO. VT 100 106 STA 43+50
ROADWAY PLAN
SCALE: 1" = 20'
SECTION SUPERVISOR: R.A. LOERCHIANI
DRAWN BY: [Signature] CHECKED BY: [Signature]
PROJECT NO. BB 0167-6662
SHEET 1 OF 2

M

STATE OF VERMONT
DEPARTMENT OF HIGHWAYS
RIGHT-OF-WAY PLANS
DETAIL SHEET
OF

TABLE OF PROJECT PROPERTY ACQUISITION

PARCEL NO.	GRANTOR	SHEET NO.	BEGINNING STATION	ENDING STATION	TAKING	REM.	RIGHTS	TITLE TAKEN	DATE	TOWN OR CITY RECORDED	BK.	PG.	REMARKS
1	HYDE, ELIZABETH B. d/b/a MADBUSH CHALET		A3+00 A3+50RT	A5+00 A4+90RT	2000'		CHANNEL (P)						
2	FOLSON, MARY B. & FOLSON, WENDELL C. MOTHER & SON		A3+00 A3+75LT	A4+16 A4+25LT	1700'		CHANNEL (P)						
3	SLINGLUFF, DAVID & SCHAUS, NICHOLAS LESSORS DORNEZ YOU S INC. LESSEE		A3+97 A4+16 LT	A5+00 A4+40LT	1700'		CHANNEL (P)						

TABLE OF REVISIONS

REVISION NO.	SHEET NO.	DESCRIPTION OF REVISION	DATE	MADE BY	APPROVED BY

MADE BY: D.R.R. DATE: 5-28-68
CHECKED BY: A.W.B. DATE: 5-28-68

LEGEND

— — — — —	PRESENT R.O.W.	SR — SR	SLOPE RIGHTS
— — — — —	TAKING WITHOUT ACCESS	— P — P	PROPERTY LINE
— — — — —	TAKING WITHOUT ACCESS ALONG PROPERTY LINES	— Δ — Δ	TOP OF CUT
— — — — —	TAKING WITH ACCESS	— O — O	TOE OF SLOPE
(P)	PERMANENT EASEMENT		
(T)	TEMPORARY EASEMENT		

APPROVED: Thomas C. Donnelly DATE: 5-28-68
APPROVED: John P. Log DATE: 6-3-68
APPROVED: John P. Log DATE: 5-31-68

PROJECT WAITSFIELD
NO. BB 0167-6662
SHEET 2 OF 2