
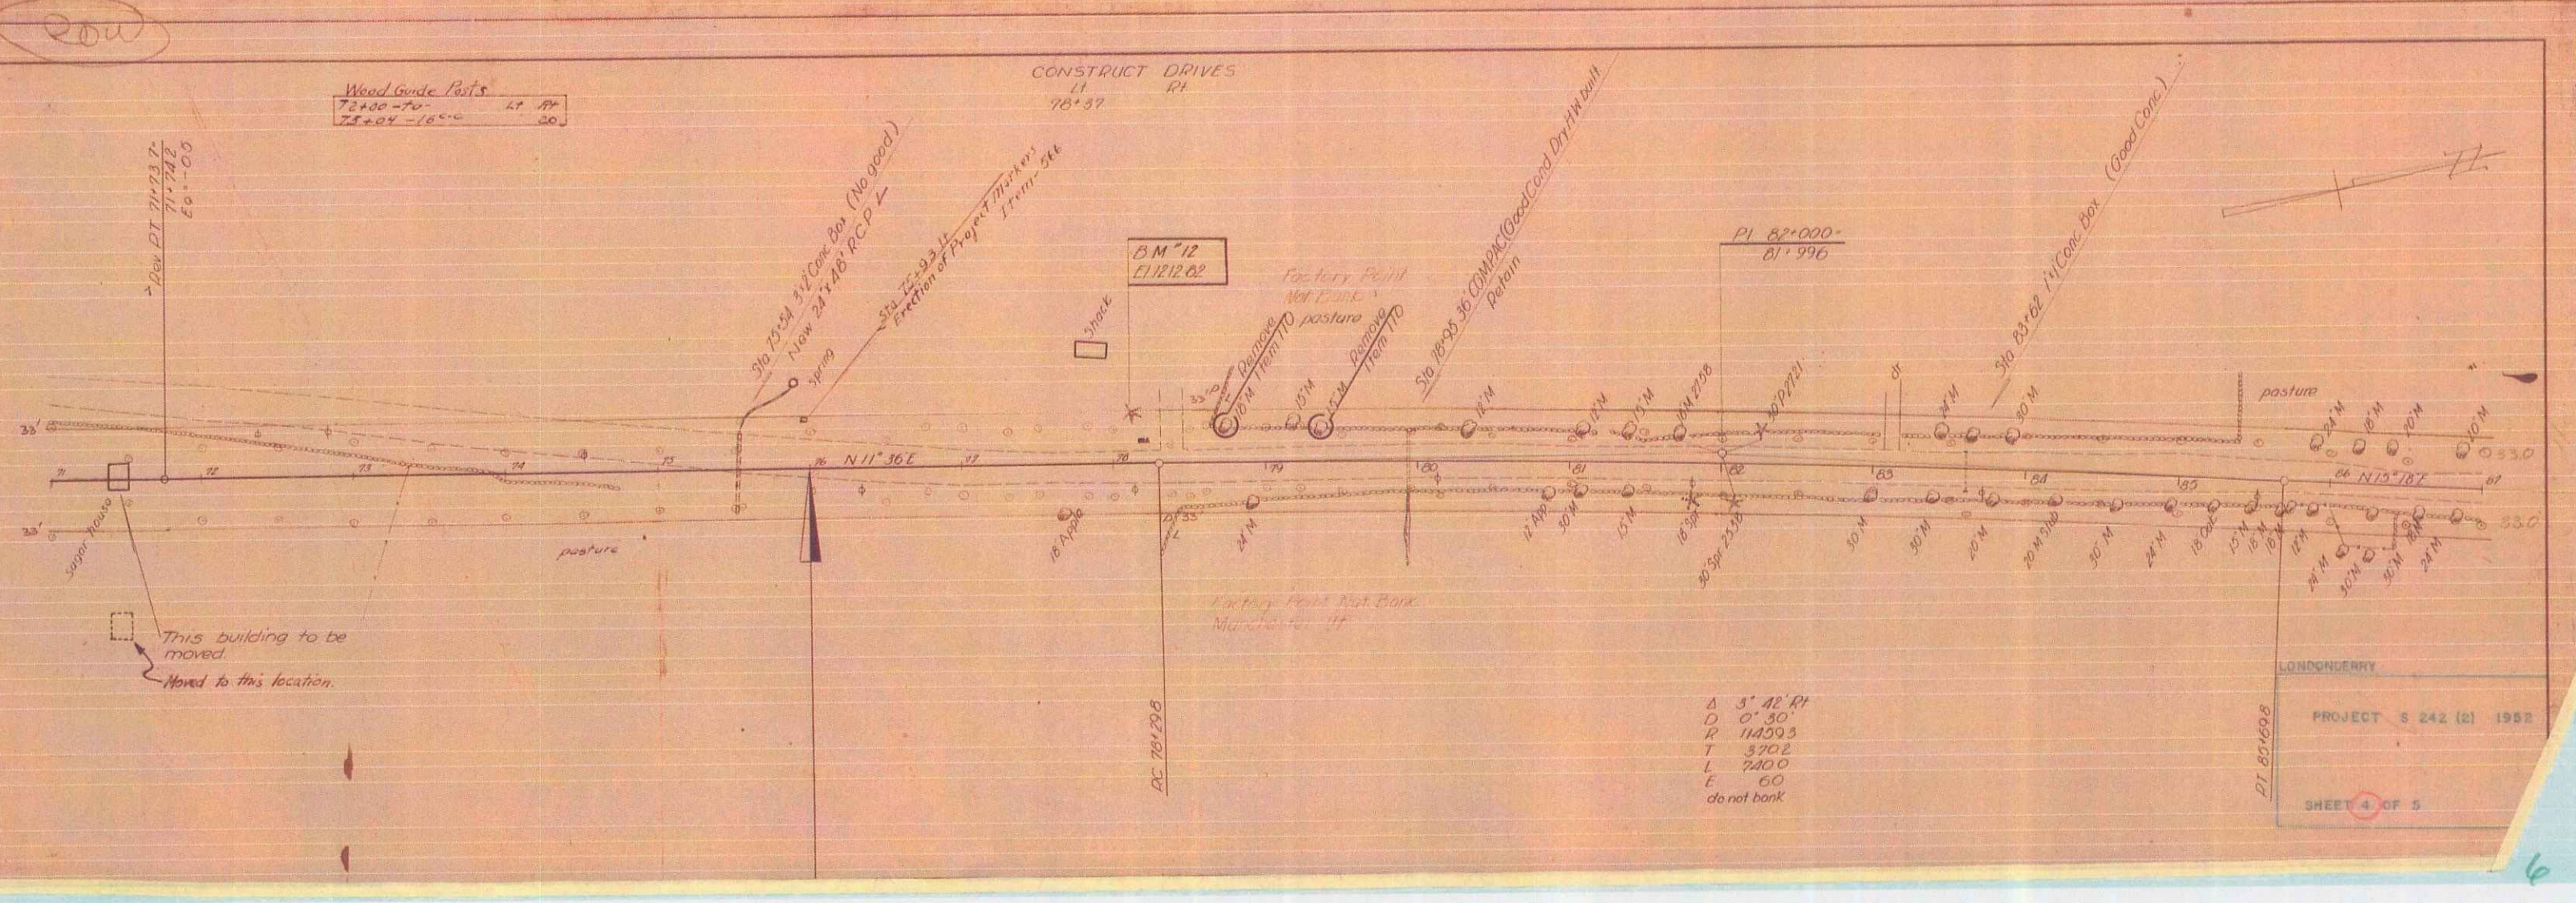


PLAN	DATE	BY
REVISED	DATE	BY
APPROVED	DATE	BY
CHECKED	DATE	BY
DATE	BY	

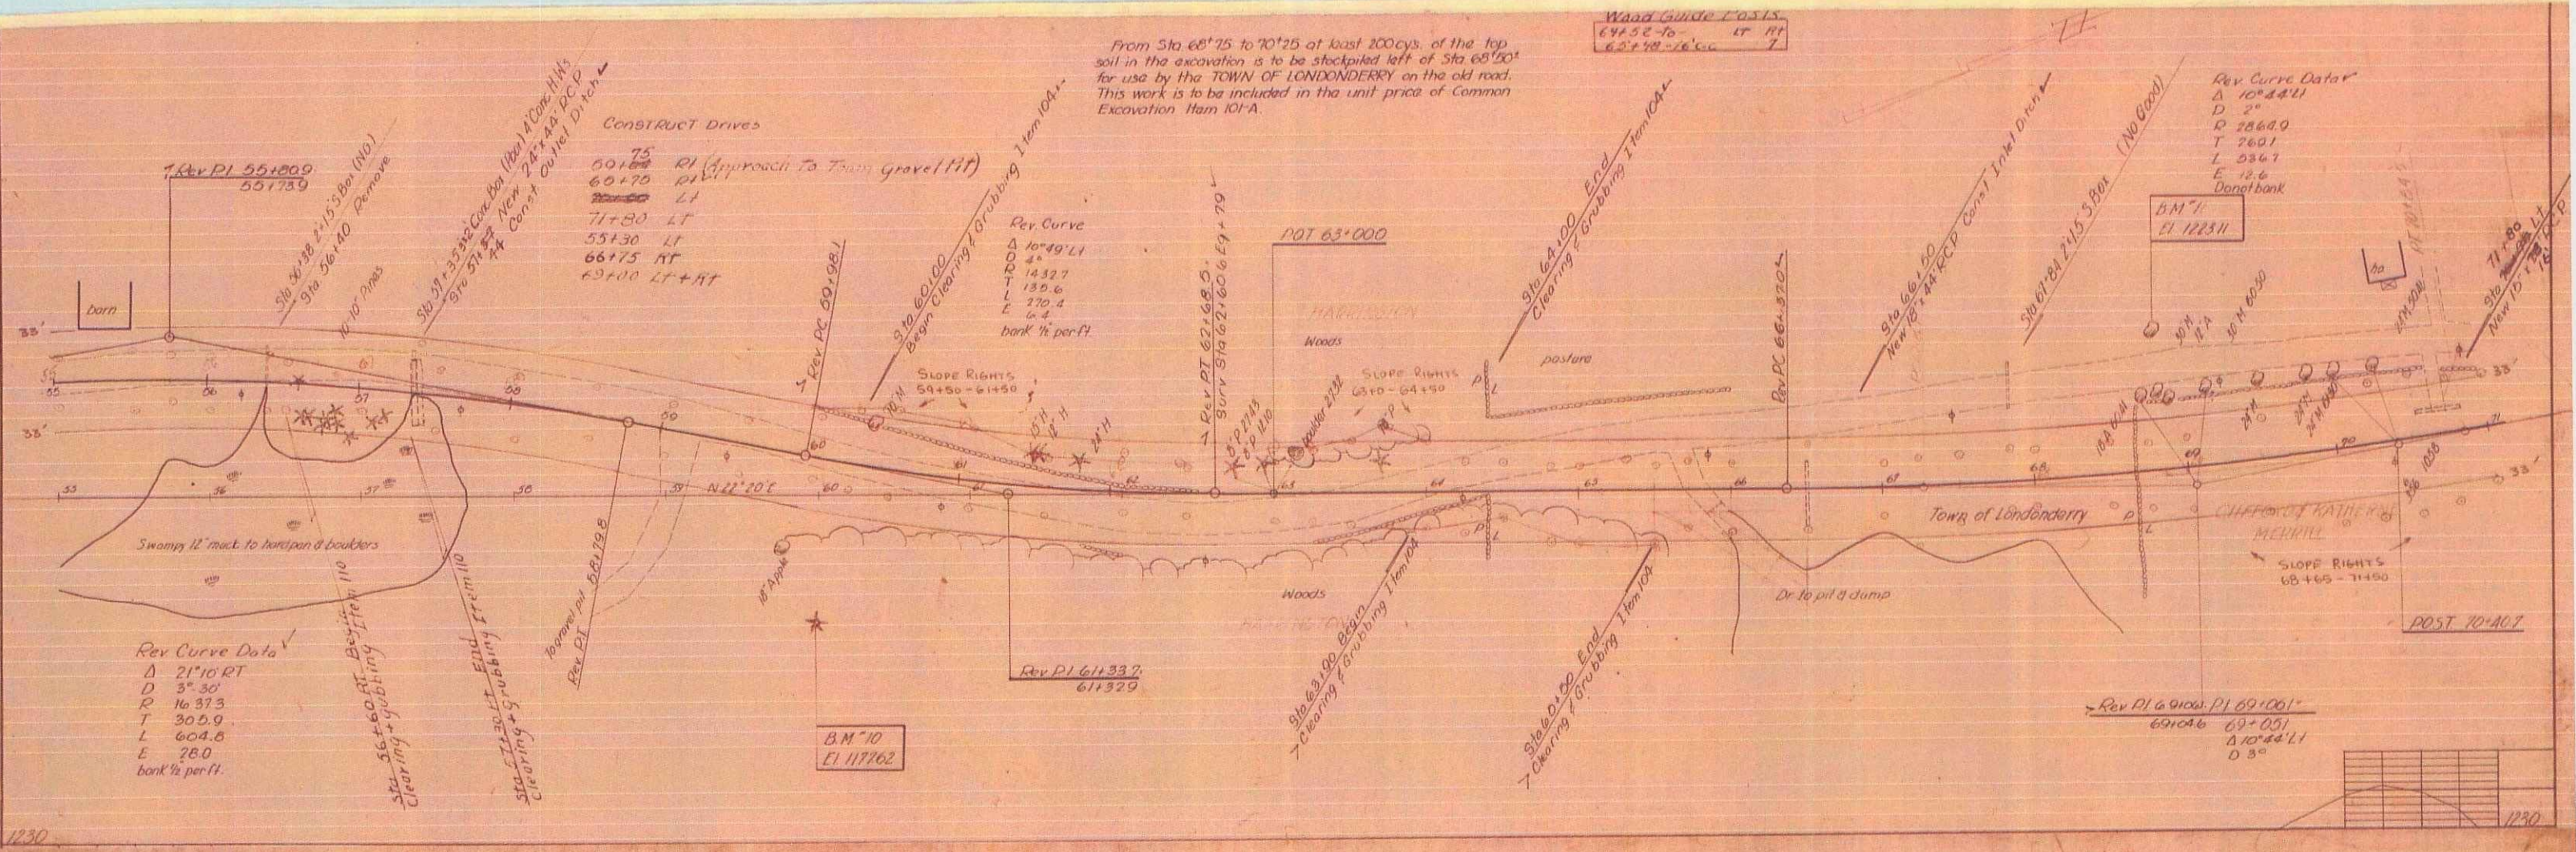

LONDONDERRY
PROJECT S 242 (R) 1982
SHEET 4 OF 5