9

Treated Timber Curb
Item 533
Sta 15+00 ~ 16+50 Lt

Thrie Cable Guard Rail
w/Tr. Steel Posts
Item 533
Sta 15+00 ~ 16+50 Lt.

Construct Dones
Sta 17+05 Lt
Sta 18+50 Lt.

Curve #2
L 6.5' Lt
D 3°00'
R 1902.3'
T 10.2'
L 21.9'
E 0.2'
Crs. 5% per foot

Light Stone Fill
Item 512
Sta 15+00 ~ 15+75 Rt.

Construct Approach
Sta 17+20 Rt.

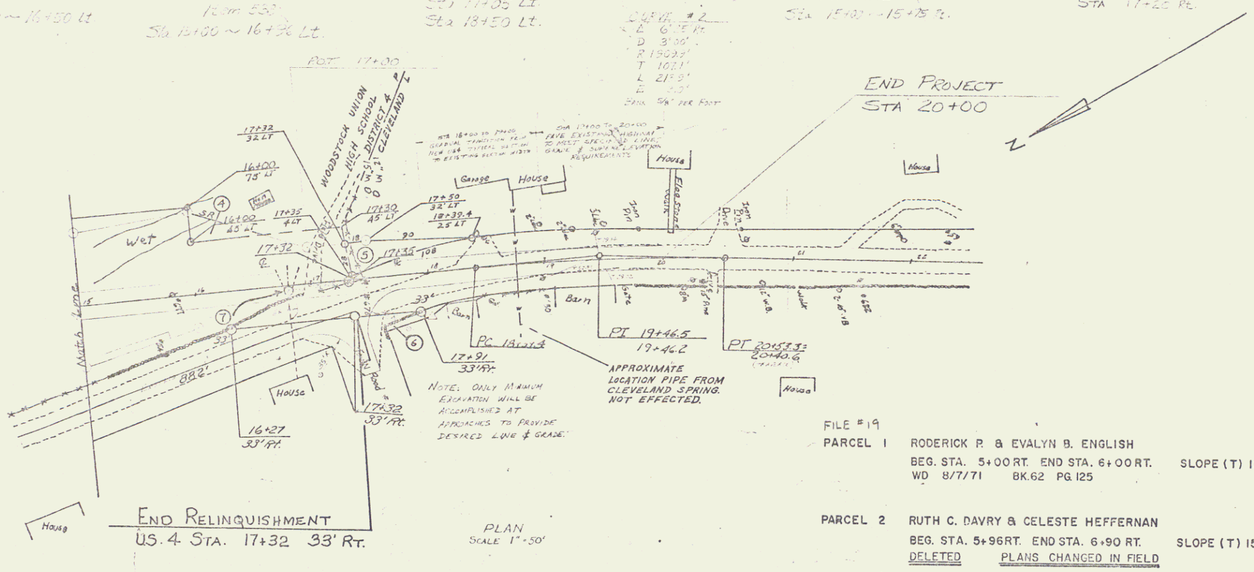

PLAN
Scale 1" = 50'

FILE #19
PARCEL 1 RODERICK P. & EVALYN B. ENGLISH
BEG. STA. 5+00 RT. END STA. 6+00 RT. SLOPE (T) 1200 S.F.±
WD 8/7/71 BK.62 PG.125

PARCEL 2 RUTH C. DAVRY & CELESTE HEFFERNAN
BEG. STA. 5+96 RT. END STA. 6+90 RT. SLOPE (T) 1500 S.F.±
DELETED PLANS CHANGED IN FIELD

FILE #20
PARCEL 3 FREEMAN E. & RUTH G. CAMPBELL
BEG. STA. 5+20 LT. END STA. 5+65 LT.
CULVERT & DRAINAGE (P)
WD 2/10/71 BK.60 PG.407

FILE #19a
PARCEL 4 WOODSTOCK UNION HIGH SCHOOL DISTRICT NO. 4
BEG STA. 16+00 LT END STA. 16+65 LT. SLOPE (T) 800 S.F.±
WD 12/2/71 BK.62 PG. 217

FILE #21
PARCEL 5 GUY H. & EVELYN H. CLEVELAND
BEG. STA. 17+32 LT. END STA. 18+39.4 LT.
TAKE 1500 S.F.± REM. 1.3 ACRES±
WD 3/3/71 BK.60 PG. 415

PARCEL 6 HOWARD G. NICHOLS
BEG. STA. 17+60 RT. END STA. 18+15 RT. SLOPE 400 S.F.± (T)
DELETED PLANS CHANGED IN FIELD

FILE #22
PARCEL 7 WILLIAM BEEBE
16+78 RT. SEPTIC TANK & DRY WELL
REMOVAL BY AGREEMENT
AGREEMENT 8/24/71 BK. 62 PG. 151

PLAN
SURVEY NOTES
PLOTTED
DESIGNED
CHECKED
NOTE BOOK
NO.

PROFILE
SURVEY NOTES
PLOTTED
DESIGNED
CHECKED
NOTE BOOK
NO.

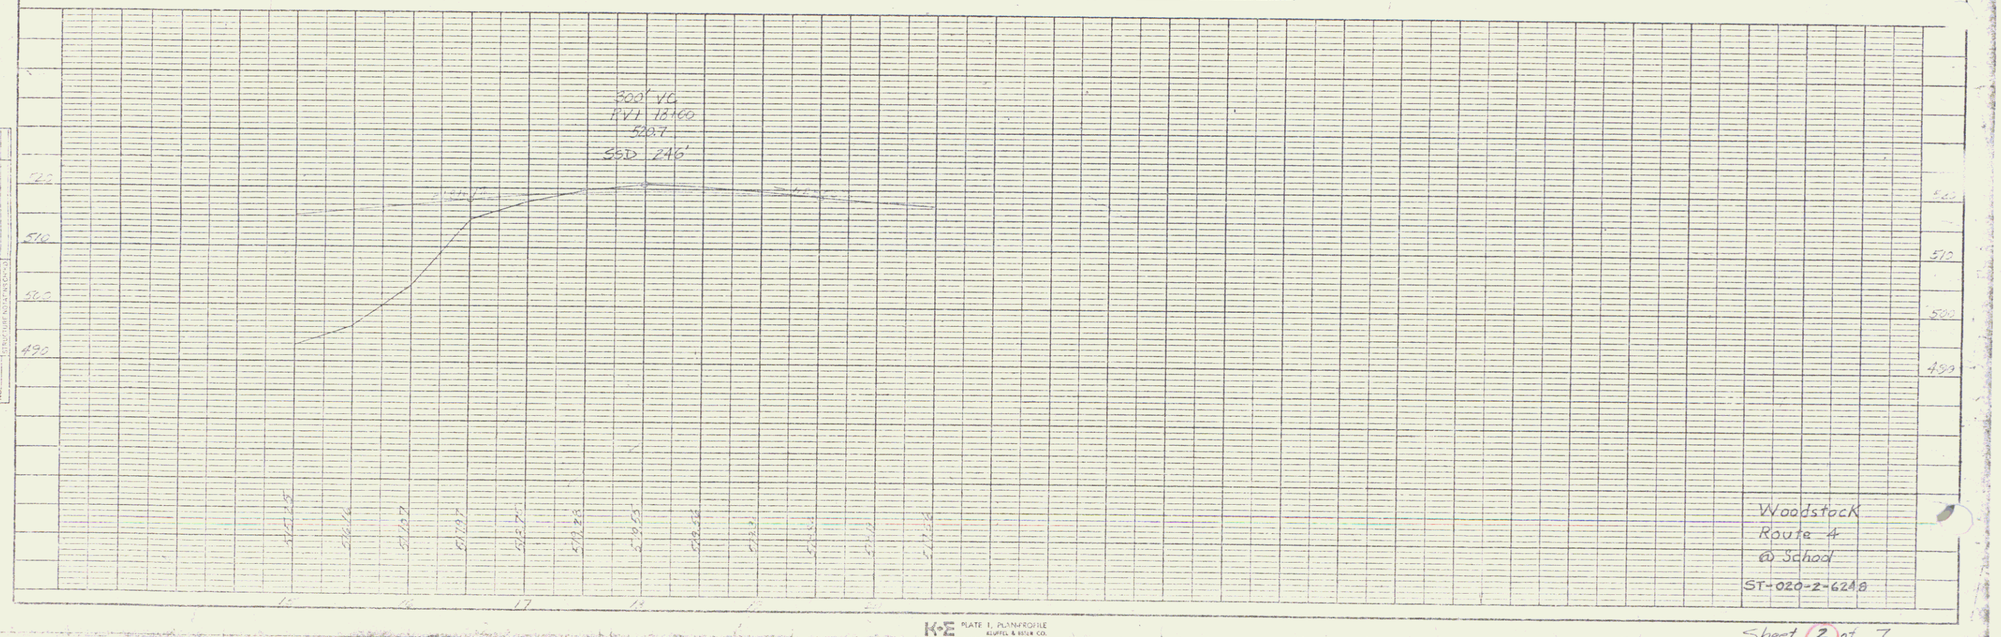

K+E PLATE 1, PLAN-PROFILE KEUFFEL & ESSER CO.

Sheet 2 of 7

5