FED. ROAD DIST. NO.	STATE	FED. AID PROJ. NO.	FISCAL YEAR	SHEET NO.	TOTAL SHEETS
		109 (10)	1941	3	75

Δ 0°42' Lt.
D 0°30'
R 11459.2
T 70.0
L 140.0
E 0.2
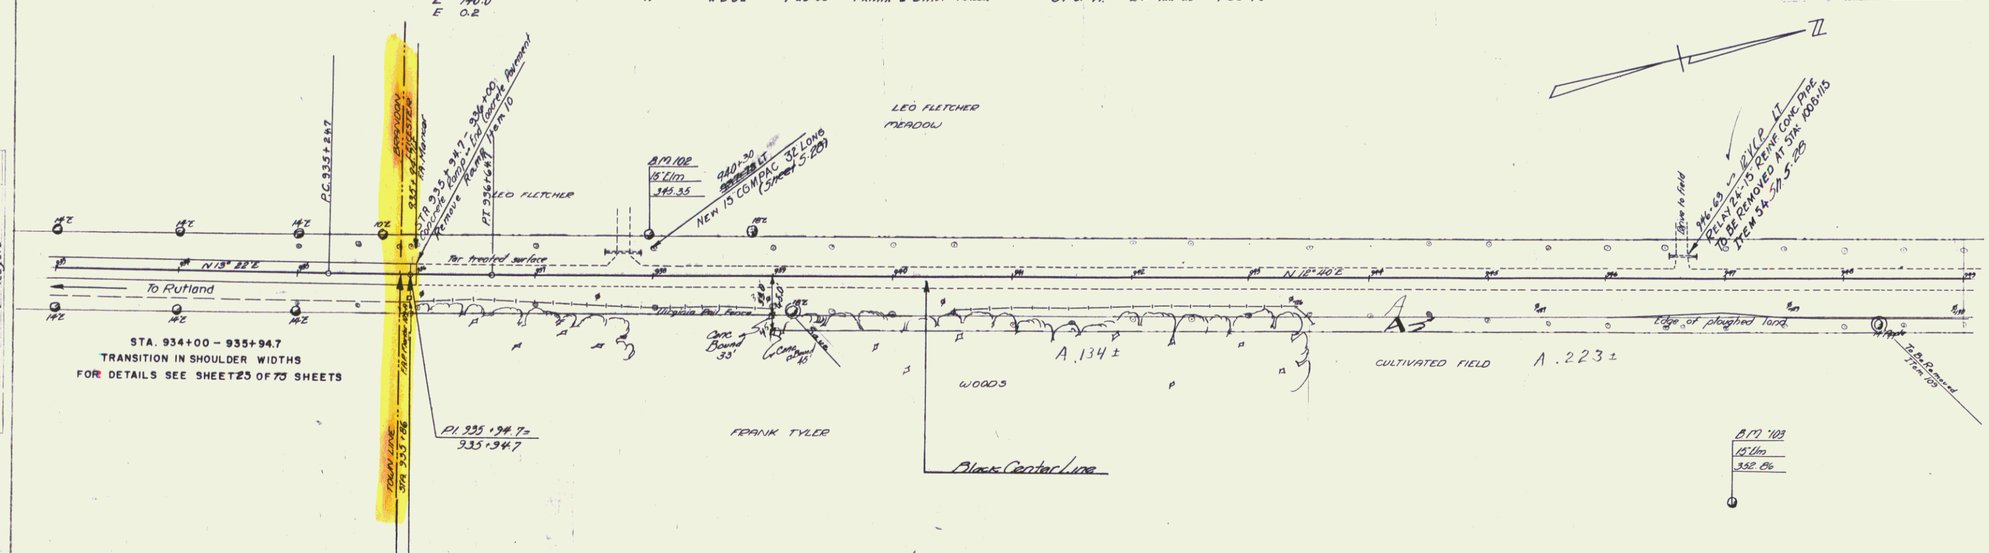
PARCEL	INSTRUMENT	DATE	GRANTOR	GRANTEE	RECORDED BOOK	PAGE	DATE	REMARKS
A	W D O E	7-23-40	FRANK & DAISY TYLER	ST OF VT.	LEICESTER 26	122-23	7-30-40