FED. ROAD DIST. NO.	STATE	FED. AID PROJ. NO.	FISCAL YEAR	SHEET NO.	TOTAL SHEETS
11	VT.	109 (11)	1941	7	75

PARCEL	INSTRUMENT	DATE	GRANTOR	GRANTEE	RECORDED BOOK	RECORDED PAGE	RECORDED DATE	REMARKS
C	W.D.O.E.	7-23-40	FRANK & DAISY TYLER	ST OF VT	24	122-25	7-30-40	1 CULV.
A, B	W.D.O.E.	7-23-40	HOLT & RUBY PEABODY	ST OF VT	24	126-29	7-30-40	1 CULV.

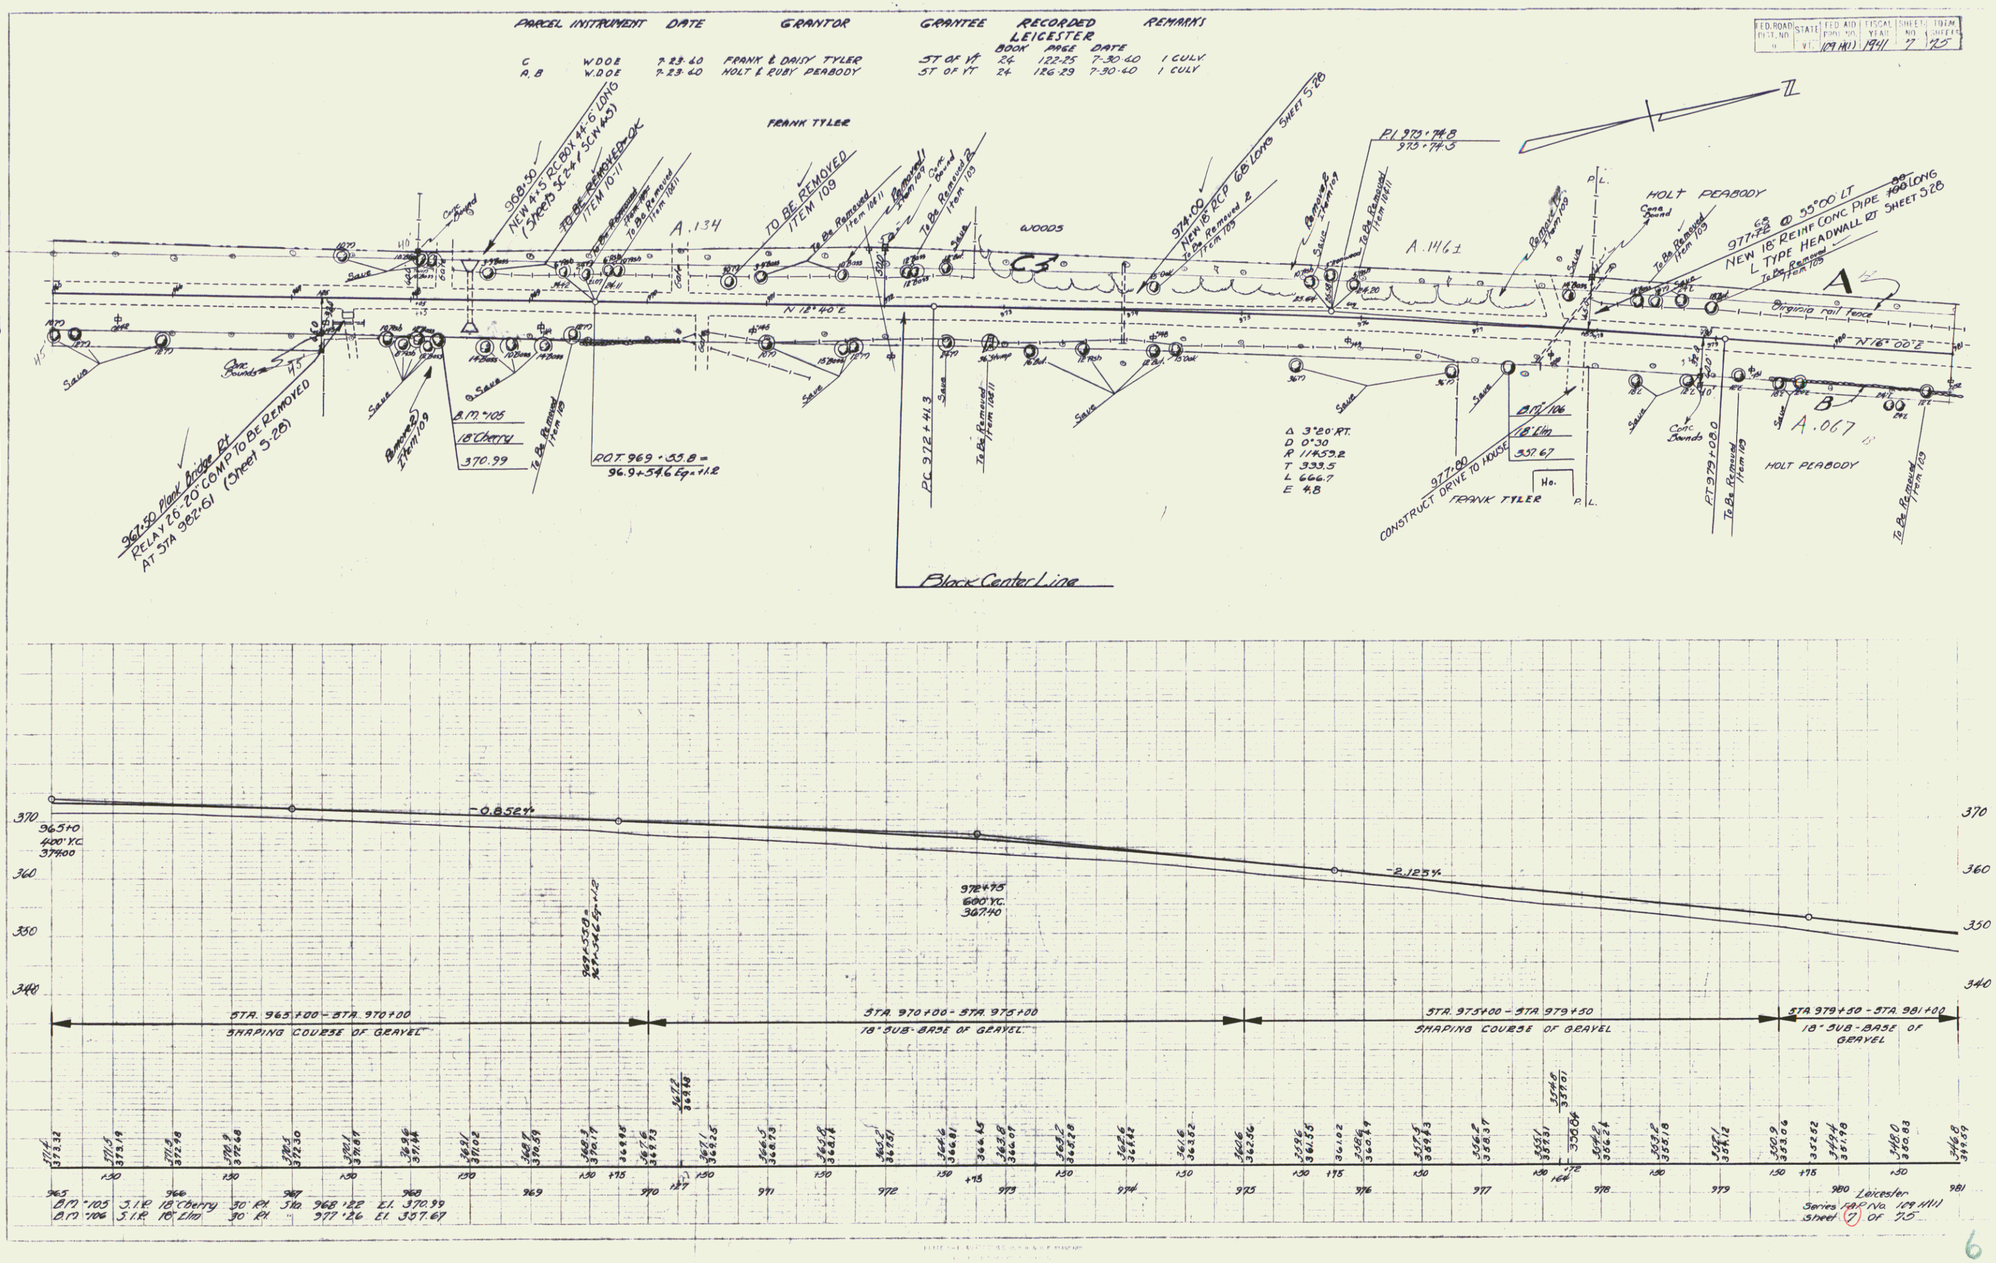

6