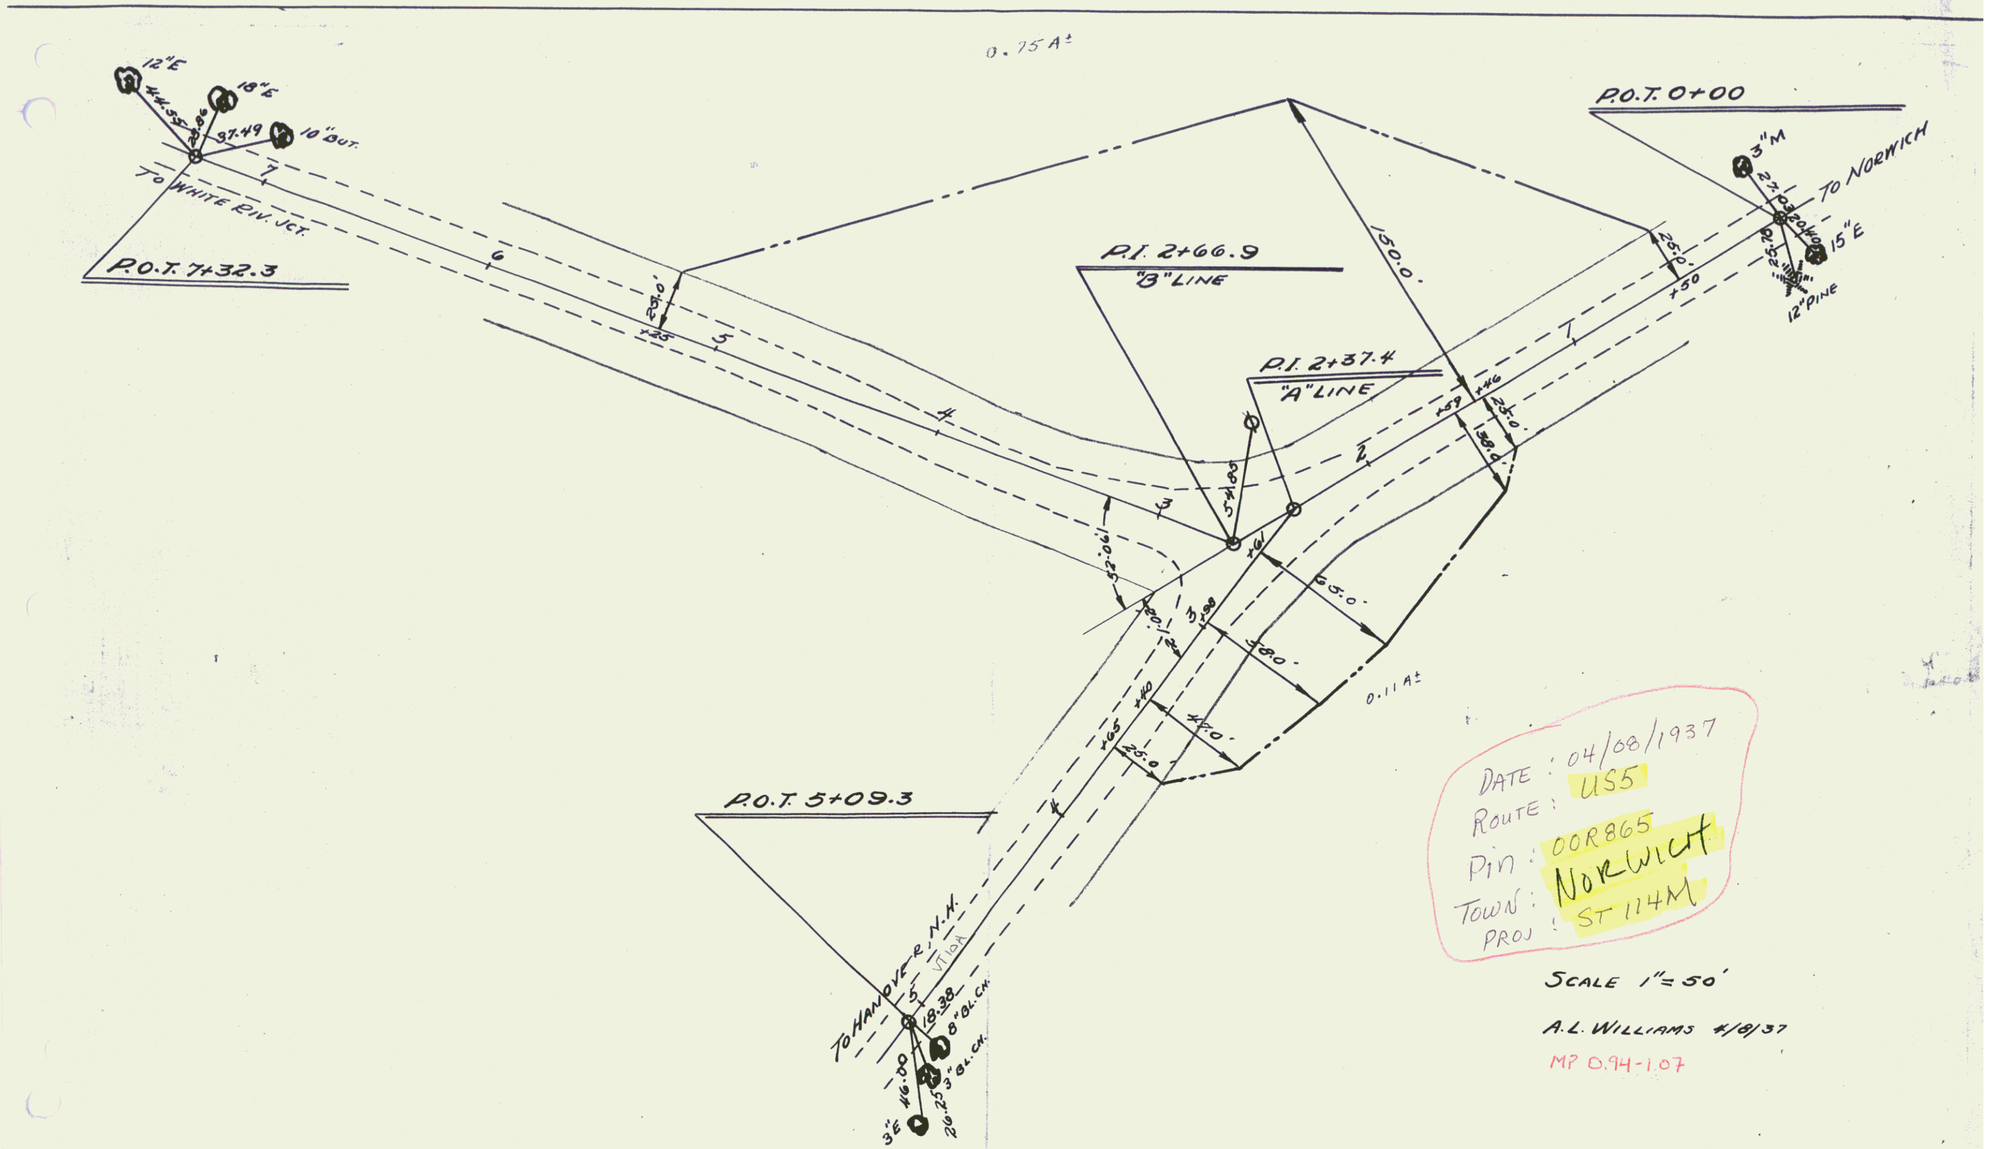

DATE : 04/08/1937
ROUTE : US5
PIN : 00R865
TOWN : NORWICH
PROJ : ST 114M

SCALE 1" = 50'

A.L. WILLIAMS 4/8/37

MP 0.94-1.07

SHEET 1