

North end of Wells River Village



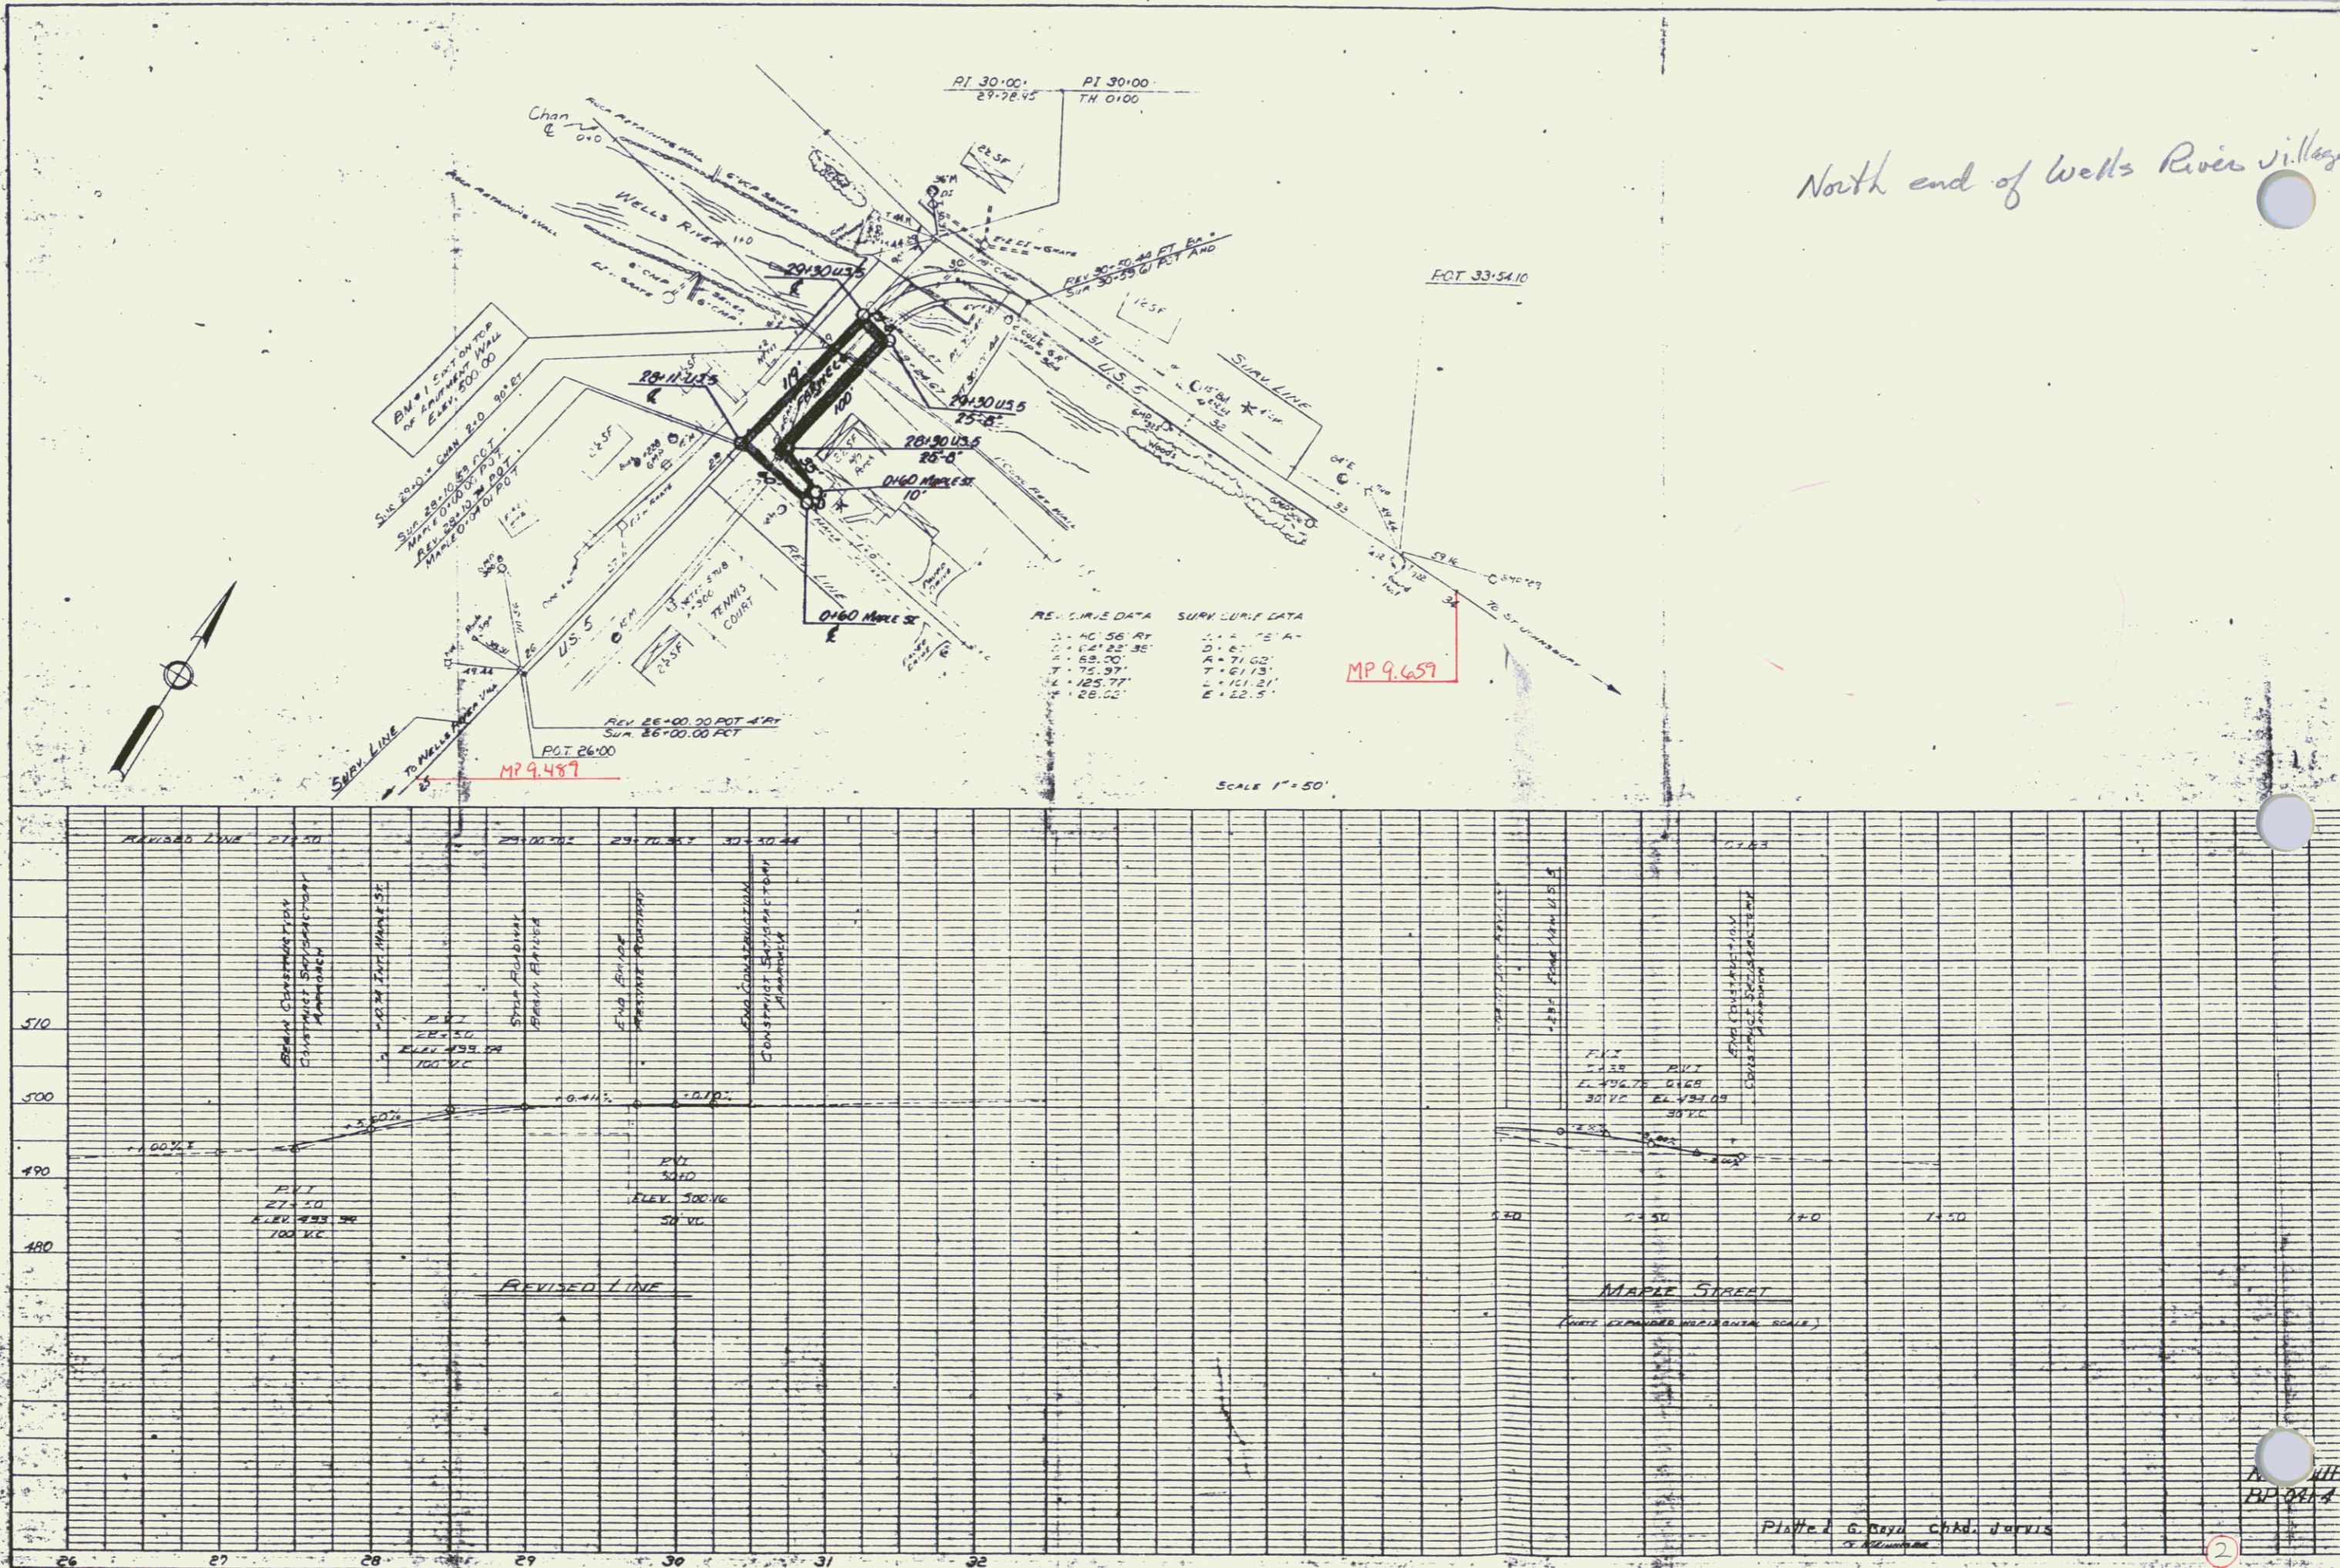


Plate 6. Bayu Chkd. Jarvis