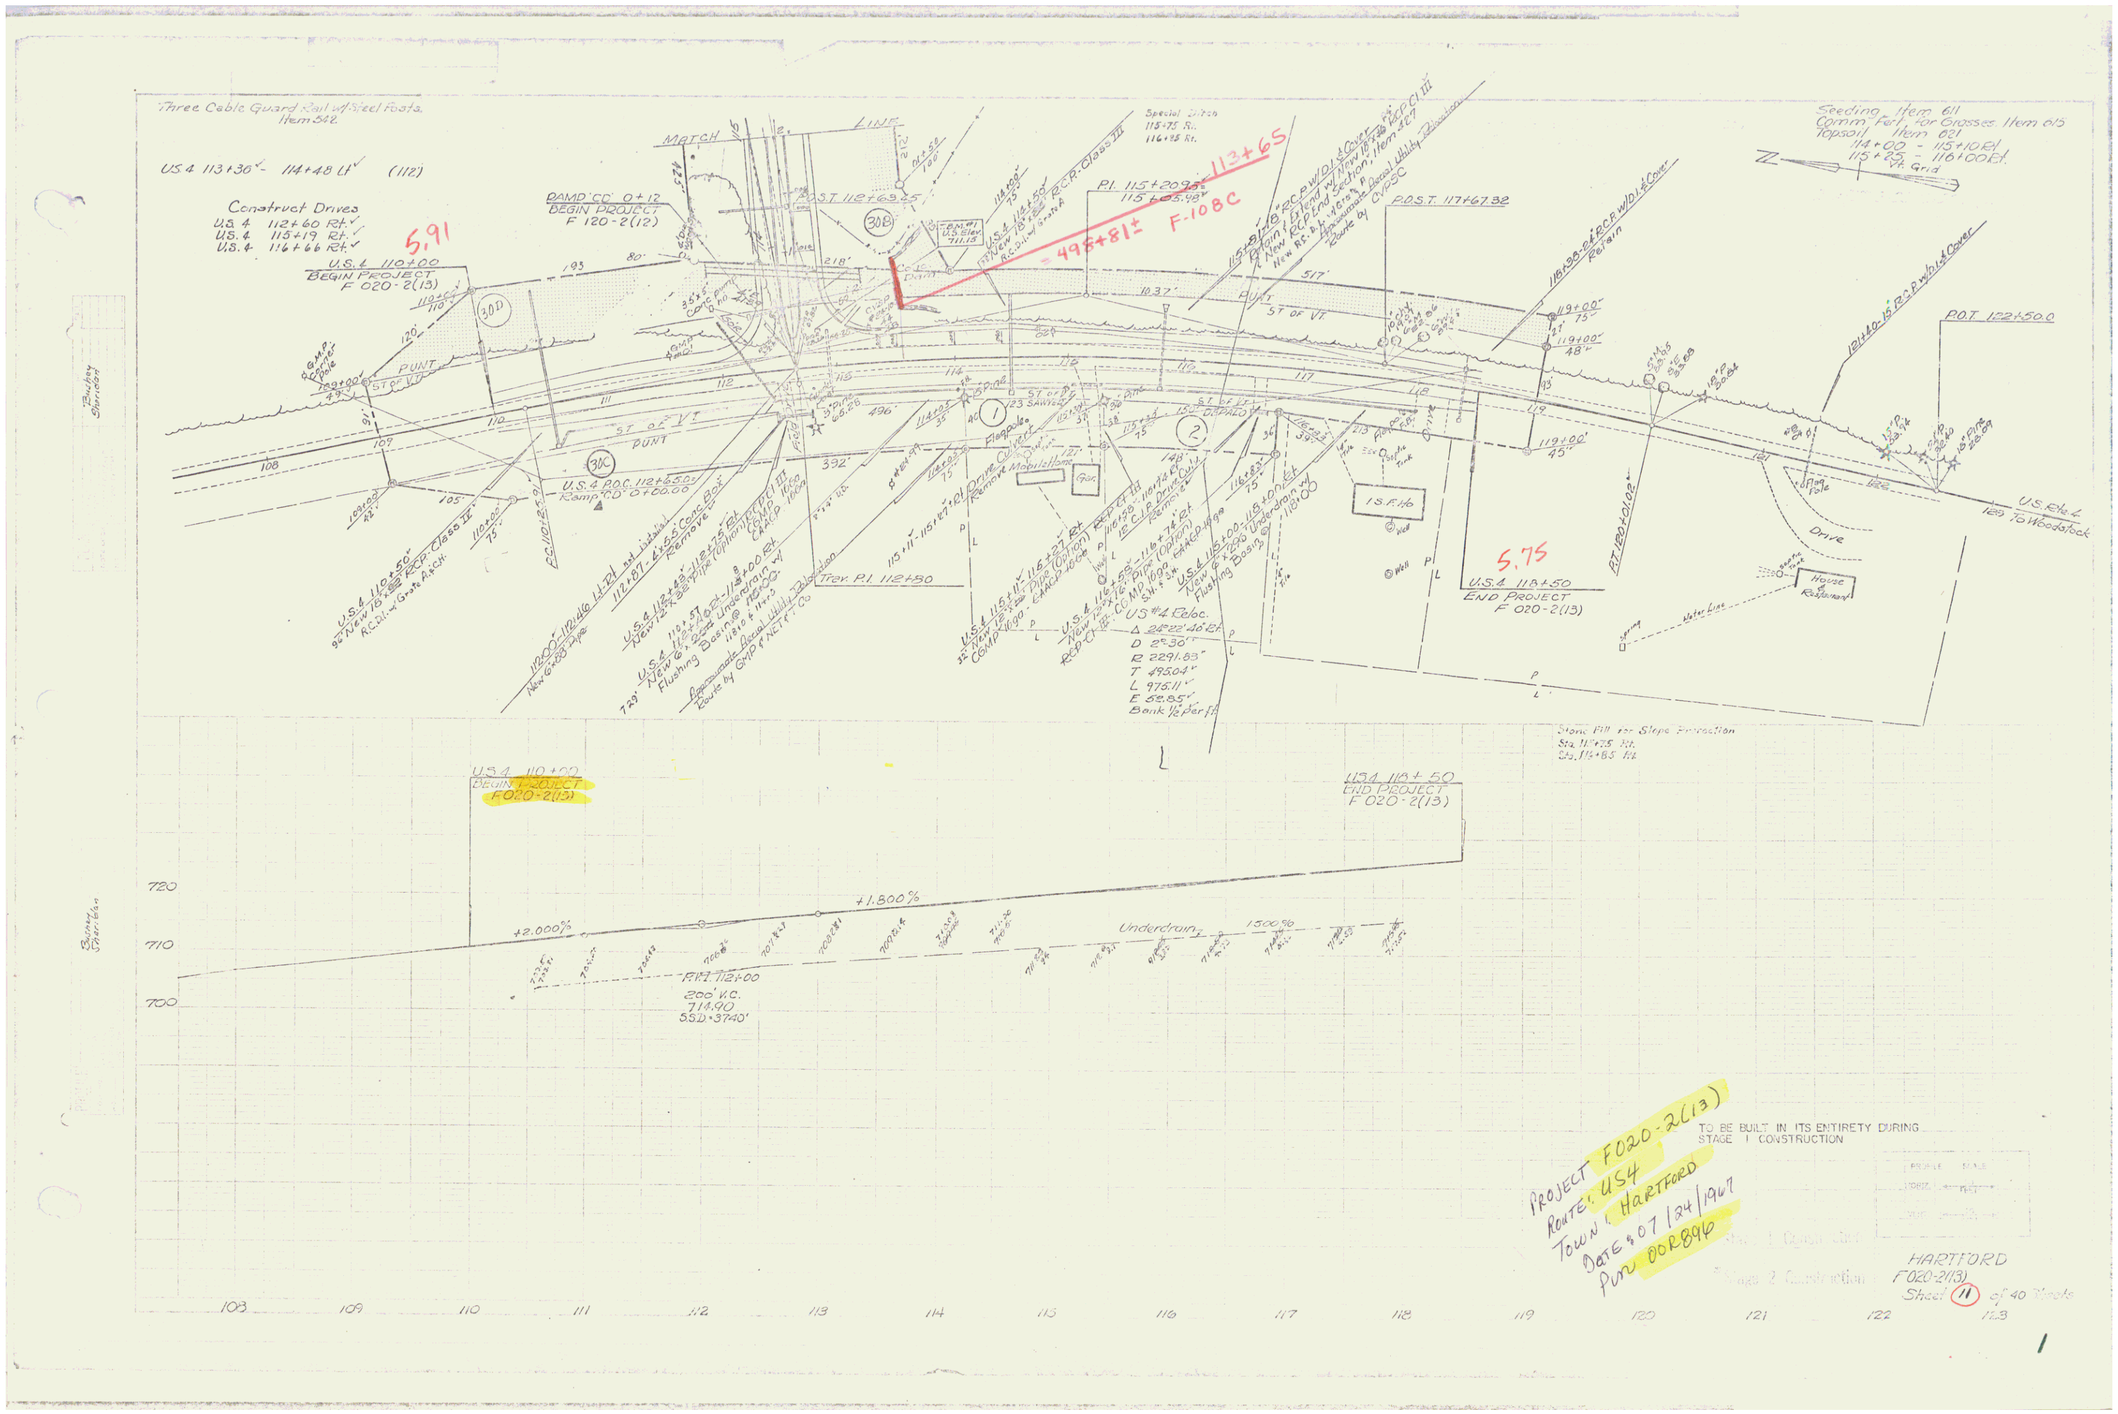
Three Cable Guard Rail w/ Steel Posts Item 542
U.S. 4 113+30 - 114+48 Lt. (112)
Construct Drives
U.S. 4 112+60 Rt.
U.S. 4 115+19 Rt.
U.S. 4 116+66 Rt.
5.91
U.S. 4 110+00
BEGIN PROJECT
F 020-2(13)
RAMP "CC" 0+12
BEGIN PROJECT
F 120-2(12)
MATCH LINE
P.I. 115+20.98
113+65
495+81±
F-108C
P.O.S.T. 117+67.32
P.O.T. 122+50.0
Seeding Item 611
Comm. Fert. for Grasses Item 615
Topsoil Item 651
114+00 - 115+10 Rt.
115+25 - 116+00 Rt.
Vt. Grid
U.S. 4 Rte. 4
120 To Woodstock
5.75
U.S. 4 118+50
END PROJECT
F 020-2(13)
U.S. 4 Reloc.
Δ 28°22'46" Rt.
D 2°30'
R 2291.83'
T 495.04'
L 975.11'
E 52.85'
Bank 1/2" Per Ft.
Drive
Stone Fill for Slope Protection
Sta. 114+35 Rt.
Sta. 115+85 Rt.
U.S. 4 110+00
BEGIN PROJECT
F 020-2(13)
U.S. 4 118+50
END PROJECT
F 020-2(13)
+2.000%
+1.800%
Underdrain
1.500%
P.I. 112+00
200' V.C.
714.90
SSD=374.0'
720
710
700
TO BE BUILT IN ITS ENTIRETY DURING
STAGE 1 CONSTRUCTION
PROJECT F020-2(13)
ROUTE: U.S. 4
TOWN: HARTFORD
DATE: 07/24/1967
PIN 008896
HARTFORD
F020-2(13)
Sheet 11 of 40 Sheets
108
109
110
111
112
113
114
115
116
117
118
119
120
121
122
123