TYPICAL SECTIONS

3" BITUMINOUS CONCRETE PAVEMENT, ITEM 406.25

24" SUB-BASE OF GRAVEL, ITEM 301.15

CONSTRUCTED AS DESIGNED

PAVED SHOULDER DETAIL

SEE STANDARD SHEET C-1
FOR DETAILS OF TREATED TIMBER CURB WITH GUARD RAIL

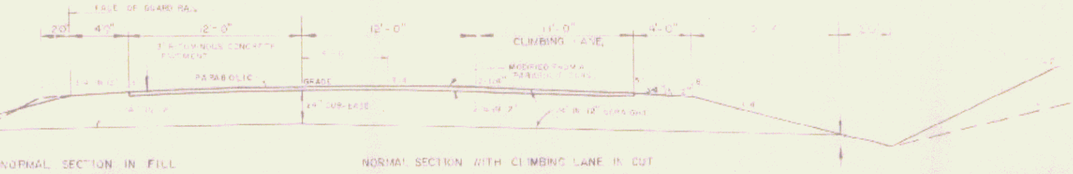

NORMAL SECTION IN FILL

NORMAL SECTION WITH CLIMBING LANE IN CUT

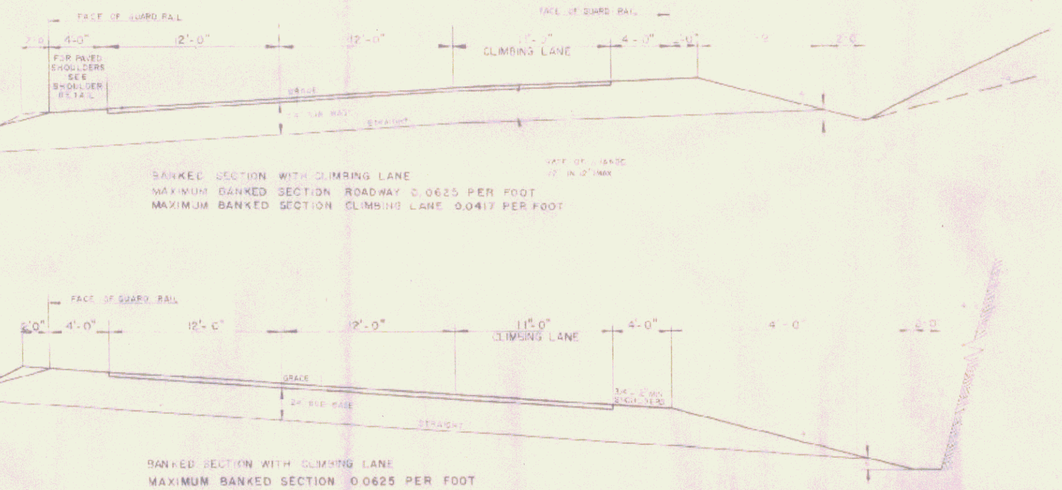

BANKED SECTION WITH CLIMBING LANE
MAXIMUM BANKED SECTION ROADWAY 0.0625 PER FOOT
MAXIMUM BANKED SECTION CLIMBING LANE 0.0417 PER FOOT

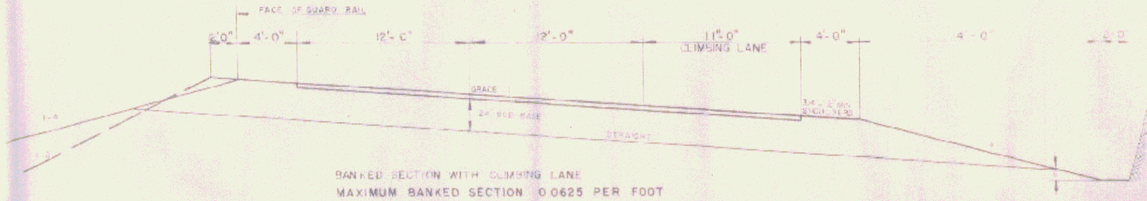

BANKED SECTION WITH CLIMBING LANE
MAXIMUM BANKED SECTION 0.0625 PER FOOT

(SEE STANDARD SHEET A-61 FOR ADDITIONAL DETAILS)

GENERAL NOTES

SEED, ITEM 659.10

MARKER POSTS, [illegible]

FERTILIZER, ITEM 651.5

AGRICULTURAL LIMESTONE, ITEM 651.20

HAY MULCH, ITEM 651.25

SEE STANDARD SHEET B-5

ALLOWABLE TOLERANCES

SEE STANDARD SHEET [illegible] FOR HAY LIMITS OF SAND BORROW WHEN USED IN CONJUNCTION WITH UNDERDRAIN

TOWN OF MARSHFIELD

STATE OF VERMONT
DEPARTMENT OF HIGHWAYS

SURVEYED BY SMITH-CREST DATE 1971
DRAWN BY S. MURRAY DATE 7-77
TRACED BY S. MURRAY DATE 8-78

PROJ. BP 025-3-78(6)
RMA 6218

SHEET 2 OF 28

2