POOR ORIGINAL COPY

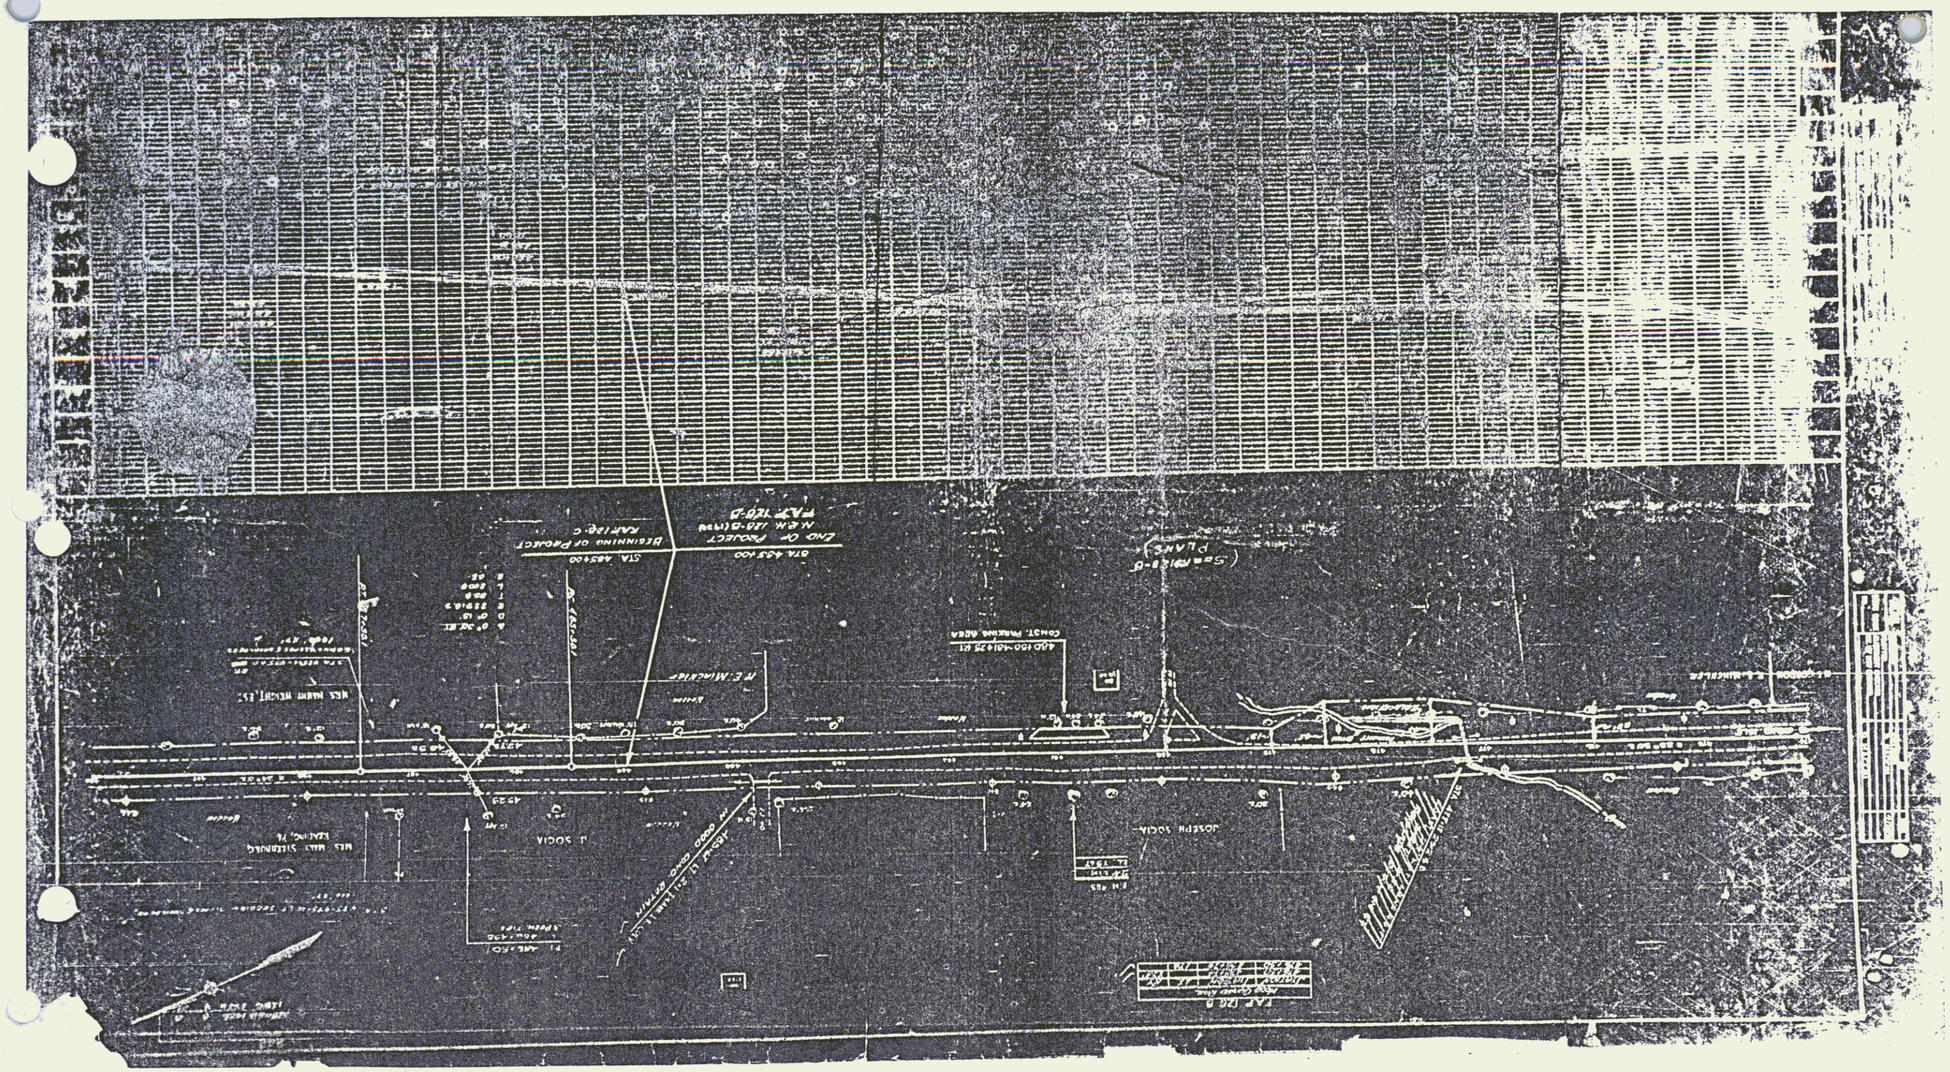

POOR ORIGINAL COPY