POOR ORIGINAL COPY

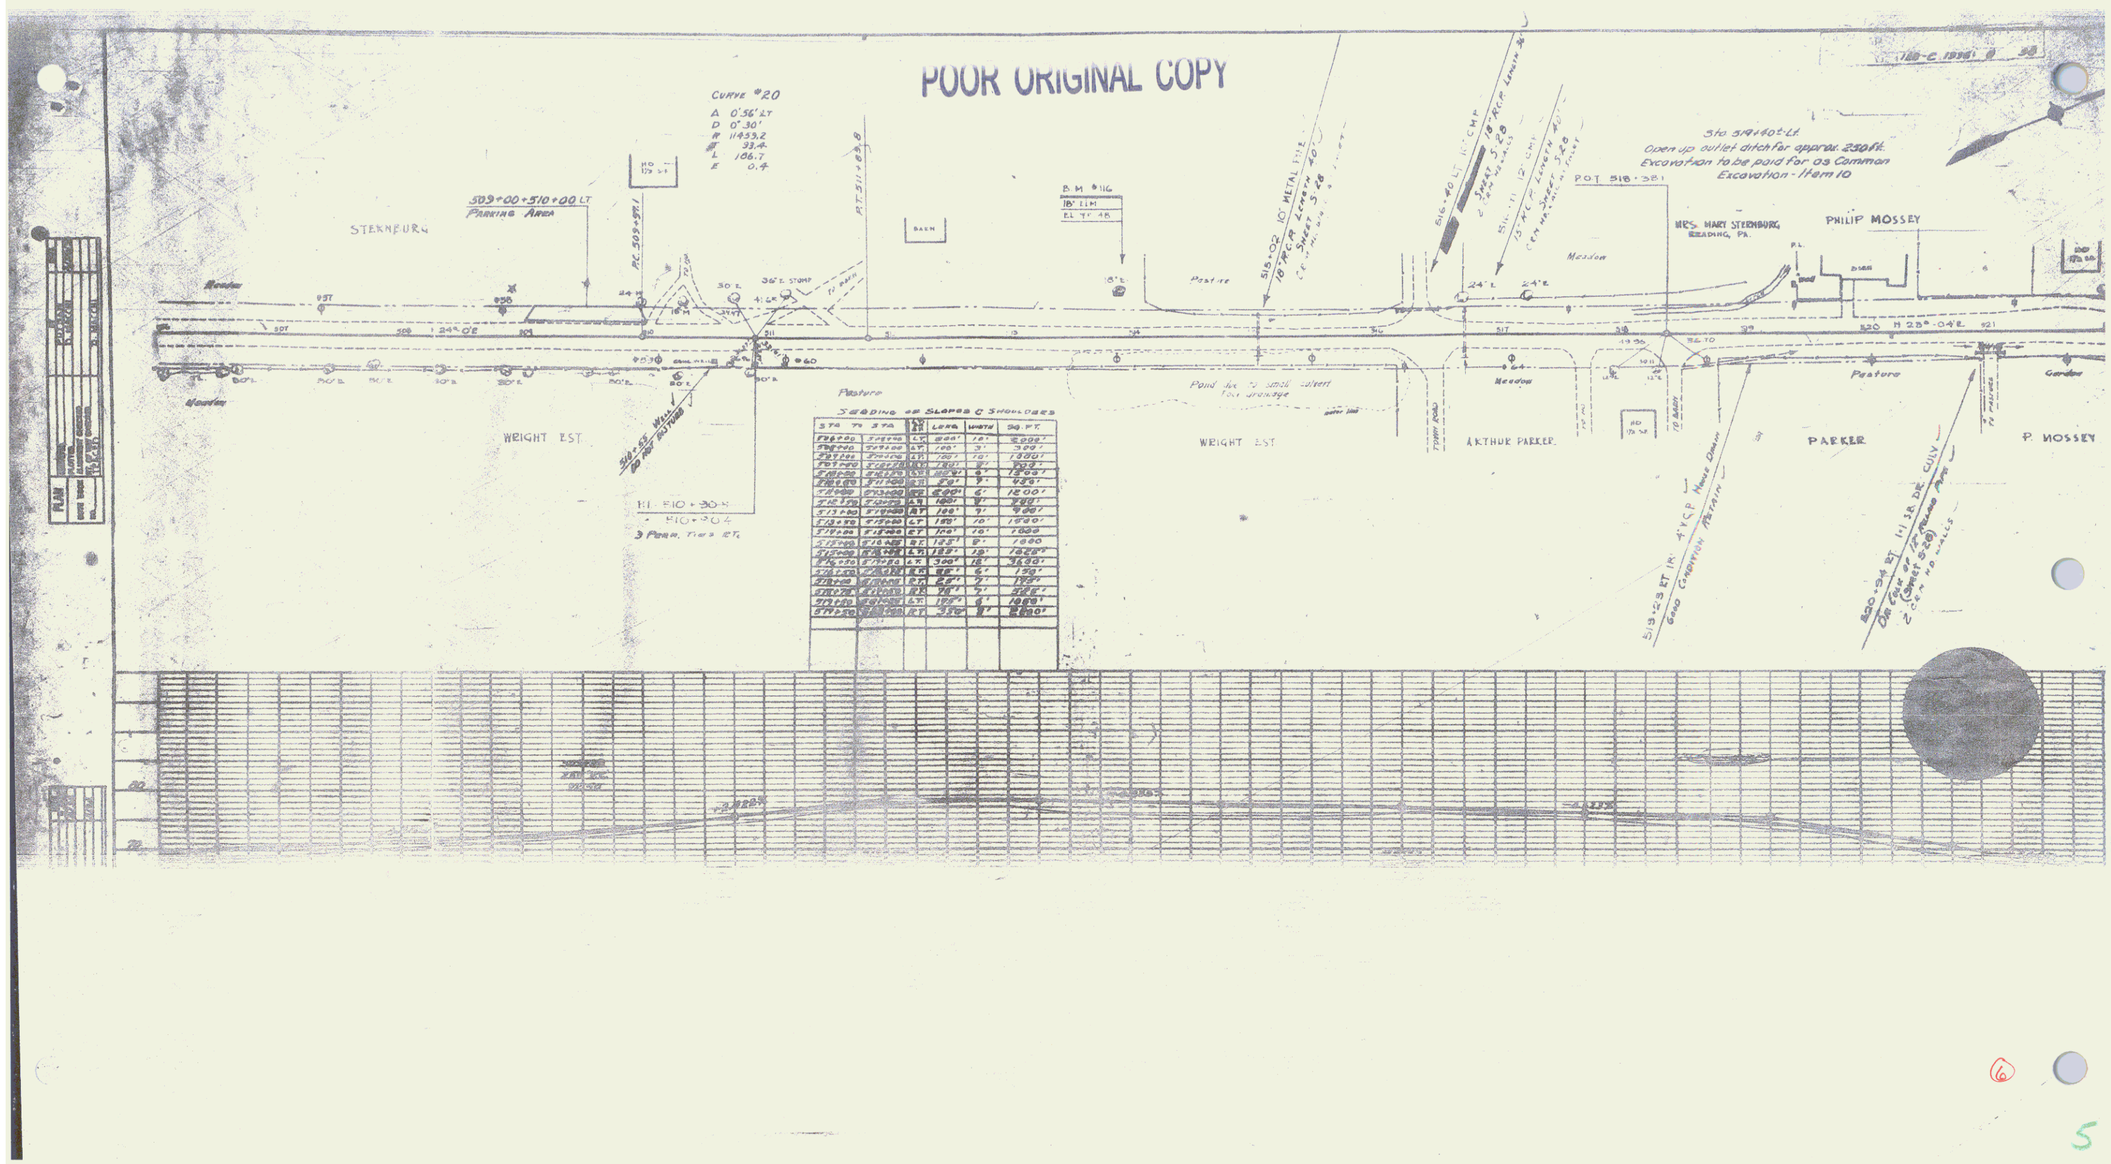

STA	TO STA	SIDE	LENG.	WIDTH	SQ. FT.
