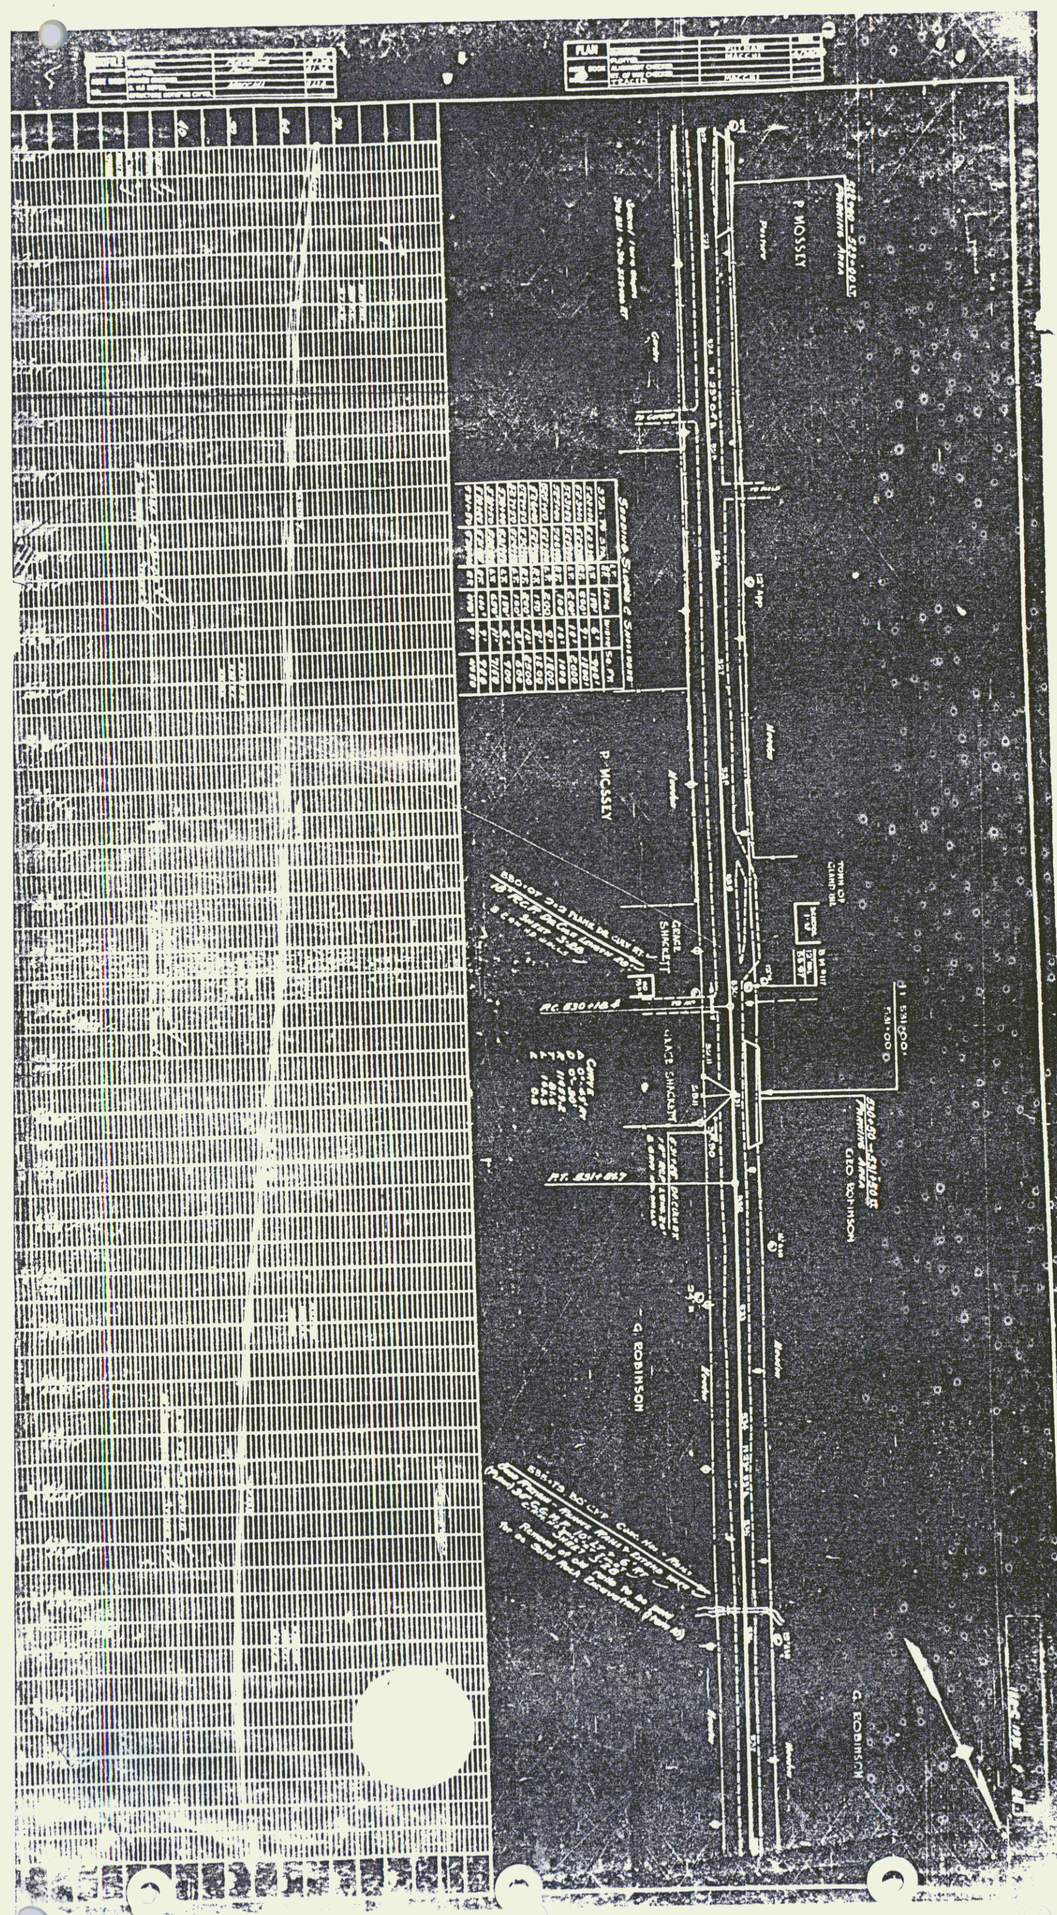
PLAN
P. MOSSLY
G. ROBINSON
GEORGE SINCLAIR
GRACE SINCLAIR
P. MCSSLY
G. ROBINSON
G. ROBINSON
R.C. 630+16.4
P.T. 631+87.7
630+00 - 631+00
PARKING AREA
G. ROBINSON
TOWN OF CLAND INC.
FM 1000
BM 1
BM 2
7A

7