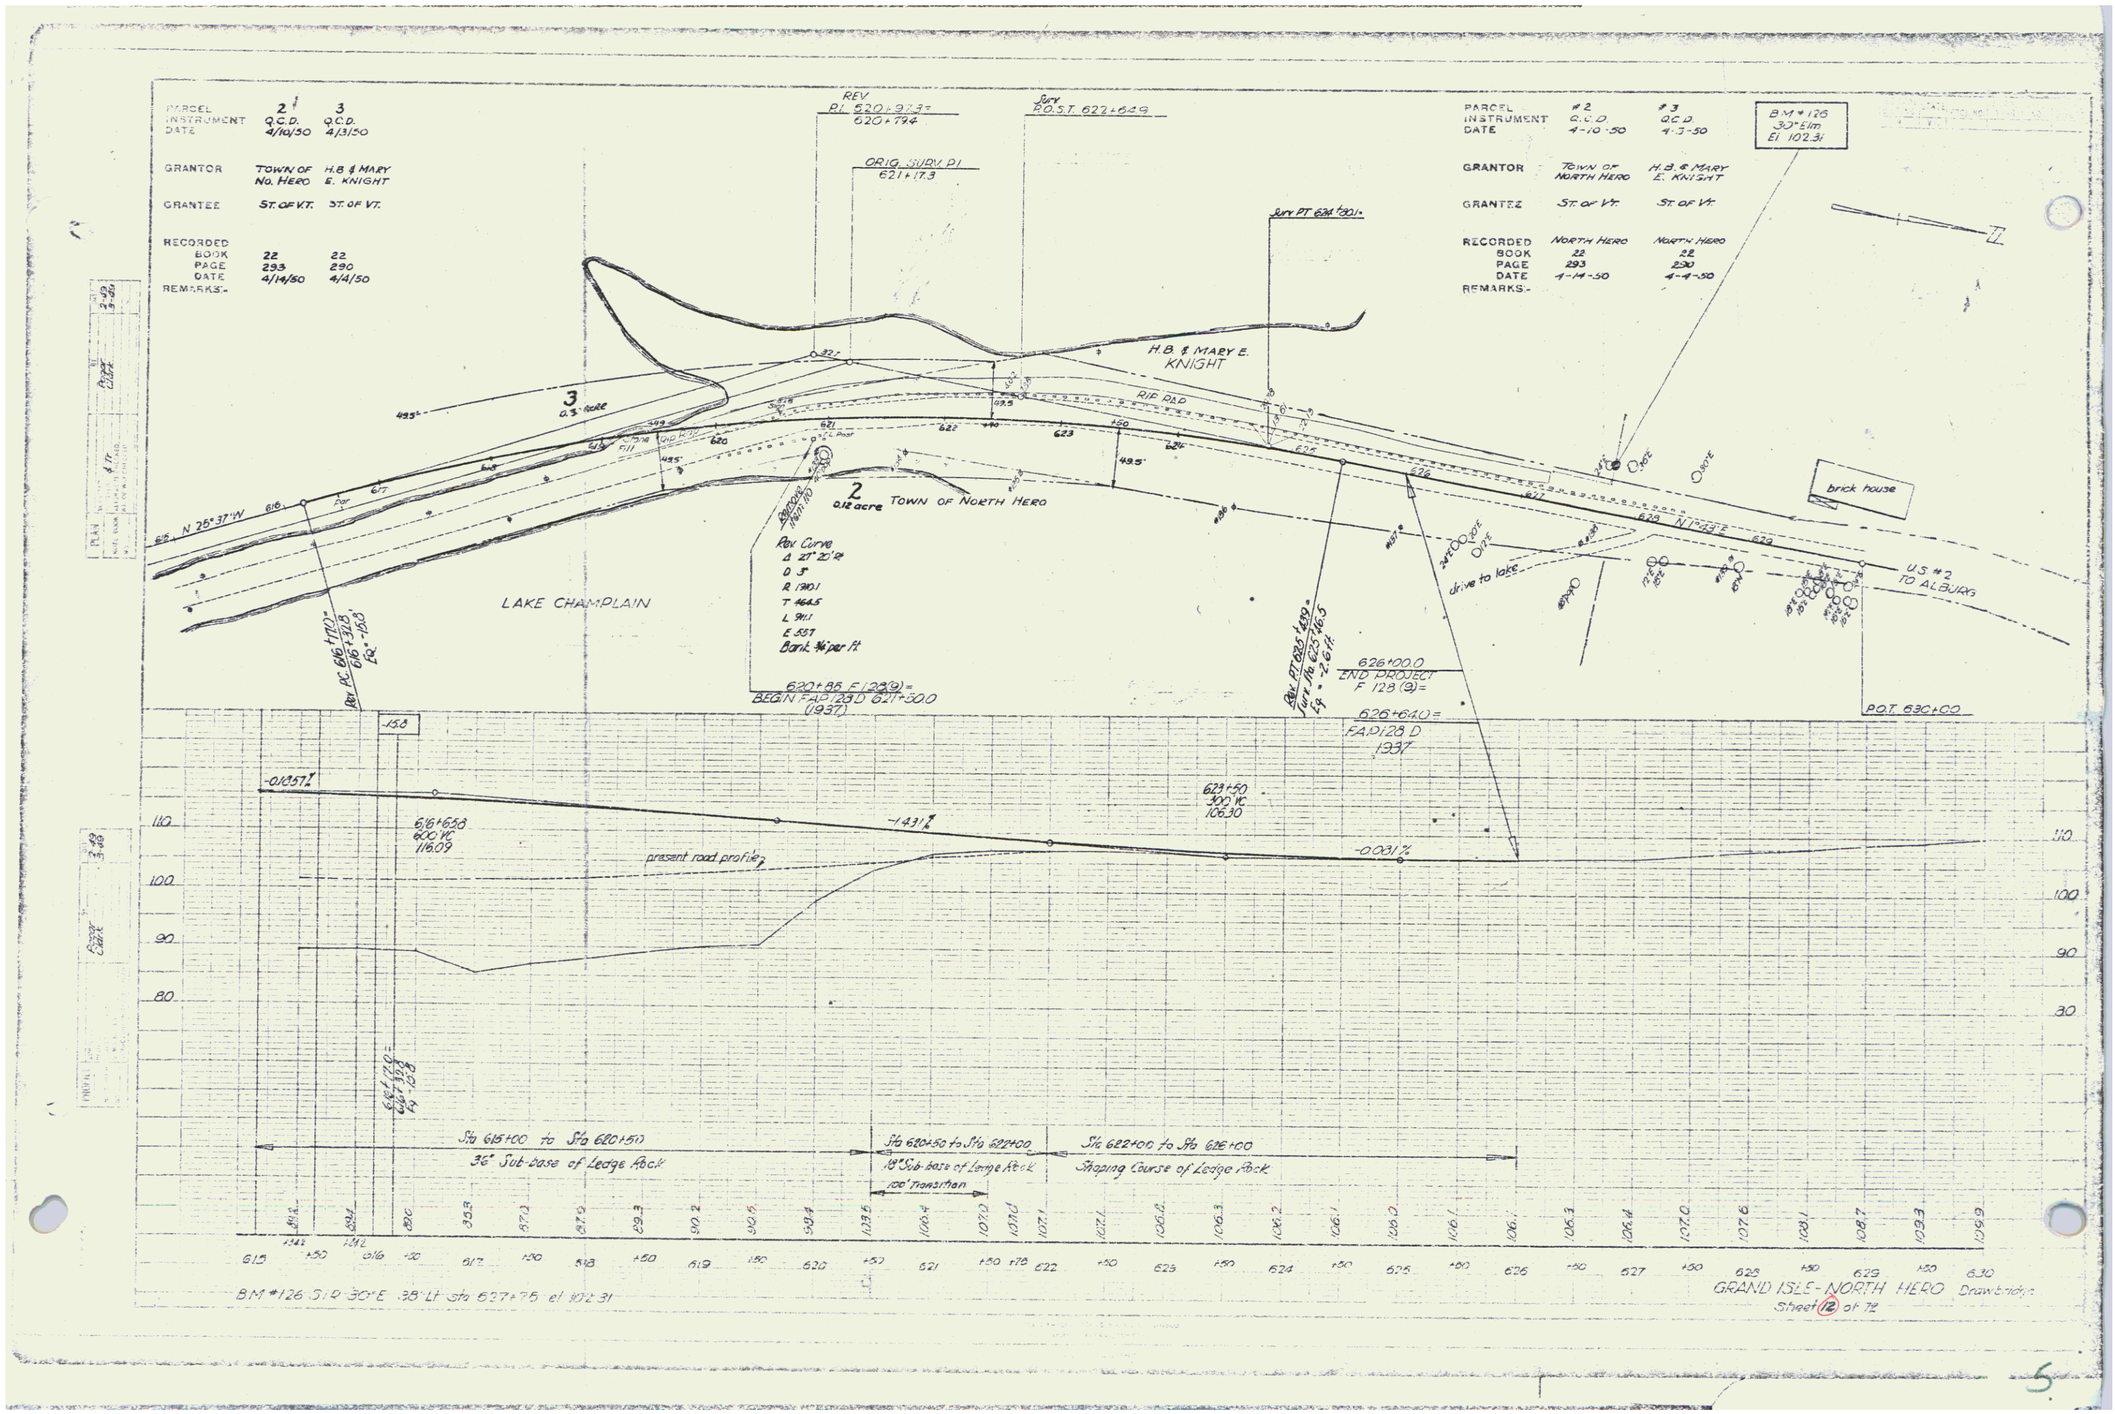
PARCEL 2 3
INSTRUMENT Q.C.D. Q.C.D.
DATE 4/10/50 4/3/50
GRANTOR TOWN OF No. HERO H.B. & MARY E. KNIGHT
GRANTEE ST. OF VT. ST. OF VT.
RECORDED
BOOK 22 22
PAGE 293 290
DATE 4/14/50 4/4/50
REMARKS:-
PARCEL #2 #3
INSTRUMENT Q.C.D. Q.C.D.
DATE 4-10-50 4-3-50
GRANTOR TOWN OF NORTH HERO H.B. & MARY E. KNIGHT
GRANTEE ST. OF VT. ST. OF VT.
RECORDED NORTH HERO NORTH HERO
BOOK 22 22
PAGE 293 290
DATE 4-14-50 4-4-50
REMARKS:-
B.M. #126 30" Elm El 102.31
REV P.I. 620+93.3= 620+79.4
Surv P.O.S.T. 622+64.9
ORIG. SURV. P.I. 621+17.3
Surv PT 624+30.1
H.B. & MARY E. KNIGHT
RIP RAP
3 0.3 acre
2 0.12 acre TOWN OF NORTH HERO
LAKE CHAMPLAIN
N 25°37' W
N 12°33' E
brick house
drive to lake
U.S. #2 TO ALBURG
Rev Curve
Δ 27°20'12"
D 5°
R 1910.1
T 466.5
L 911.1
E 55.1
Bank ¼" per ft
620+85.5 F 128(9)= BEGIN FAP 128 D 621+50.0 (1937)
626+00.0 END PROJECT F 128 (9)=
626+64.0 = FAP 128 D 1937
P.O.T. 630+00
-0.1857%
-1.431%
-0.0031%
616+65.8 600 VC 116.09
623+50 400 VC 106.30
present road profile
Sta 615+00 to Sta 620+50
36" Sub-base of Ledge Rock
Sta 620+50 to Sta 622+00
18" Sub-base of Large Rock
100' Transition
Sta 622+00 to Sta 626+00
Shaping Course of Ledge Rock
B.M. #126 S12 30" E 38' Lt Sta 627+78 el 102.31
GRAND ISLE - NORTH HERO Drawbridge
Sheet 12 of 72