FED. AID PROJ. NO.	STATE	COUNTY	TOTAL SHEETS	SHEET NO.
DST. 6	S	128-D	1937	12	65

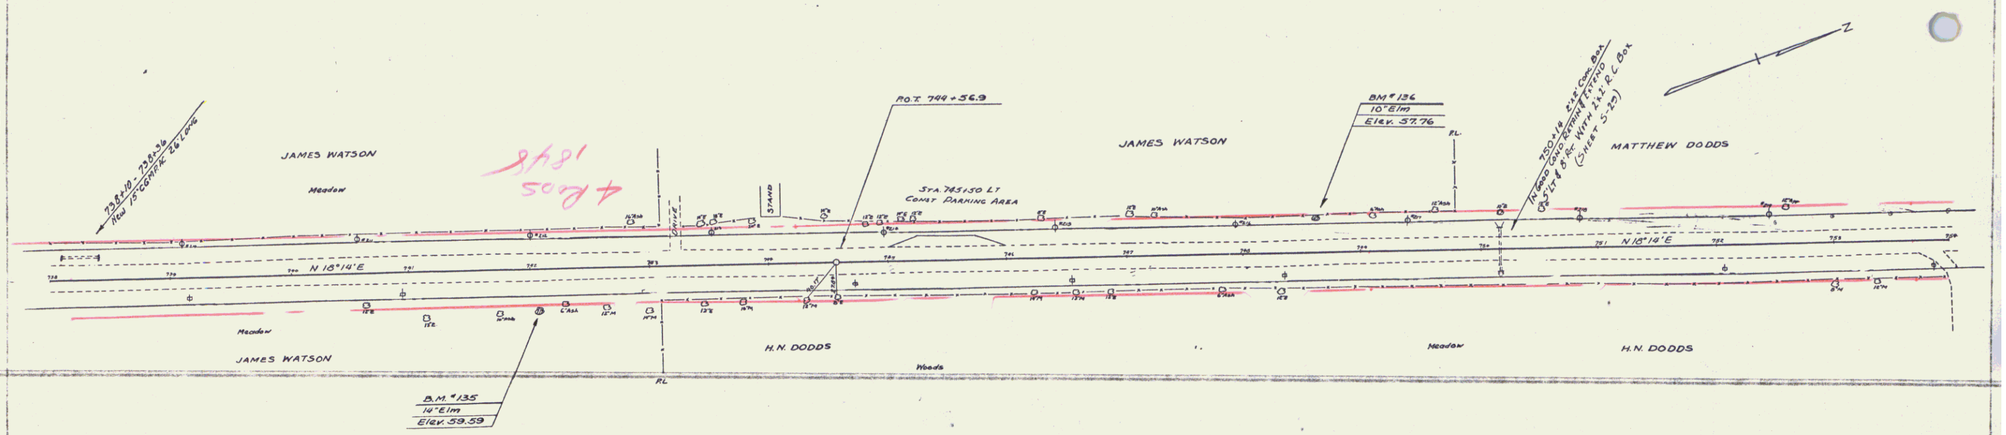

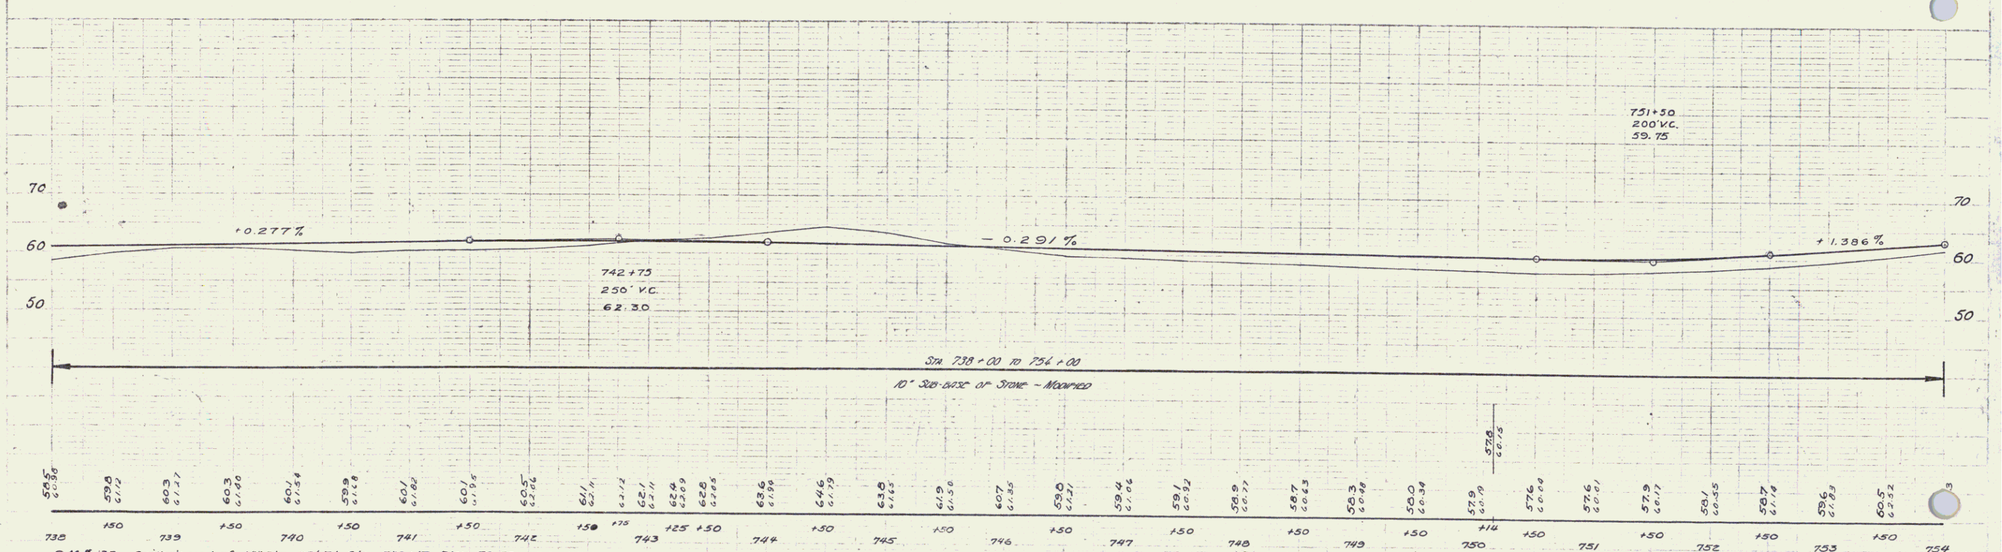

B.M. #135 Spike in root of 14" Elm 33' Rt Sta 742+17 Elev. 59.59

B.M. #136 Spike in root of 10" Elm 25' Lt Sta 749+61 Elev. 57.76

SERIES P.A.R. NO 128-D

SHEET 12 OF 65

10