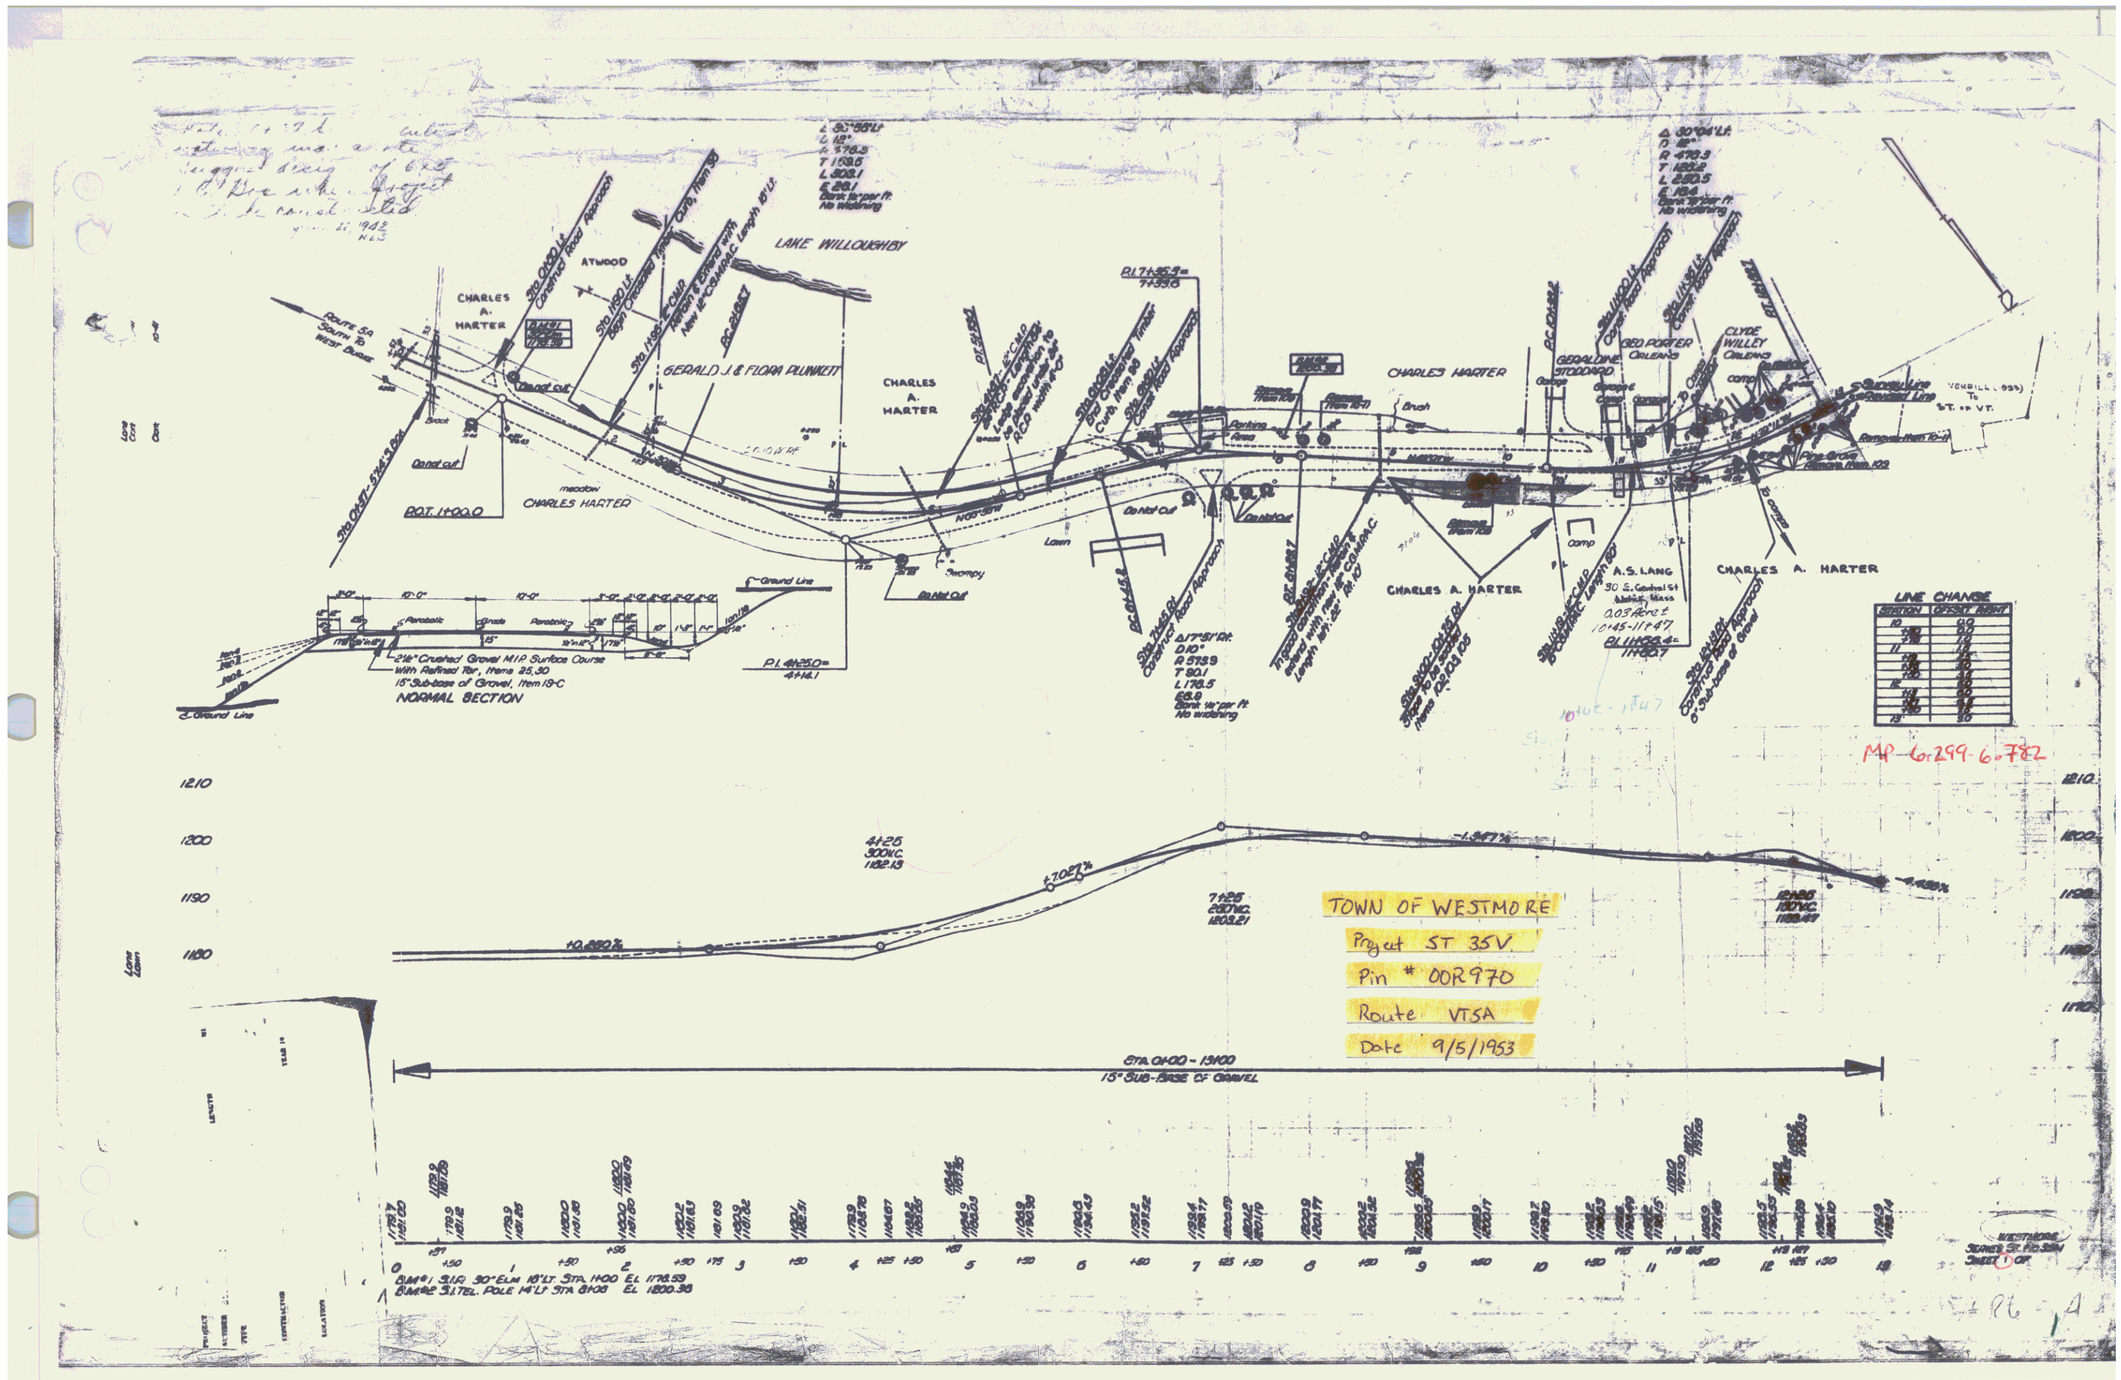
LAKE WILLOUGHBY
CHARLES A. HARTER
GERALD J. & FLORA PLUNKETT
CHARLES HARTER
A.S. LANG
NORMAL SECTION
LINE CHANGE
TOWN OF WESTMORE
Project ST 35V
Pin # 00R970
Route VT5A
Date 9/5/1953
STA. 0+00 - 13+00
15" SUB-BASE OF GRAVEL

MP-6.299-6.782