FED. ROAD DIST. NO.	STATE	FED. AID PROJ. NO.	FISCAL YEAR	SHEET NO.	TOTAL SHEETS
9	VT.	E-63-D	1932		

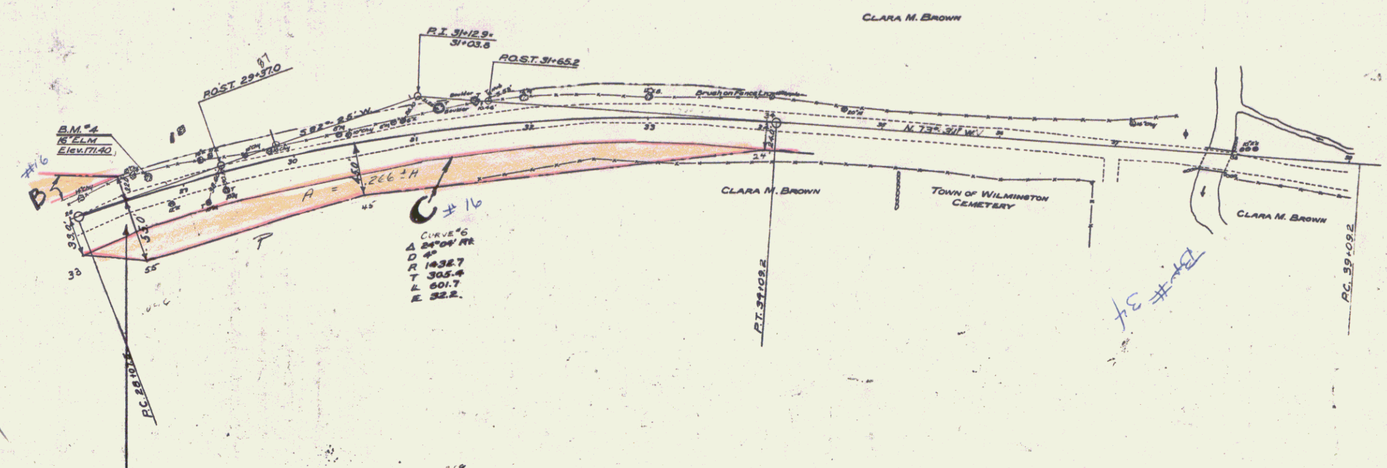

Parcel	Kind of Instrument	Date of Instrument	Grantor	Grantee	Recorded Book	Recorded Page	Date	Remarks
A-B-C	Q.C.D.	2-1-33	Clara M. Brown	St. of Vt.	Wilmington 29	367-3	2-6-33	

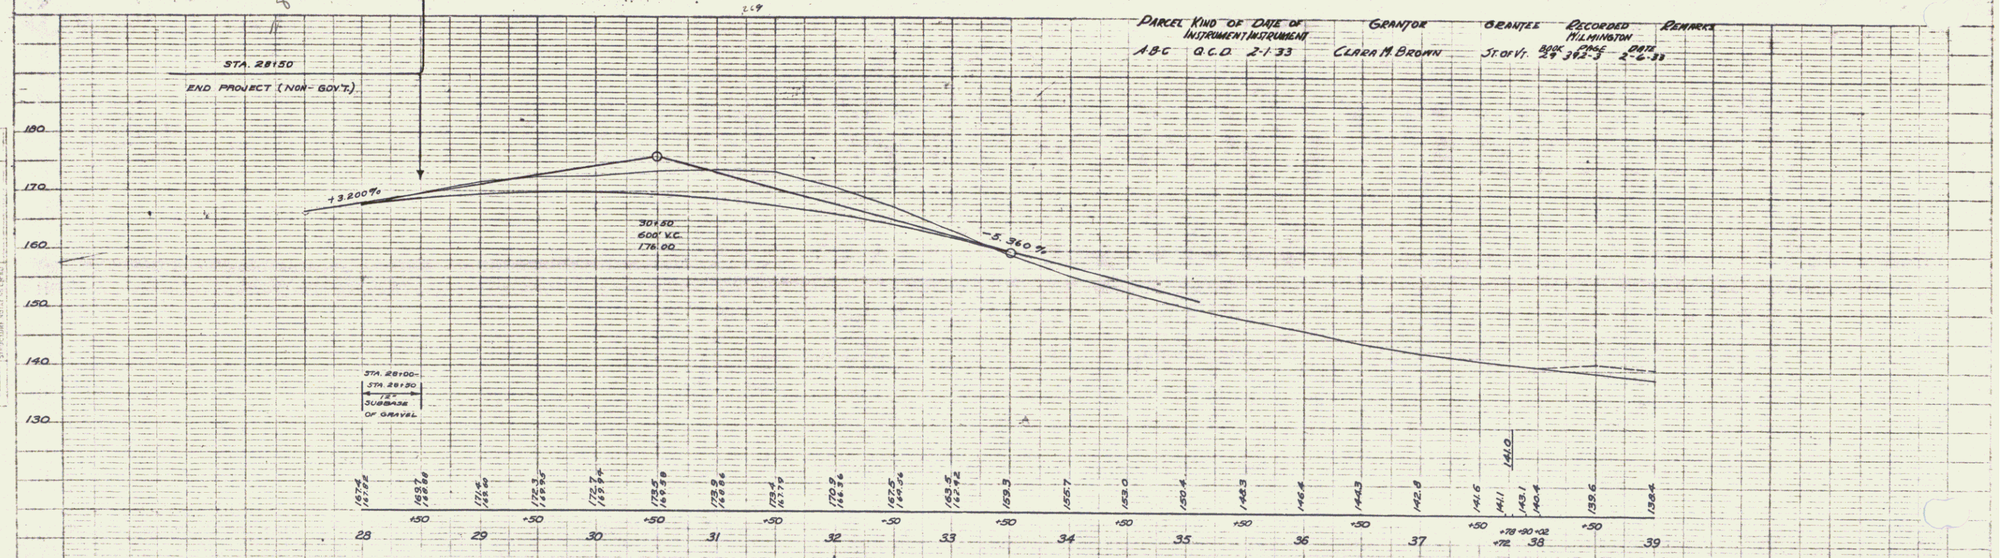

SERIES F. No. E63D
SHEET 6 OF

5