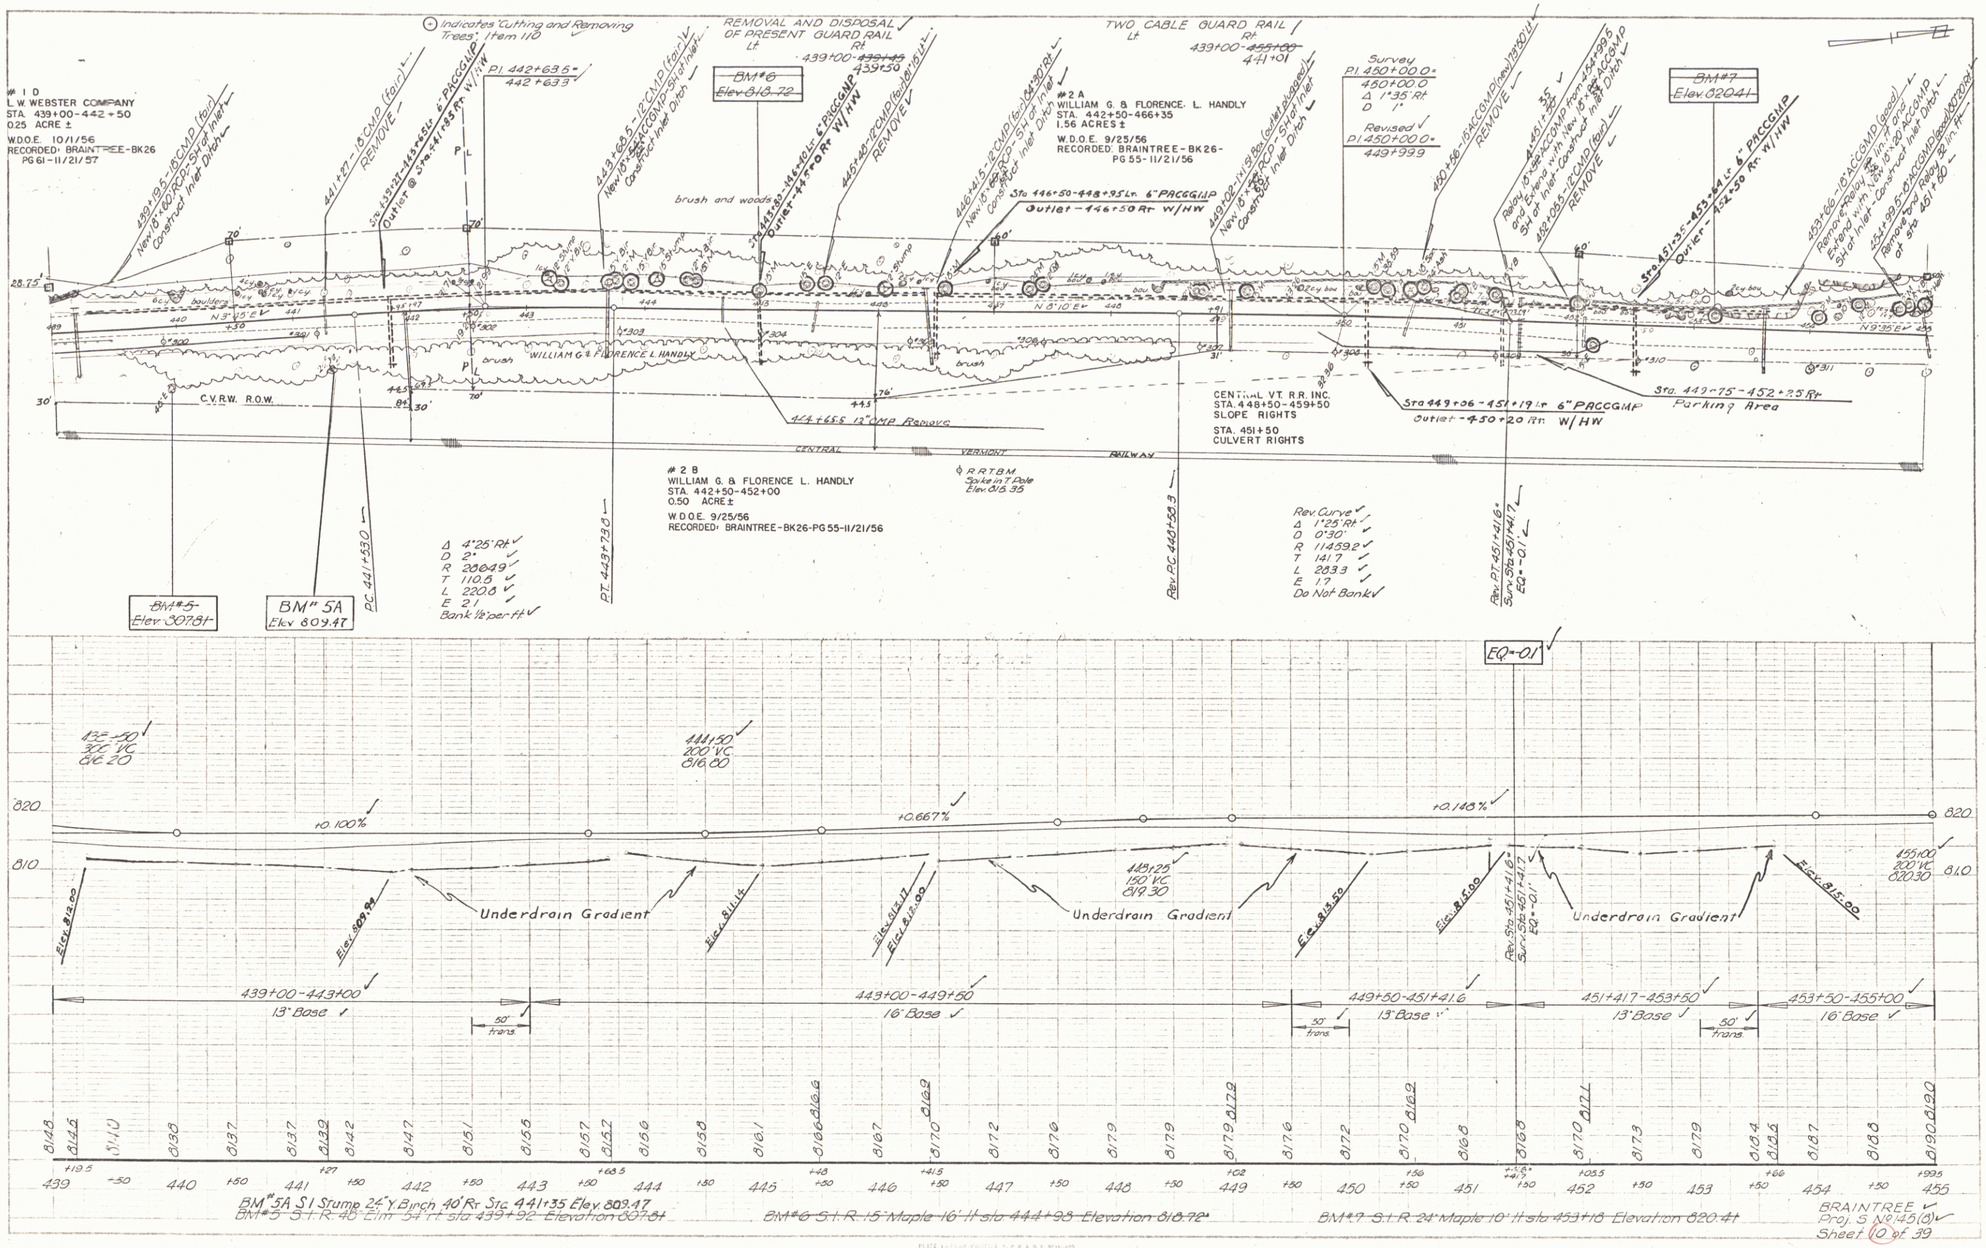
Indicates Cutting and Removing Trees, Item 110
REMOVAL AND DISPOSAL OF PRESENT GUARD RAIL
TWO CABLE GUARD RAIL
#1 D
L.W. WEBSTER COMPANY
STA. 439+00-442+50
0.25 ACRE ±
W.D.O.E. 10/1/56
RECORDED: BRAINTREE-BK26 PG 61-11/21/57
#2 A
WILLIAM G. & FLORENCE L. HANDLY
STA. 442+50-466+35
1.56 ACRES ±
W.D.O.E. 9/25/56
RECORDED: BRAINTREE-BK26-PG 55-11/21/56
#2 B
WILLIAM G. & FLORENCE L. HANDLY
STA. 442+50-452+00
0.50 ACRE ±
W.D.O.E. 9/25/56
RECORDED: BRAINTREE-BK26-PG 55-11/21/56
CENTRAL VT. R.R. INC.
STA. 448+50-459+50
SLOPE RIGHTS
STA. 451+50
CULVERT RIGHTS
Sta. 446+50-448+95 Lt. 6" PACCGMP
Outlet - 446+50 Rt. W/HW
Sta. 449+06-451+19 Lt. 6" PACCGMP
Outlet - 450+20 Rt. W/HW
Sta. 449+75-452+25 Rt.
Parking Area
Sta. 451+35-453+41 Lt. 6" PACCGMP
Outlet - 452+50 Rt. W/HW
Sta. 444+65.5 12" CMP Remove
brush and woods
WILLIAM G. & FLORENCE L. HANDLY
C.V.R.W. R.O.W.
CENTRAL VERMONT RAILWAY
R.R.T.B.M. Spike in T Pole Elev. 815.95
BM#5 Elev. 307.81
BM# 5A Elev. 809.47
BM#6 Elev. 818.72
BM#7 Elev. 820.41
EQ-01
Rev. PC 441+53.0
PT 443+73.0
Rev. PC 447+58.3
Rev. PT 451+41.6
Sur. Sta. 451+41.7
EQ-01
Rev. Curve
Δ 1°25' Rt
D 0°30'
R 114592
T 141.7
L 283.3
E 1.7
Do Not Bank
Δ 4°25' Rt
D 2°
R 28649
T 110.5
L 220.0
E 2.1
Bank 1/2" per ft
Underdrain Gradient
+0.100%
+0.667%
+0.148%
439+00-443+00
13" Base
443+00-449+50
16" Base
449+50-451+41.6
13" Base
451+41.7-453+50
13" Base
453+50-455+00
16" Base
50' trans.
BM#5A S.I. Stump 24" Y. Birch 40' Rt. Sta. 441+35 Elev. 809.47
BM#5 S.I.R. 40" Elm 54' Lt. Sta. 439+92 Elevation 307.81
BM#6 S.I.R. 15" Maple 16' Rt. Sta. 444+98 Elevation 818.72
BM#7 S.I.R. 24" Maple 10' Rt. Sta. 453+18 Elevation 820.41
BRAINTREE
Proj. S 129-145(8)
Sheet 10 of 39