FED. ROAD DIST. NO.	STATE	S	FISCAL YEAR	SHEET NO.	TOTAL SHEETS
9	VT.	145(5)	1996	7	14

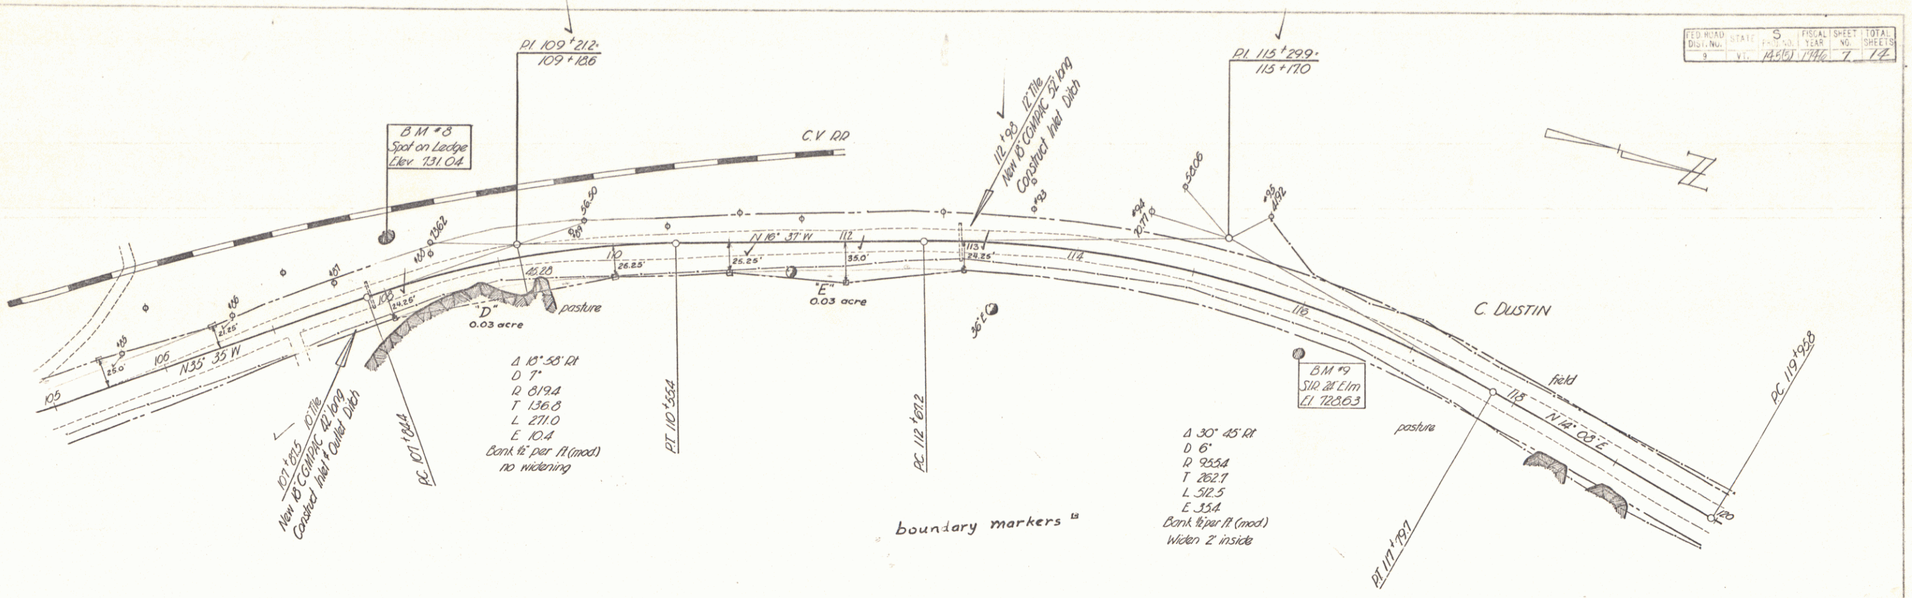

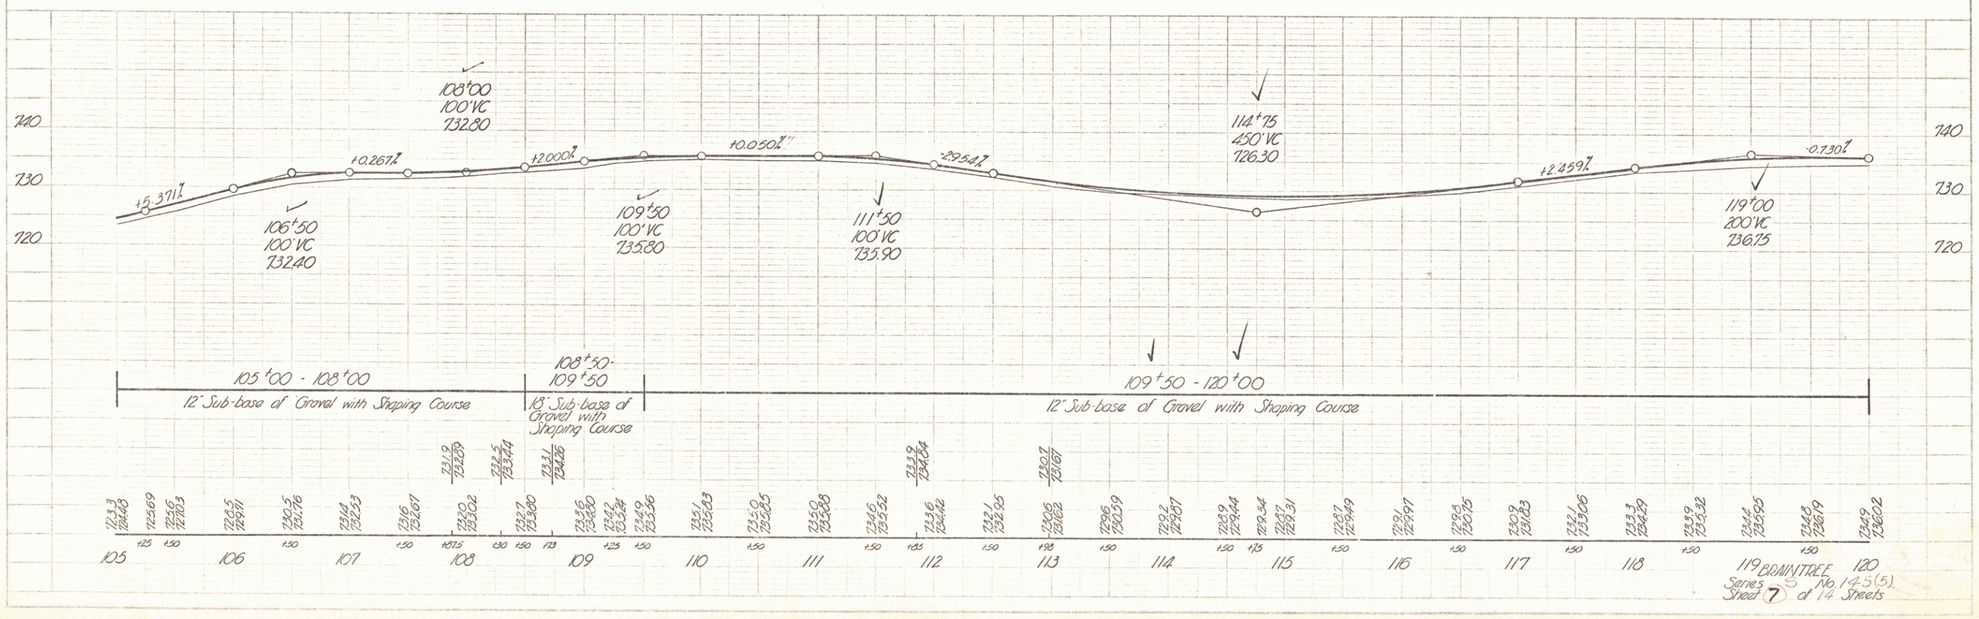

BRAINTREE
Series S No. 145(5)
Sheet 7 of 14 Sheets

5