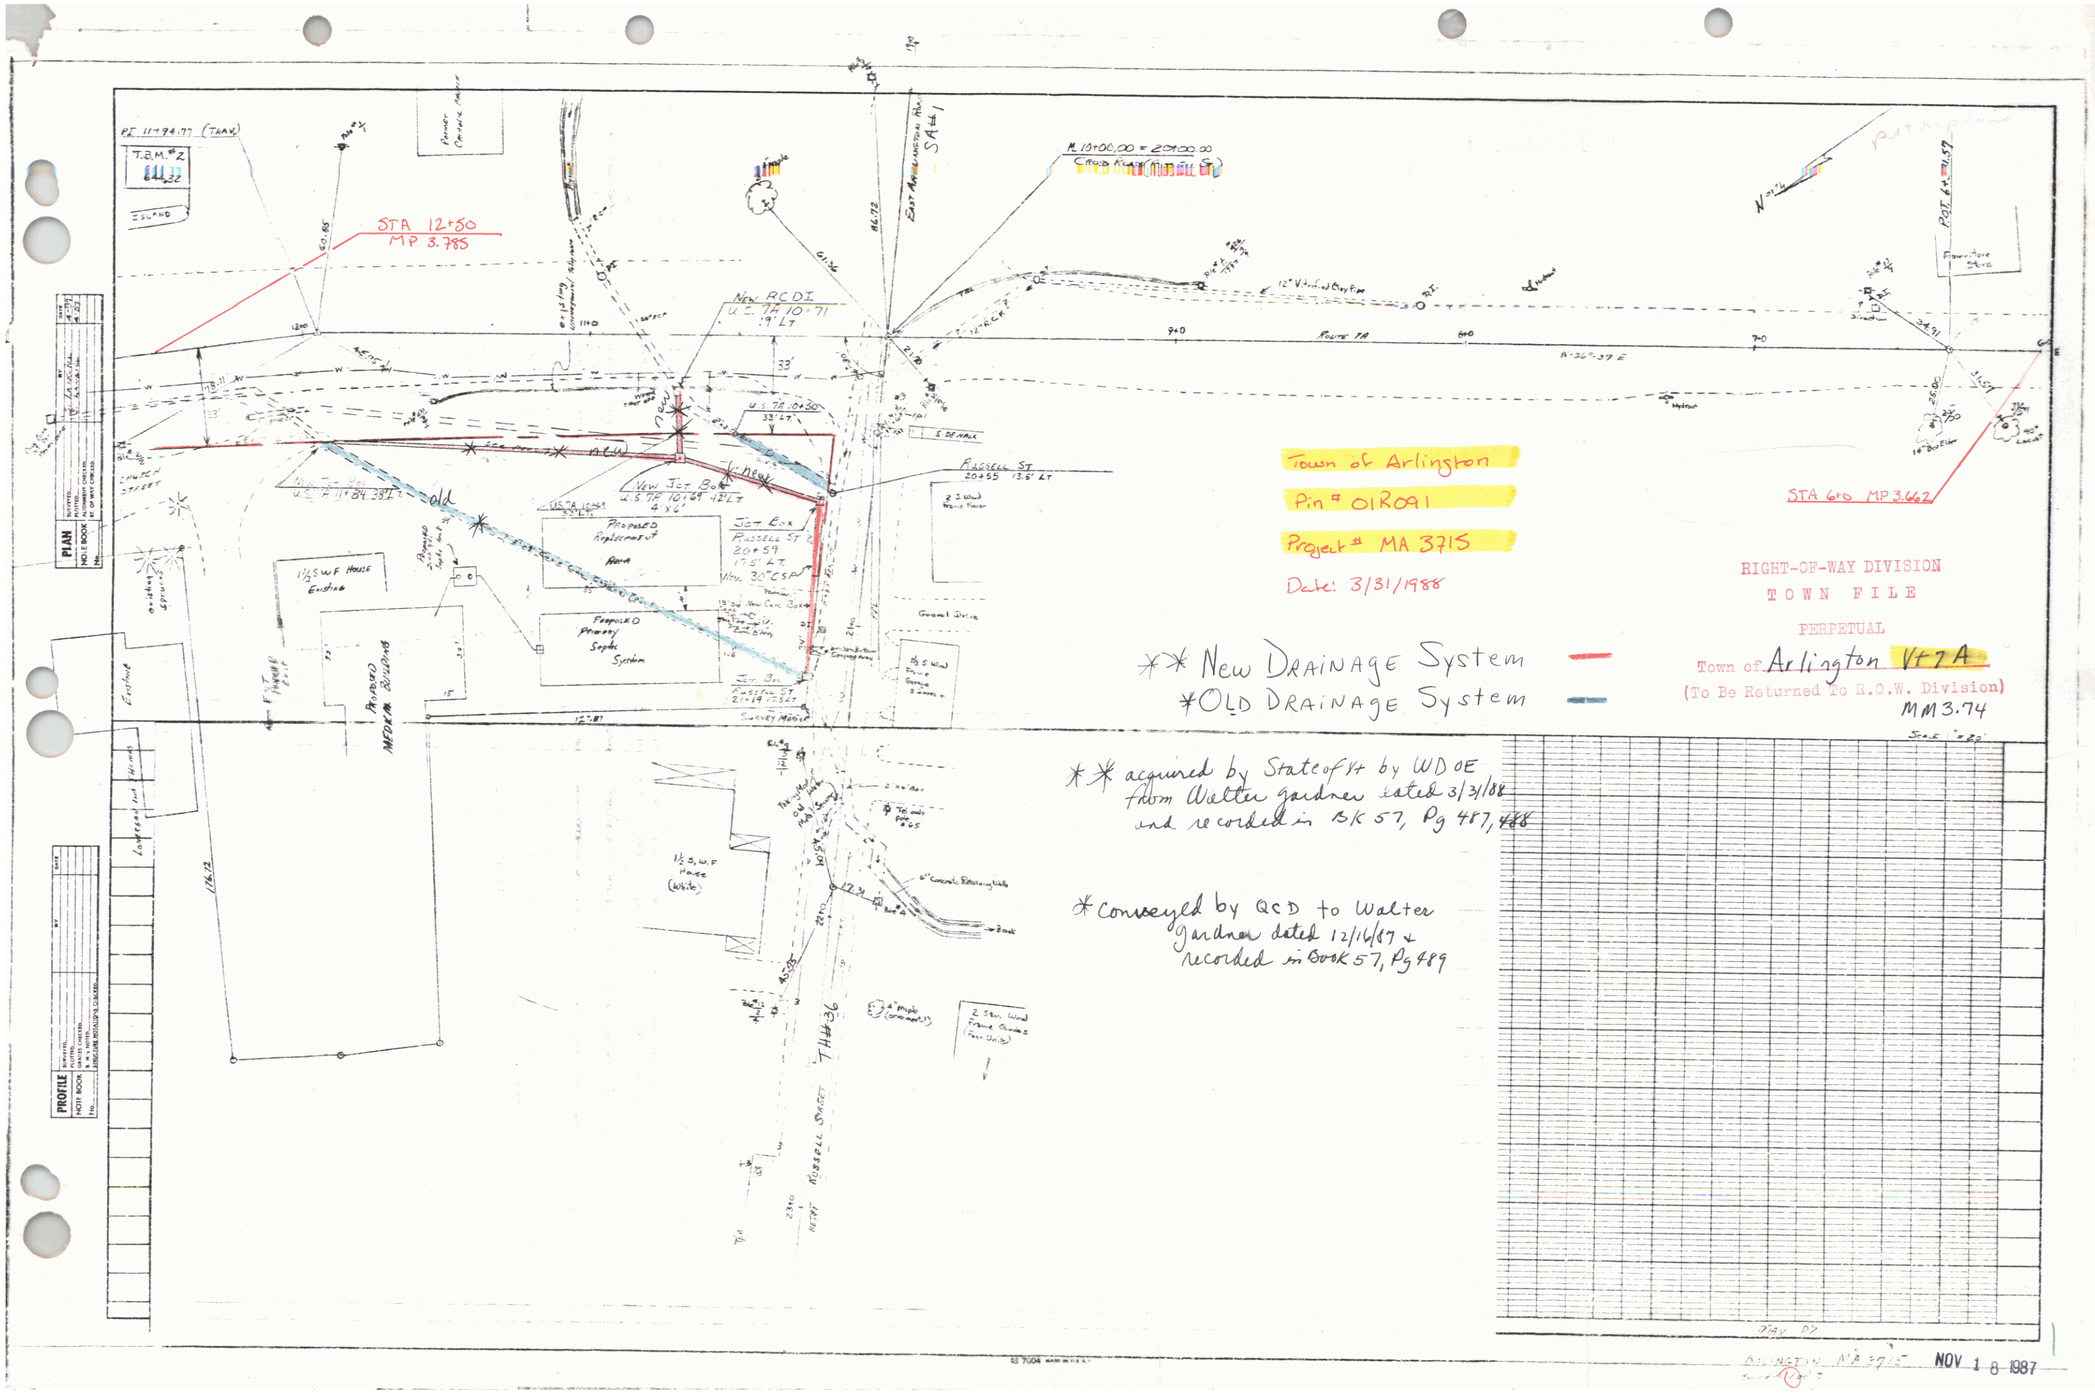
STA 12+50
MP 3.785
STA 6+0 MP 3.662
Route 7A
East Arlington Rd.
Russell St.
Church Street
New RCDI
New Jct Box
Jct Box
Proposed Replacement Barn
Proposed Primary Septic System
Proposed Modern Building
1½ S.W.F House Existing
1½ S.W.F House (White)
Town of Arlington
Pin # 01R091
Project # MA 3715
Date: 3/31/1988
** New Drainage System
*Old Drainage System
** acquired by State of Vt by WDOE from Walter Gardner dated 3/31/88 and recorded in B/K 57, Pg 487, 488
* Conveyed by QCD to Walter Gardner dated 12/16/87 & recorded in Book 57, Pg 489
RIGHT-OF-WAY DIVISION
TOWN FILE
PERPETUAL
Town of Arlington Vt 7A
(To Be Returned To R.O.W. Division)
MM 3.74
NOV 18 1987