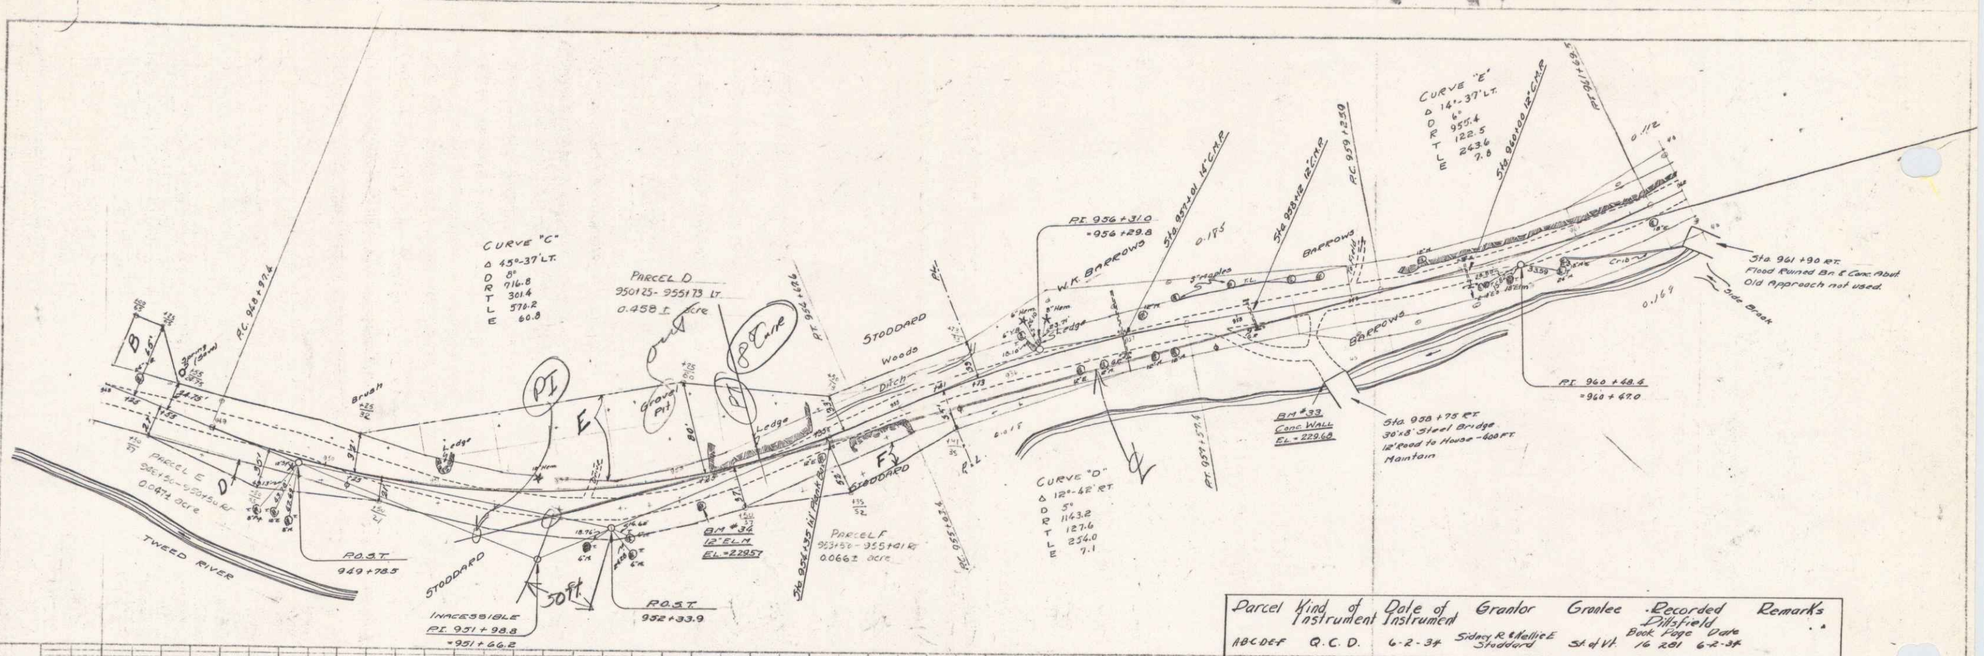

Parcel	Kind of Instrument	Date of Instrument	Grantor	Grantee	Recorded Dillsfield Book	Page	Date	Remarks
ABCDEF	Q.C.D.	6-2-34	Sidney R. & Hallie E. Stoddard	State of Vt.	16	281	6-2-34	

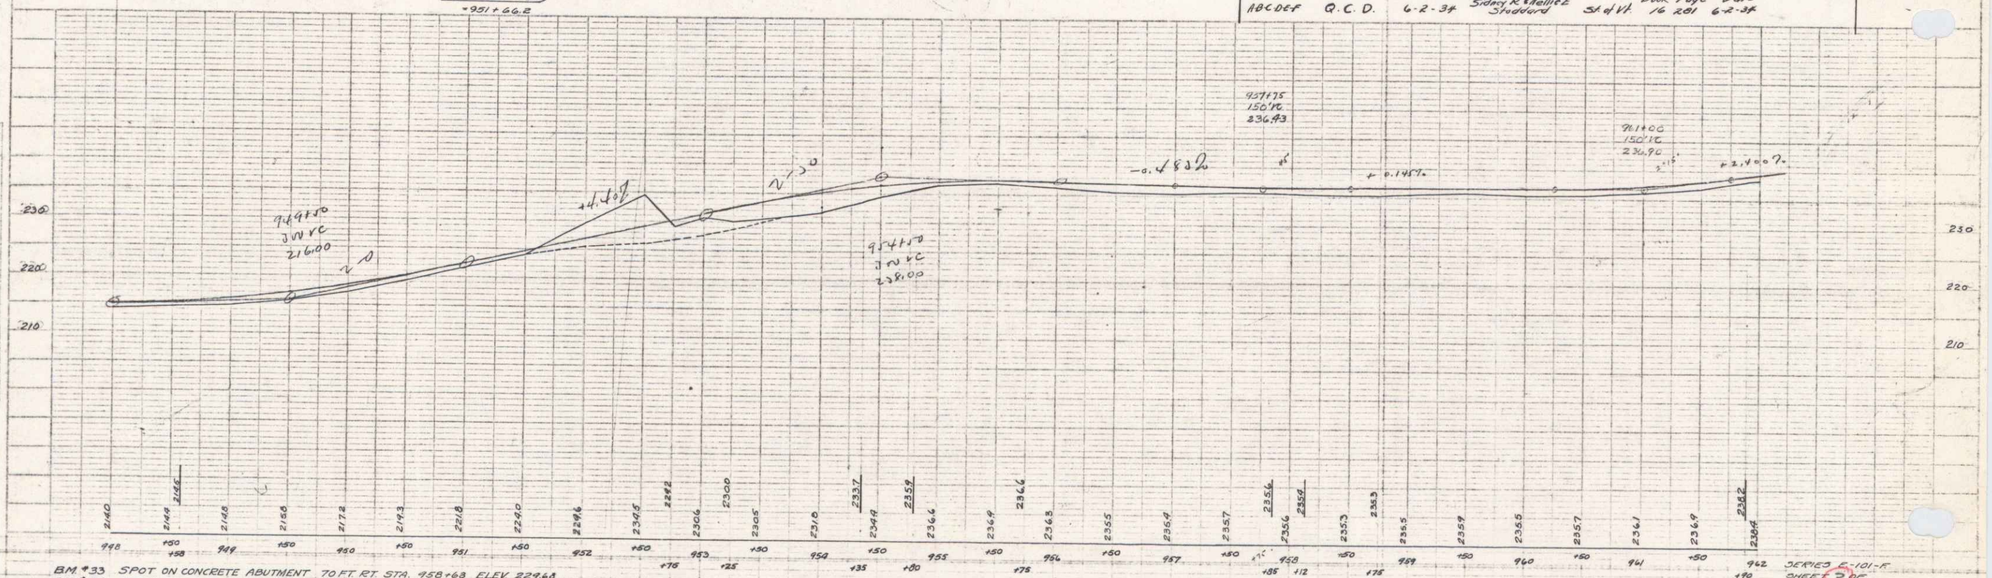

BM #33 SPOT ON CONCRETE ABUTMENT 70 FT. RT. STA. 958+68 ELEV. 229.68
~~BM #34 SPIKE IN TRUNK 18 IN. ELM 24 FT. RT. STA. 953+16 ELEV. 229.57~~

SERIES E-101-F
SHEET 3 OF

15

3