E101F 1932 9 53

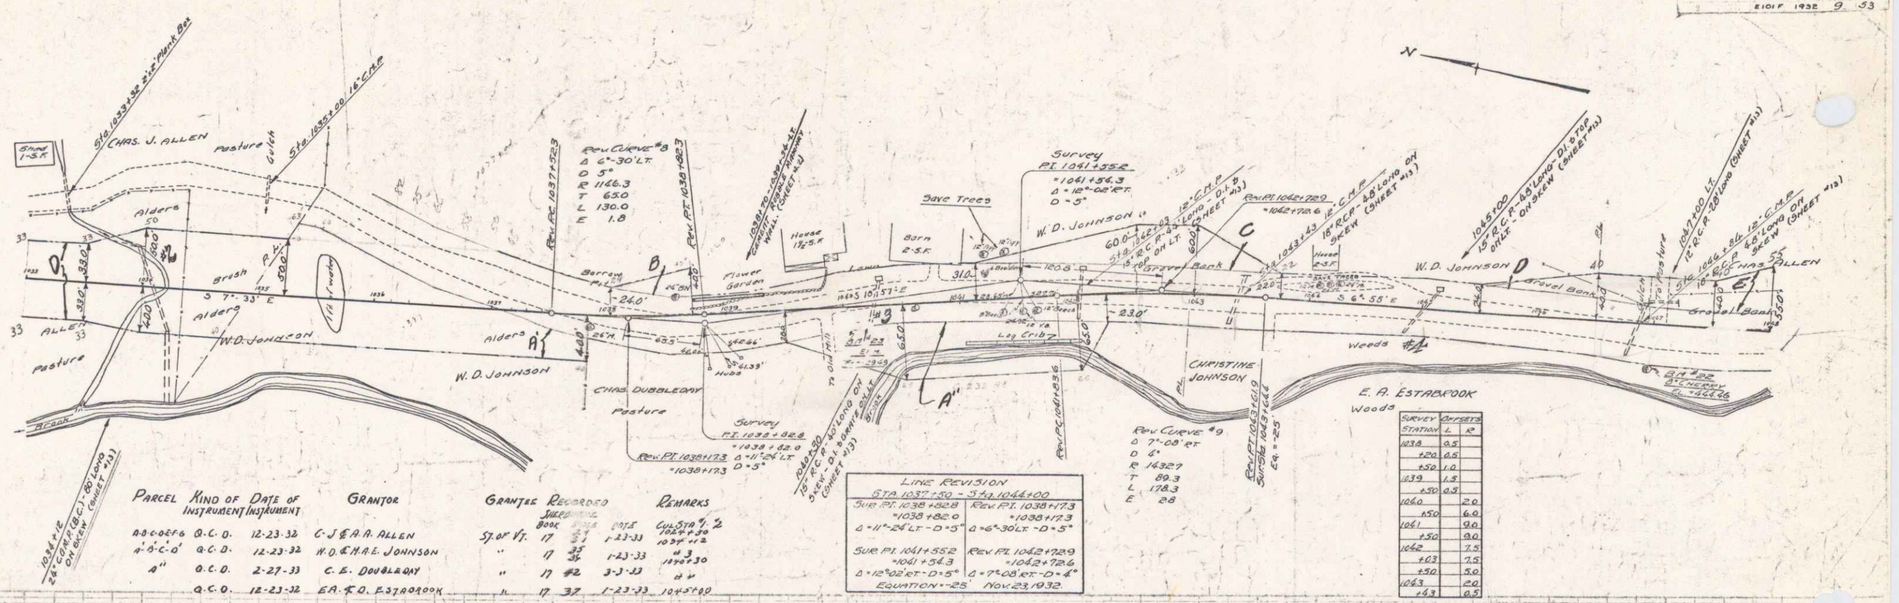

Survey Station	Offsets L	Offsets R
1038	0.5	
+20	0.5	
+50	1.0	
1039	1.5	
+50	0.5	
1040		2.0
+50		6.0
1041		9.0
+50		9.0
1042		7.5
+03		7.5
+50		5.0
1043		2.0
+43		0.5

Parcel	Kind of Instrument	Date of Instrument	Grantor	Grantee	Recorded Sur. Book	Recorded Page	Date	Remarks Cul. Sta.
A-B-C-D-E-F-G	Q.C.D.	12-23-32	C. J. & A. A. Allen	St. of Vt.	17	31	1-23-33	1034+38
A'-B'-C'-D'	Q.C.D.	12-23-32	W. D. & H. A. E. Johnson	"	17	35	1-23-33	1039+43
A''	Q.C.D.	2-27-33	C. E. Doubleday	"	17	42	3-3-33	1040+30
	Q.C.D.	12-23-32	E. A. & D. F. Estabrook	"	17	37	1-23-33	1045+80

LINE REVISION
STA. 1037+50 - STA. 1044+00

Sur. P.I. 1038+82.8 =1038+82.0	Rev. P.I. 1038+17.3 =1038+17.3
Δ = 11°-24' LT - D = 5°	Δ = 6°-30' LT - D = 5°
Sur. P.I. 1041+55.2 =1041+54.3	Rev. P.I. 1042+72.9 =1042+72.6
Δ = 12°-02' RT - D = 5°	Δ = 7°-00' RT - D = 4°
EQUATION = -25	Nov. 23, 1932

9