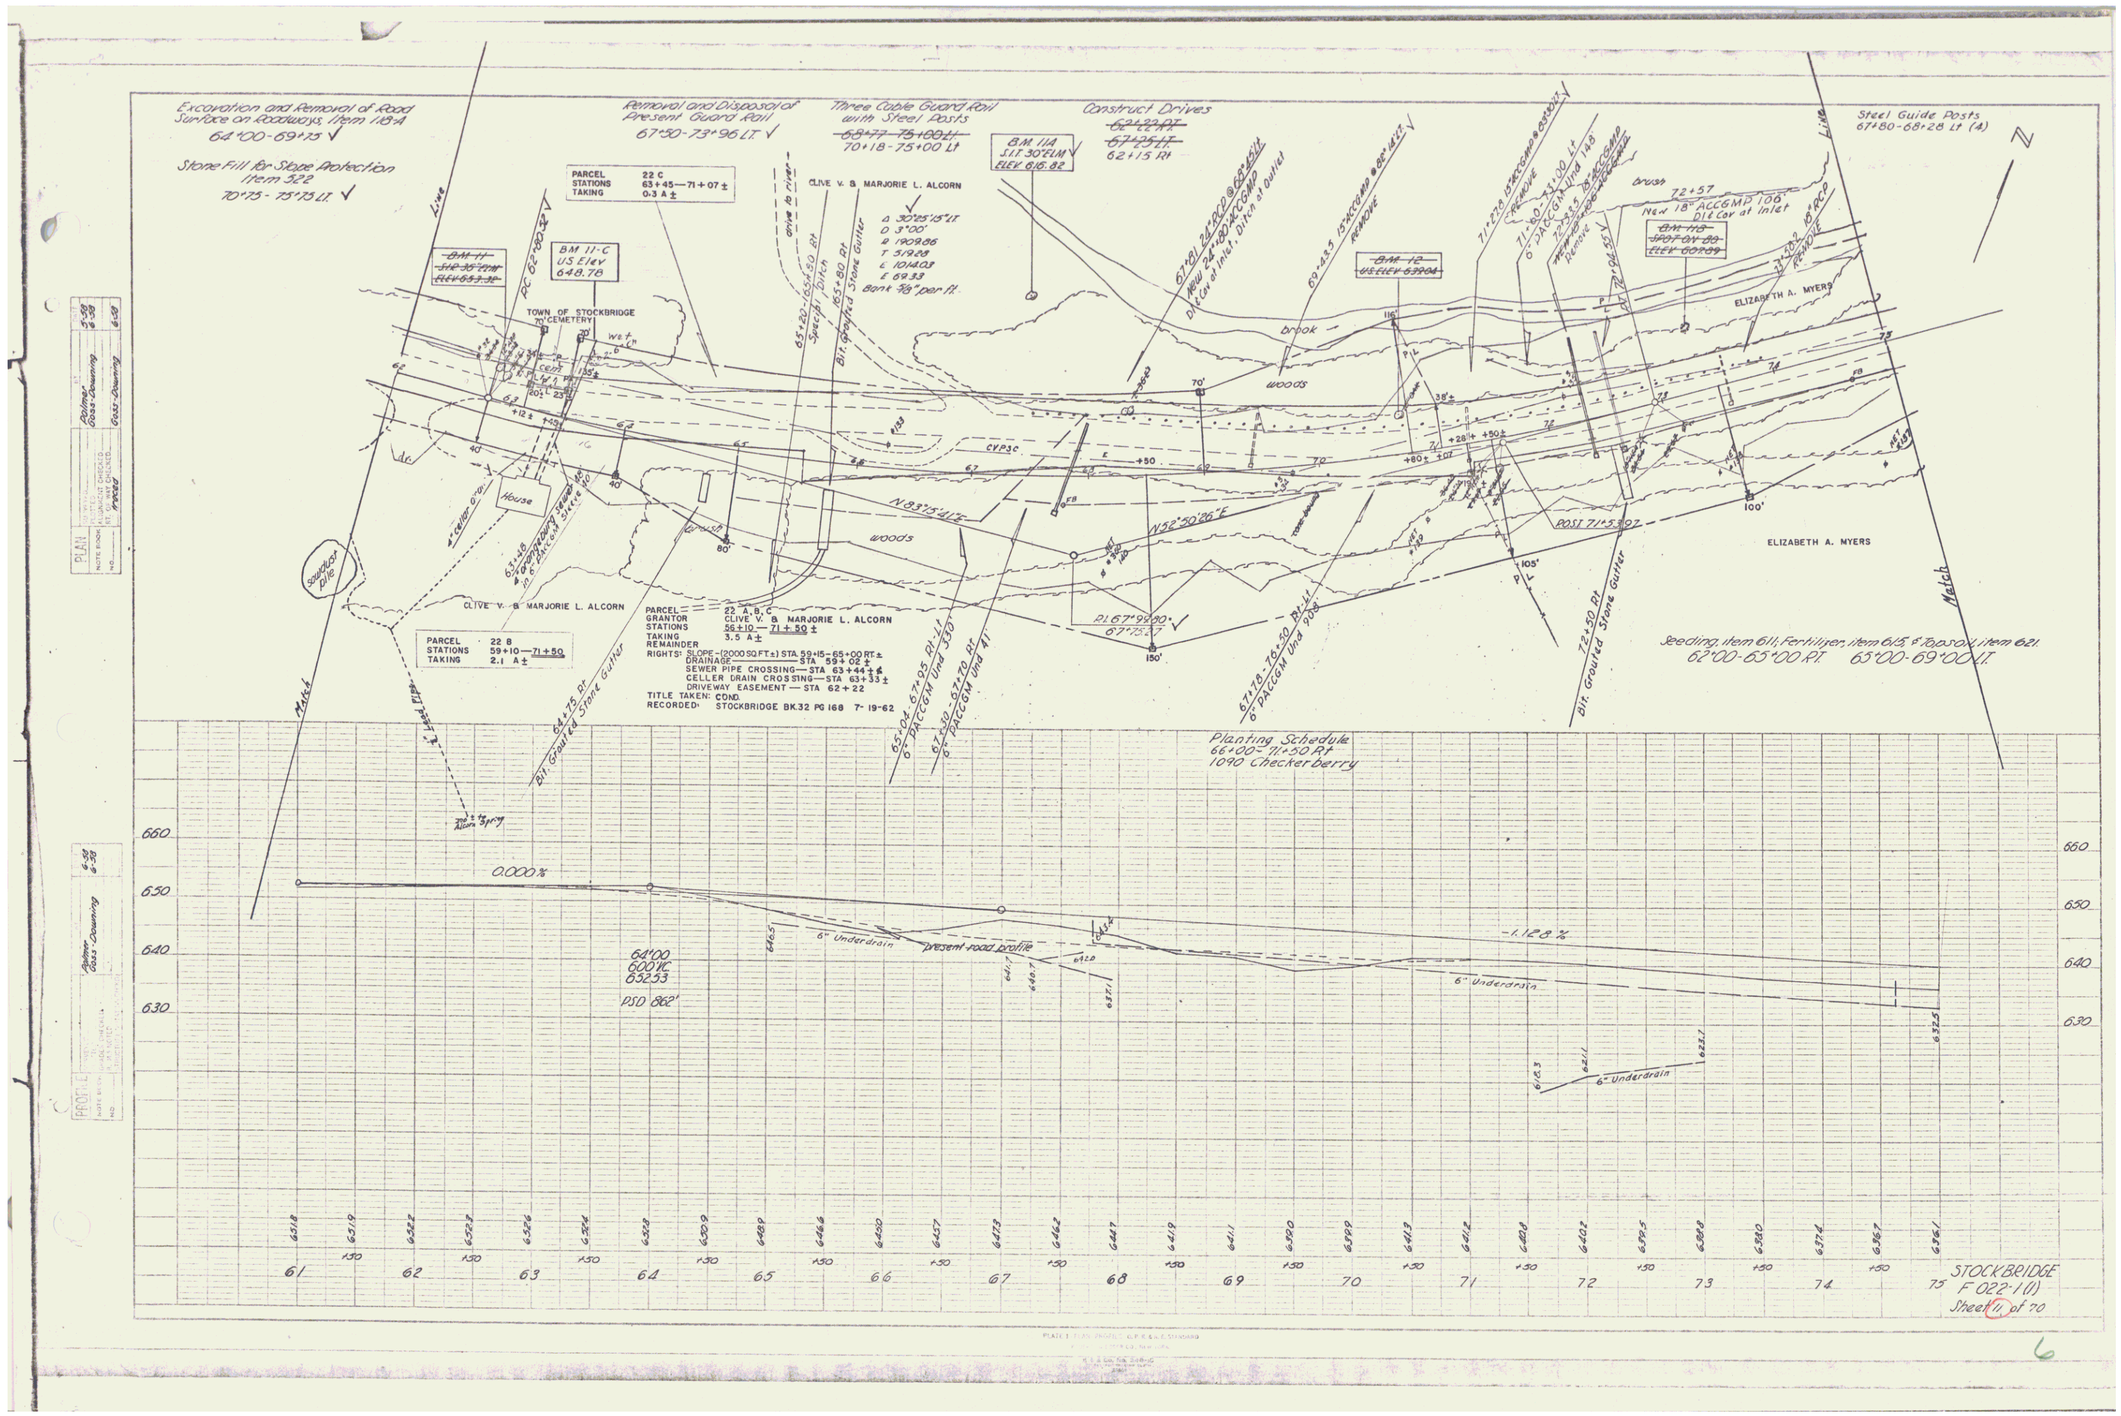
Excavation and Removal of Road Surface on Roadways, Item 1.18-A
64+00-69+75
Stone Fill for Slope Protection Item 522
70+75 - 75+75 Lt
67+50-73+96 Lt
Three Cable Guard Rail with Steel Posts
70+18-75+00 Lt
Construct Drives
62+15 Rt
Steel Guide Posts
67+80-68+28 Lt (4)
PARCEL 22 C
STATIONS 63+45—71+07 ±
TAKING 0.3 A ±
BM 11-C
U.S. Elev
648.78
TOWN OF STOCKBRIDGE
CEMETERY
CLIVE V. & MARJORIE L. ALCORN
House
cellar
brook
woods
ELIZABETH A. MYERS
PARCEL 22 B
STATIONS 59+10—71+50
TAKING 2.1 A ±
PARCEL 22 A, B, C
GRANTOR CLIVE V. & MARJORIE L. ALCORN
STATIONS 56+10 — 71+50 ±
TAKING
REMAINDER
RIGHTS: SLOPE (2000 SQ.FT.±) STA. 59+15-65+00 RT. ±
DRAINAGE — STA 59+02 ±
SEWER PIPE CROSSING — STA 63+44 ±
CELLER DRAIN CROSSING — STA 63+33 ±
DRIVEWAY EASEMENT — STA 62+22
TITLE TAKEN: COND.
RECORDED: STOCKBRIDGE BK.32 PG 168 7-19-62
Seeding, Item 611, Fertilizer, Item 615, & Topsoil, Item 621
62+00-65+00 RT 65+00-69+00 LT
Planting Schedule
66+00-71+50 Rt
1090 Checkerberry
0.000%
-1.128%
6" Underdrain
present road profile
64+00
600 VC
PSD 862'
STOCKBRIDGE
F 022-1(1)
Sheet 11 of 70