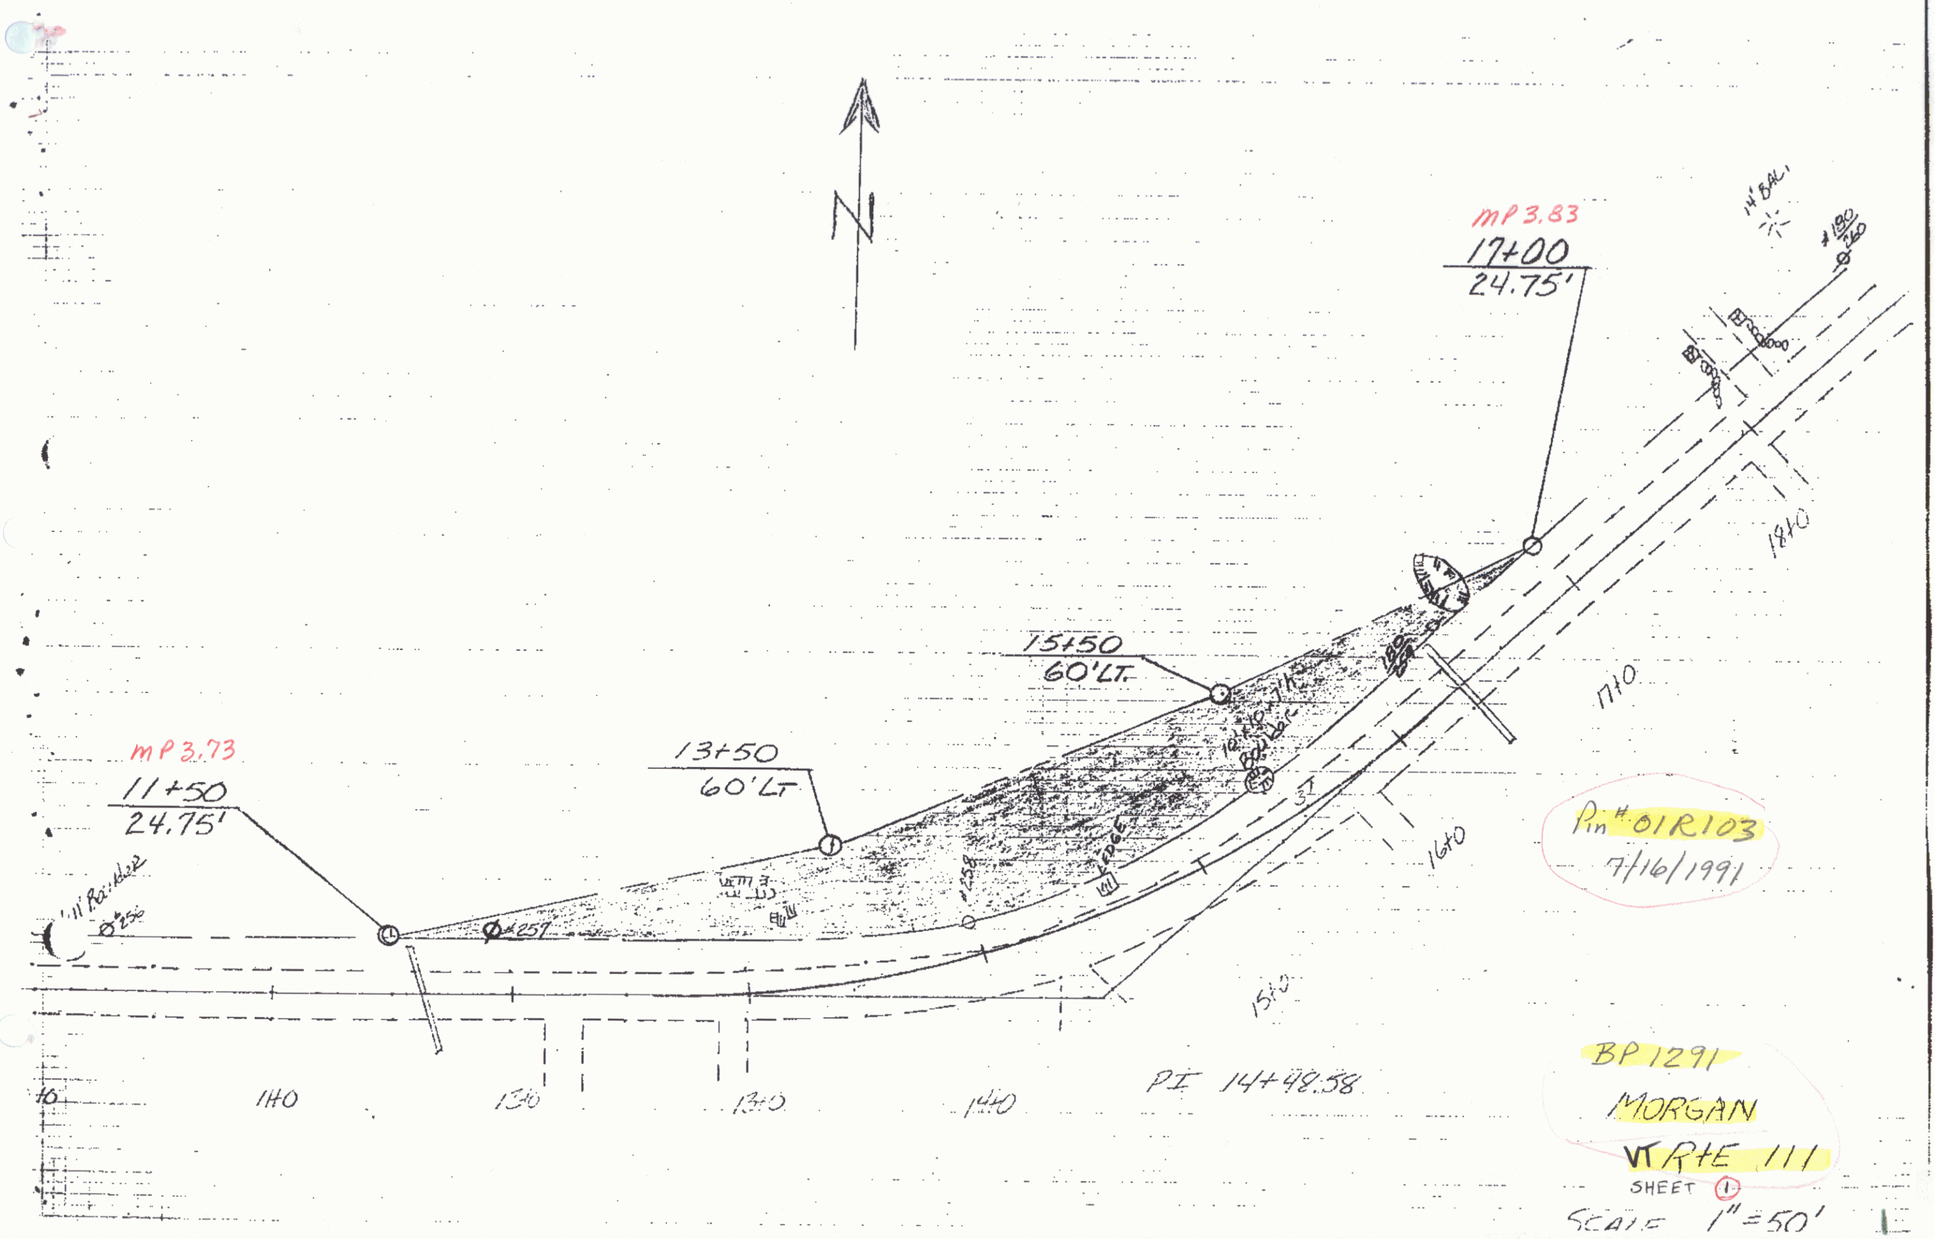
N
MP 3.83
17+00
24.75'
14" BALL
#190
#260
18+0
17+0
16+0
15+0
15+50
60'LT.
13+50
60'LT.
MP 3.73
11+50
24.75'
11" Rainbow
#256
#257
#258
#259
#260
10
11+0
12+0
13+0
14+0
PI 14+48.58
Pin # 01R103
7/16/1991
BP 1291
MORGAN
VT RTE 111
SHEET 1
SCALE 1" = 50'