Town of Halifax Project No. BMA 6221

Pin # 01R104 Vt. Rte 112

(District Job)

NOTE: From revised station 84+50± revised station 88+50 the Proposed Row shown was interpolated from Pond Bridge Project 2UR.16-4 1940

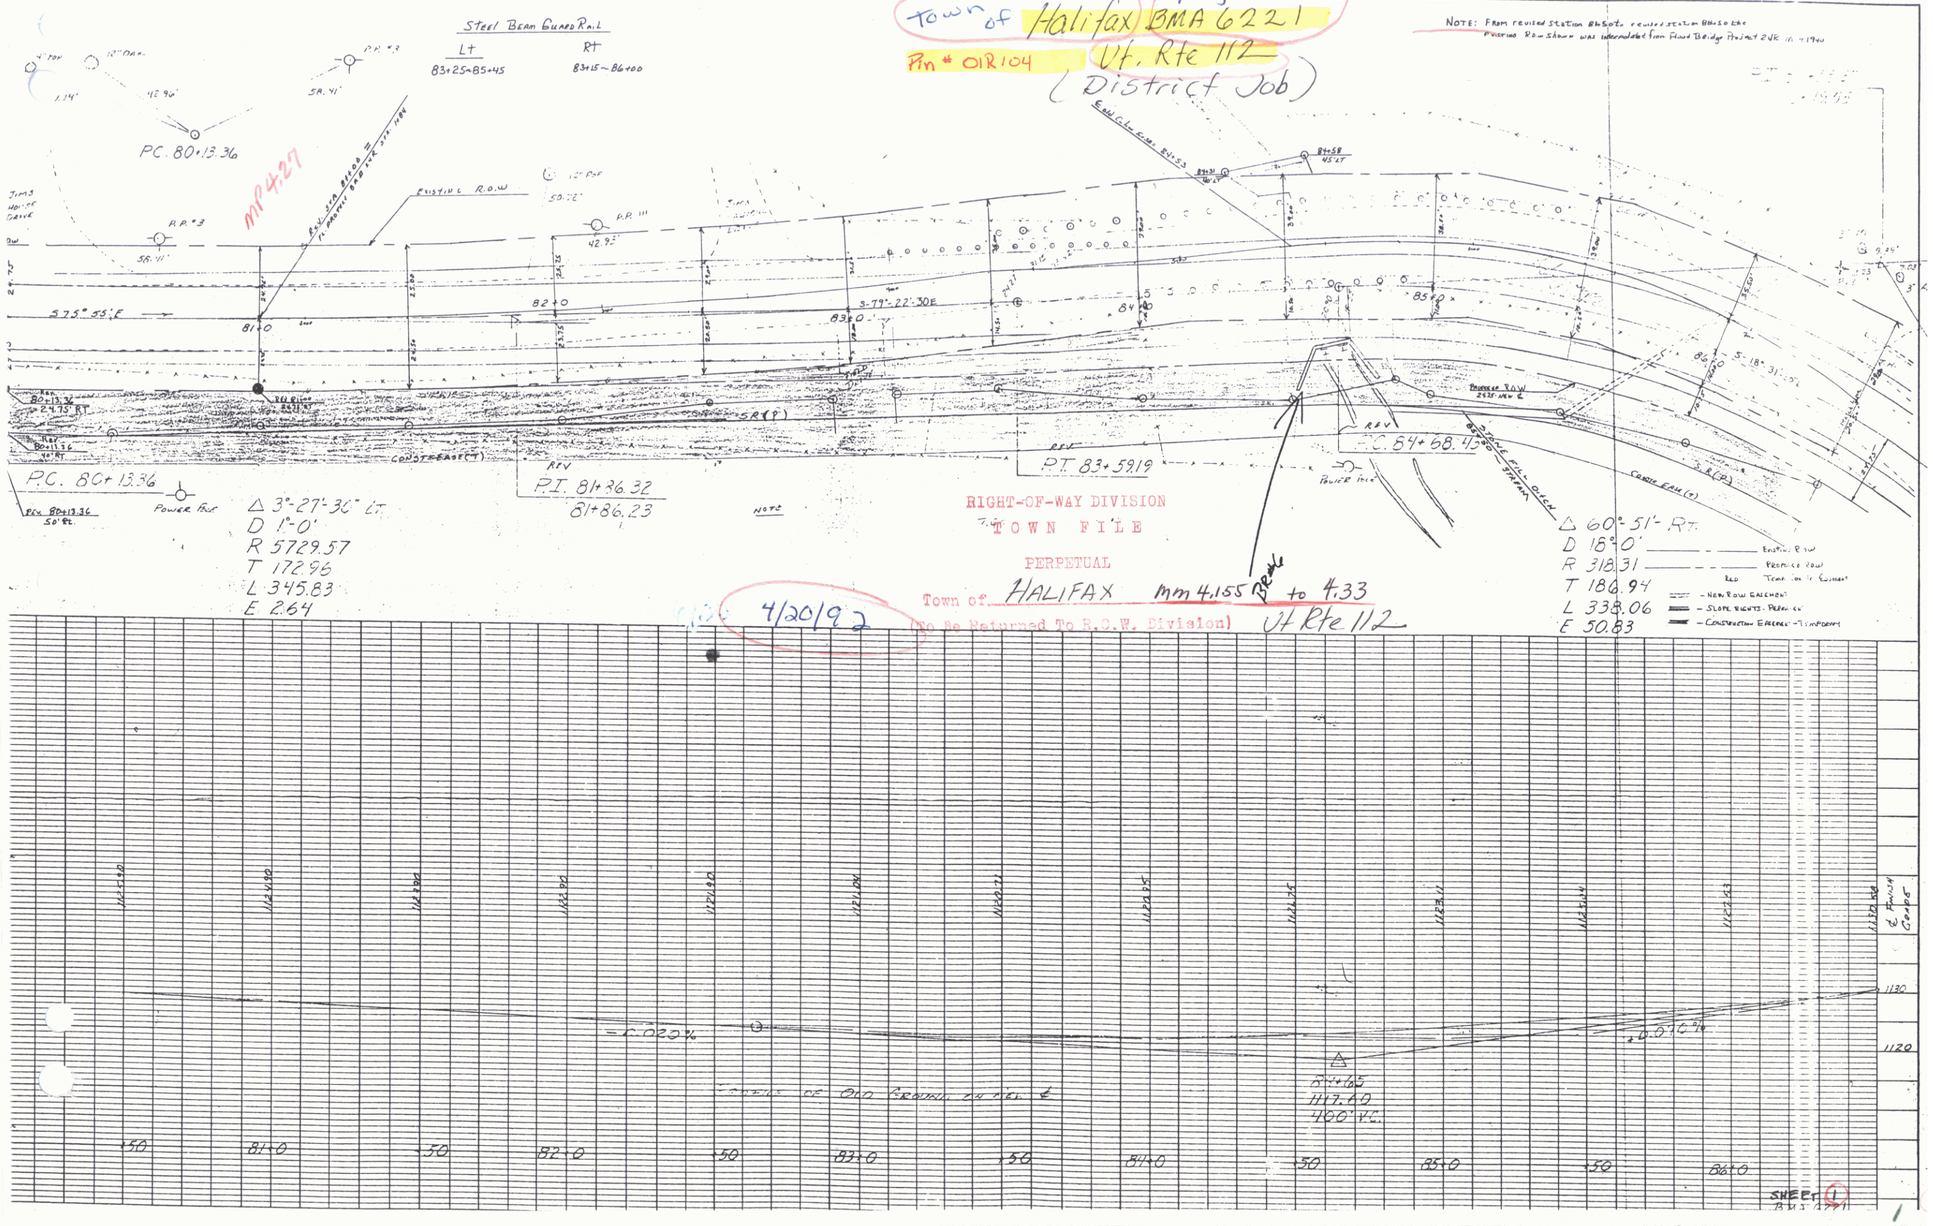

RIGHT-OF-WAY DIVISION
TOWN FILE
PERPETUAL
Town of HALIFAX mm 4.155 Break to 4.33
4/20/92
(To be Returned To R.O.W. Division)
Vt Rte 112