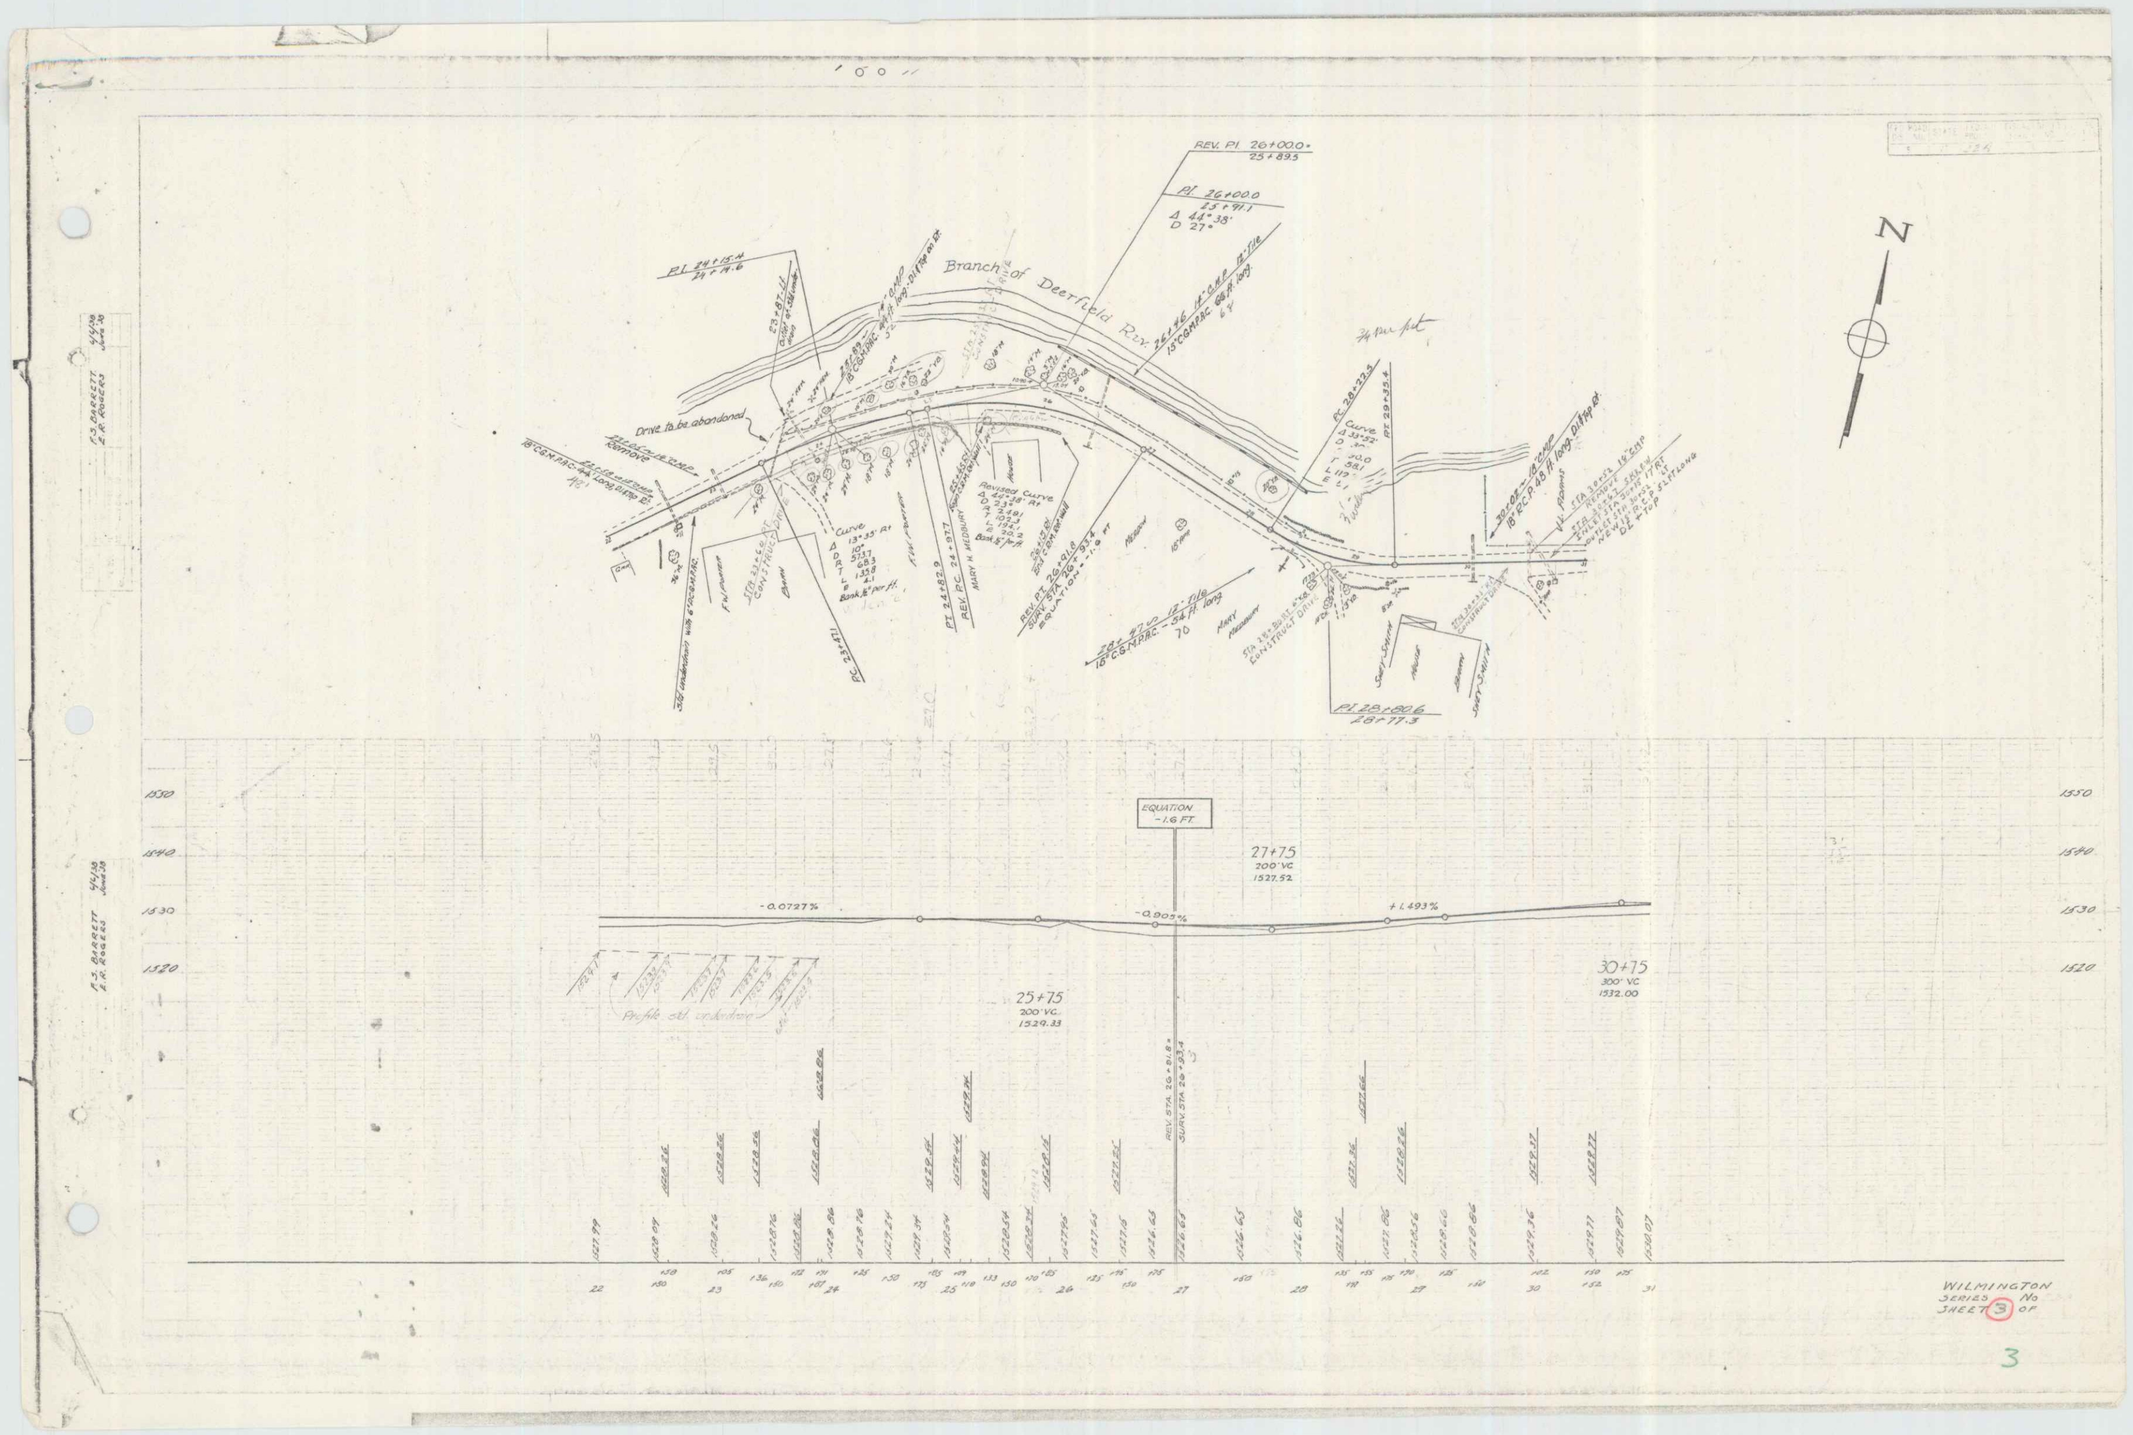
REV. PI 26+000.
25+89.5
PI 26+000.0
25+91.1
Δ 44° 38'
D 27°
Branch of Deerfield Riv.
PI 24+15.4
24+74.6
Drive to be abandoned
Revised Curve
Curve
Curve
PI 28+81.6
28+77.3
N
EQUATION
-1.6 FT.
27+75
200' VC
1527.52
-0.0727%
-0.905%
+1.493%
25+75
200' VC.
1529.33
30+75
300' VC
1532.00
REV. STA. 26+81.6
SURV. STA. 26+83.4
1550
1540
1530
1520
WILMINGTON
SERIES No
SHEET 3 OF
3