POOR ORIGINAL COPY
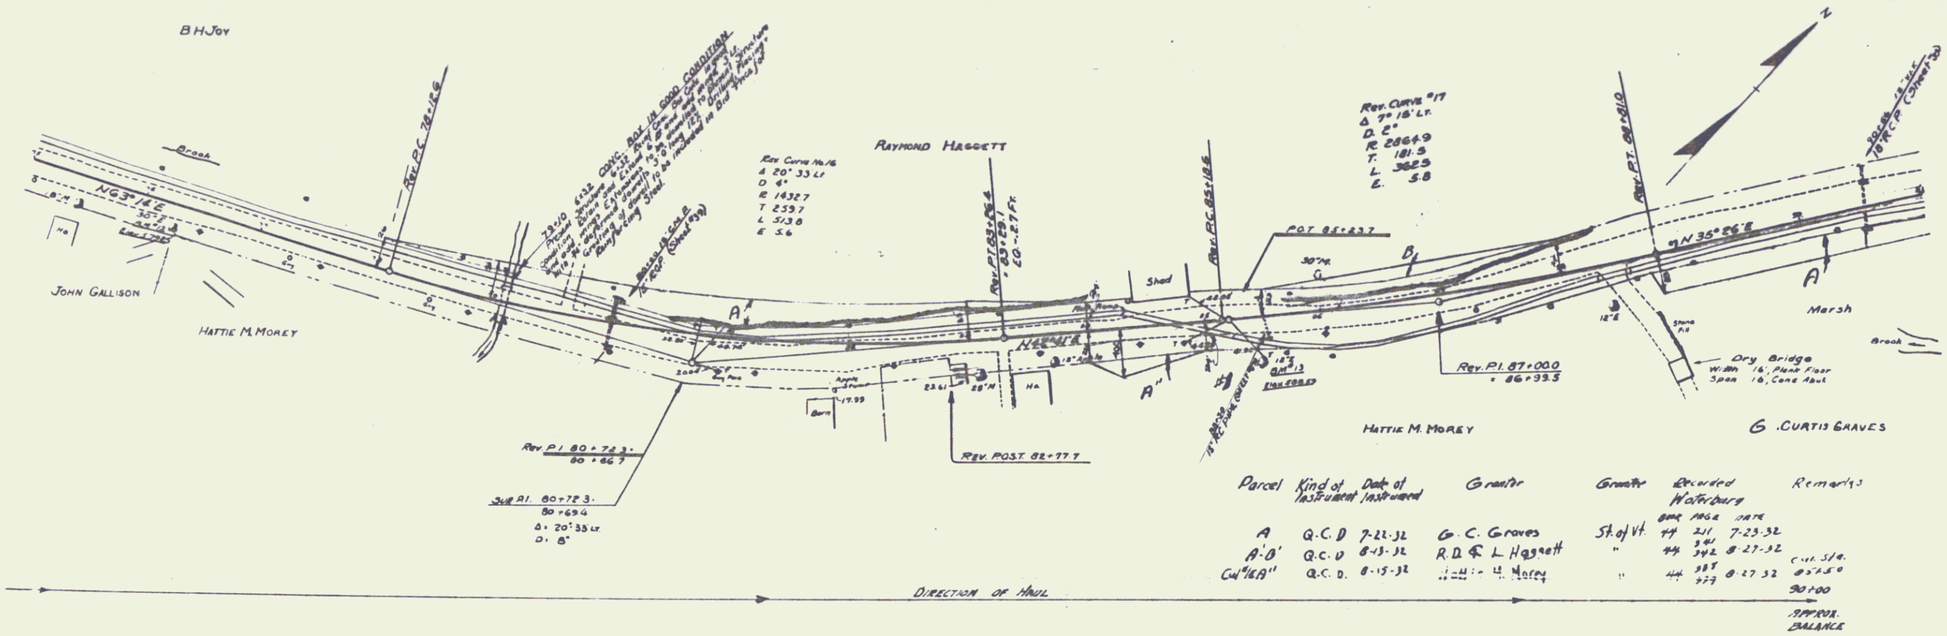
116-B 1932 9 122