Guide Posts of Wood		
Culvert Sta	Left	Right
152+98	1	1

Reinforced Concrete Pipe Culverts						
Station	Size	Leng	Conc. A	C.R.M.	Reinf. Steel	
152+98	15"	36'	23 cy	—	184#	

Std Underdrain with 6" Perf. C.G.M. Pipe			
Sta to Sta	Loc R	Leng	C.P.M.
150+50-156+80	℄	430'	10 cy

Grouted Cobble Gutter					
Sta - Sta	Loc R	Long	Width	Area	
153+62 - 154+82	L	120	3'	40.0 sy.	
157+60 160+70	R	310	3'	103.0 sy.	

Driveway Pipe Culverts					
Station	Loc R	Type	Size	Leng	C.R.M.
153+35	Lt	RCPipe	18"	50'	16 cy

67-8 1932 14 96

Parcel	Grantor	Grantee	Tuser	Date	Recorded	Book	Page	Date	Remarks
Olla & Anna Rose Quimby	Town of Bethel	W.O.R.		9-20-28	Bethel	33½	371A	10-4-28	Description Indefinite

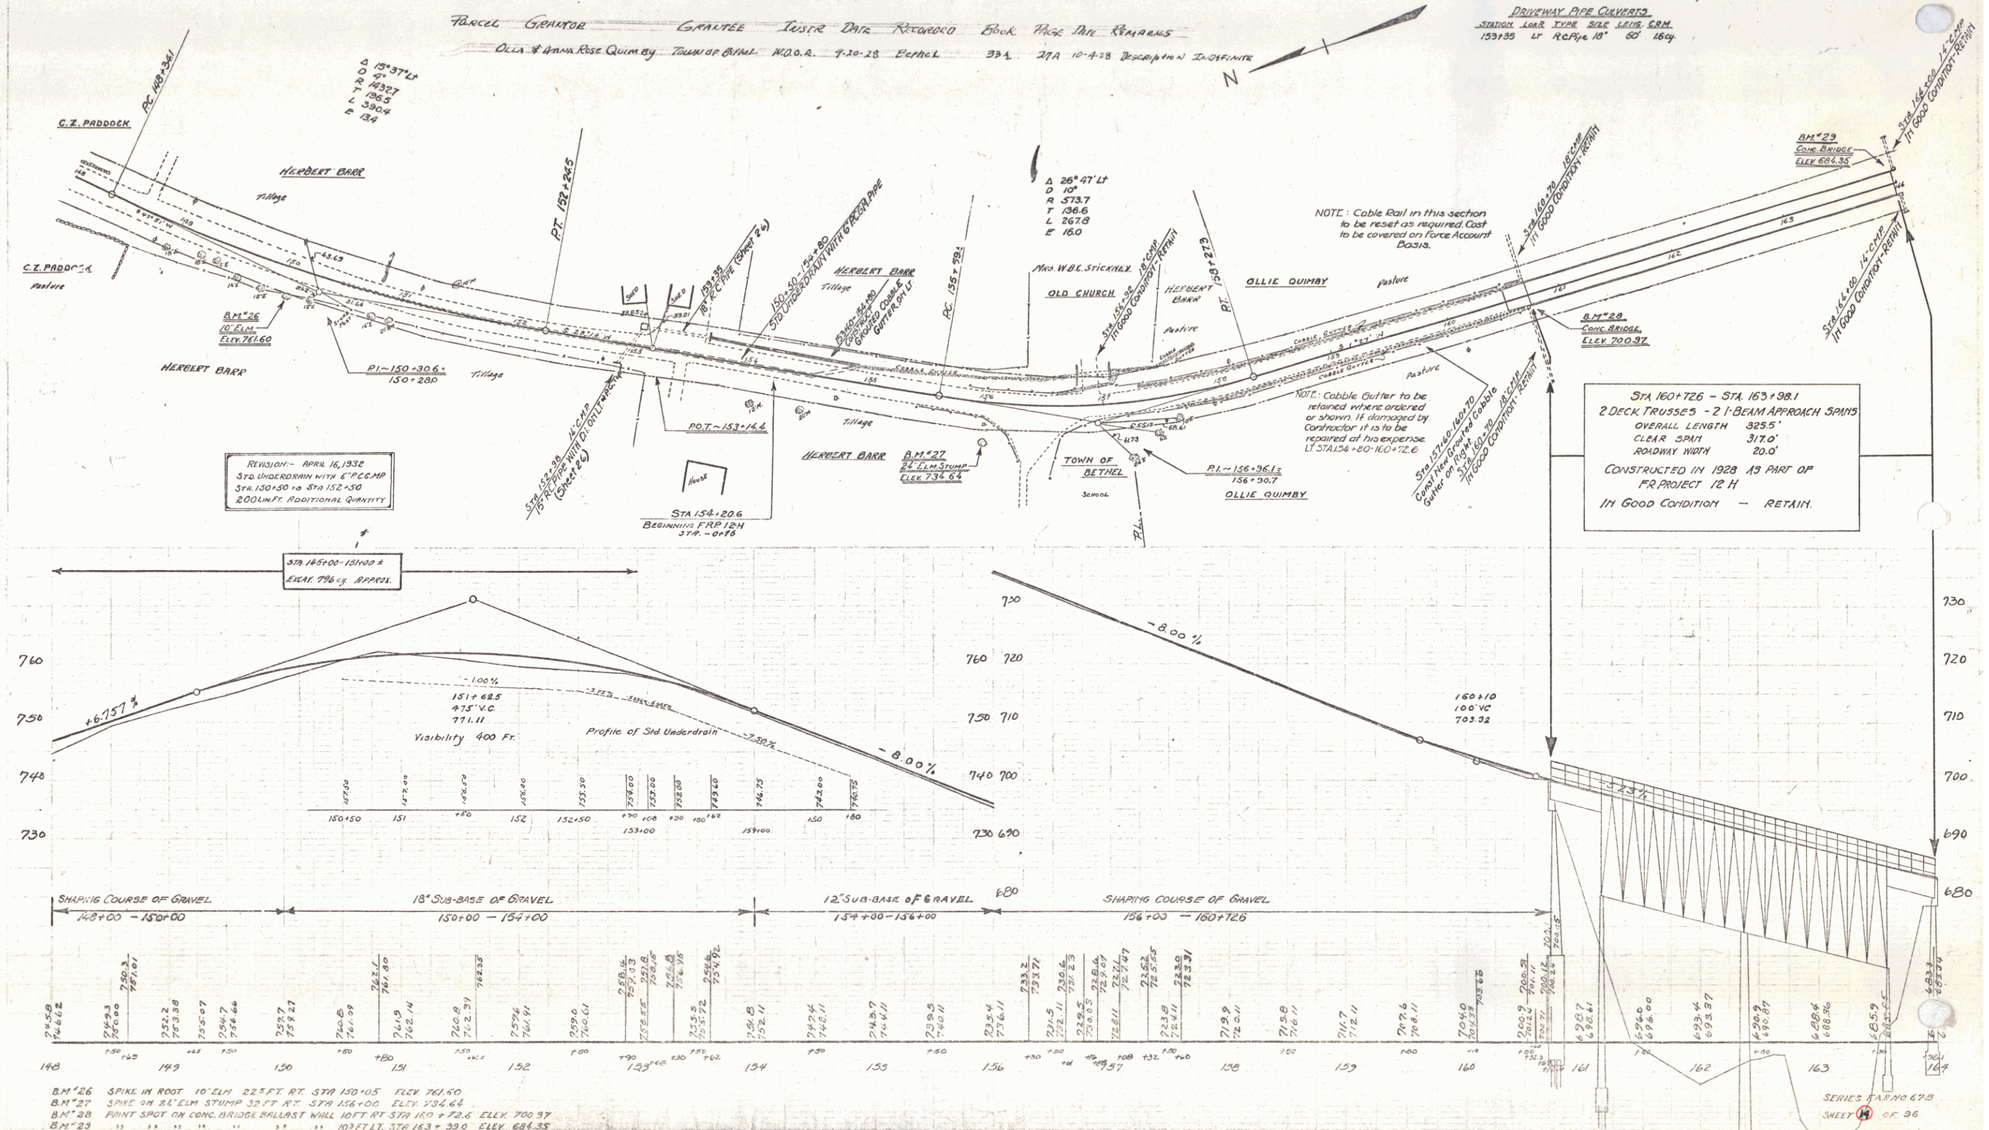

12