FED. ROAD DIST. NO.	STATE	PROJECT NO.	FISCAL YEAR	SHEET NO.	TOTAL SHEETS
1	VT.	F.A. 12 H	1928	9	39

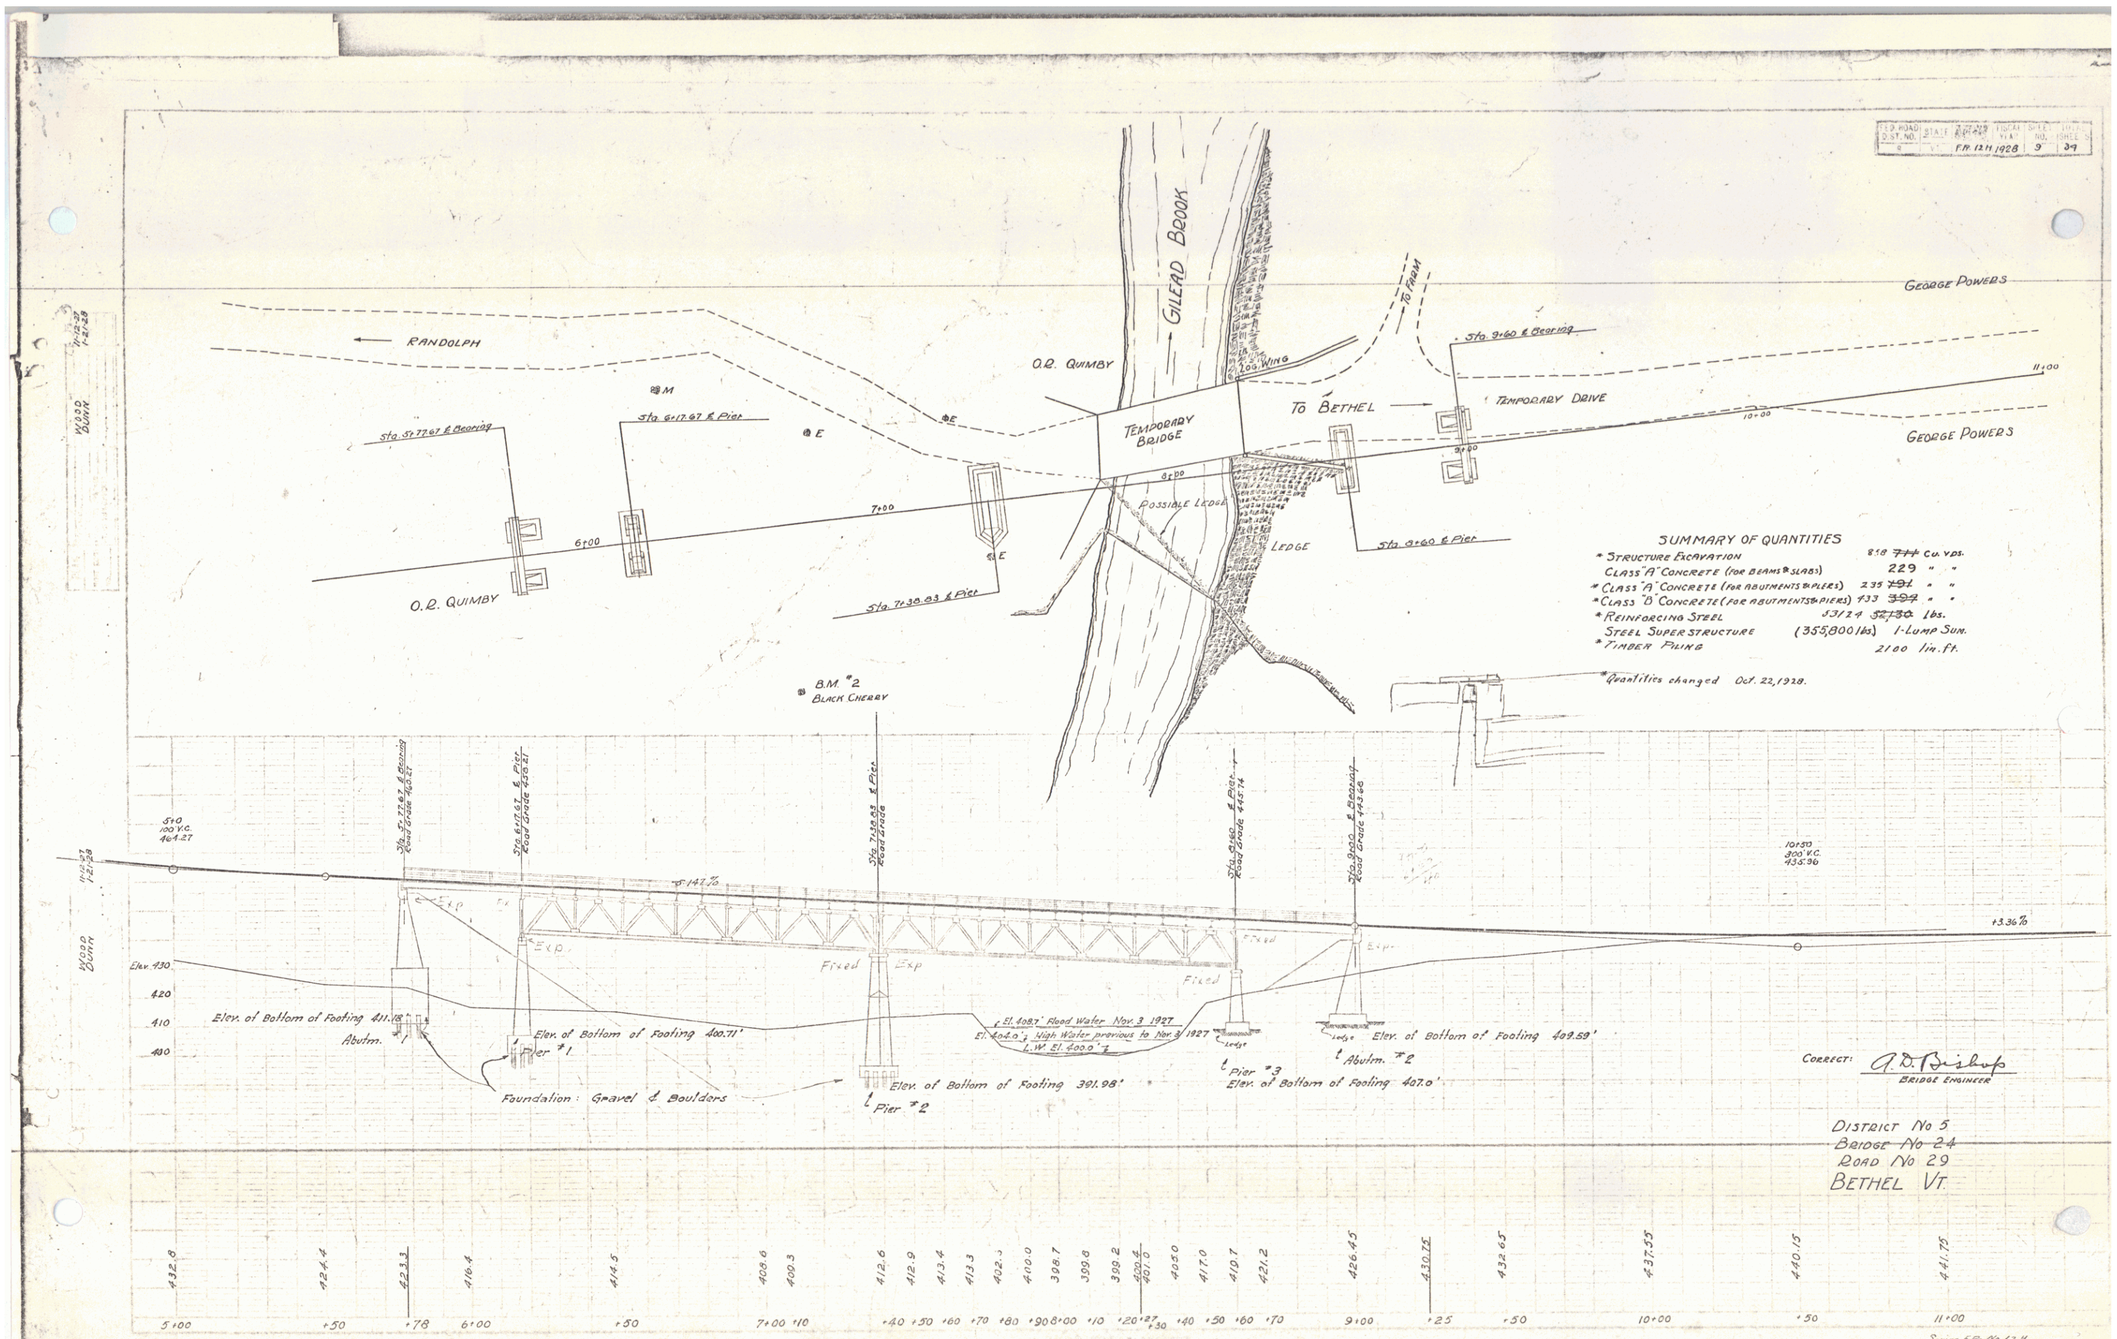

SUMMARY OF QUANTITIES

* Structure Excavation	818 ~~774~~ Cu. Yds.
Class "A" Concrete (for beams & slabs)	229 " "
* Class "A" Concrete (for abutments & piers)	235 ~~191~~ " "
* Class "B" Concrete (for abutments & piers)	433 ~~397~~ " "
* Reinforcing Steel	53124 ~~52730~~ lbs.
Steel Superstructure	(355,800 lbs.) 1-Lump Sum.
* Timber Piling	2100 lin. ft.

* Quantities changed Oct. 22, 1928.