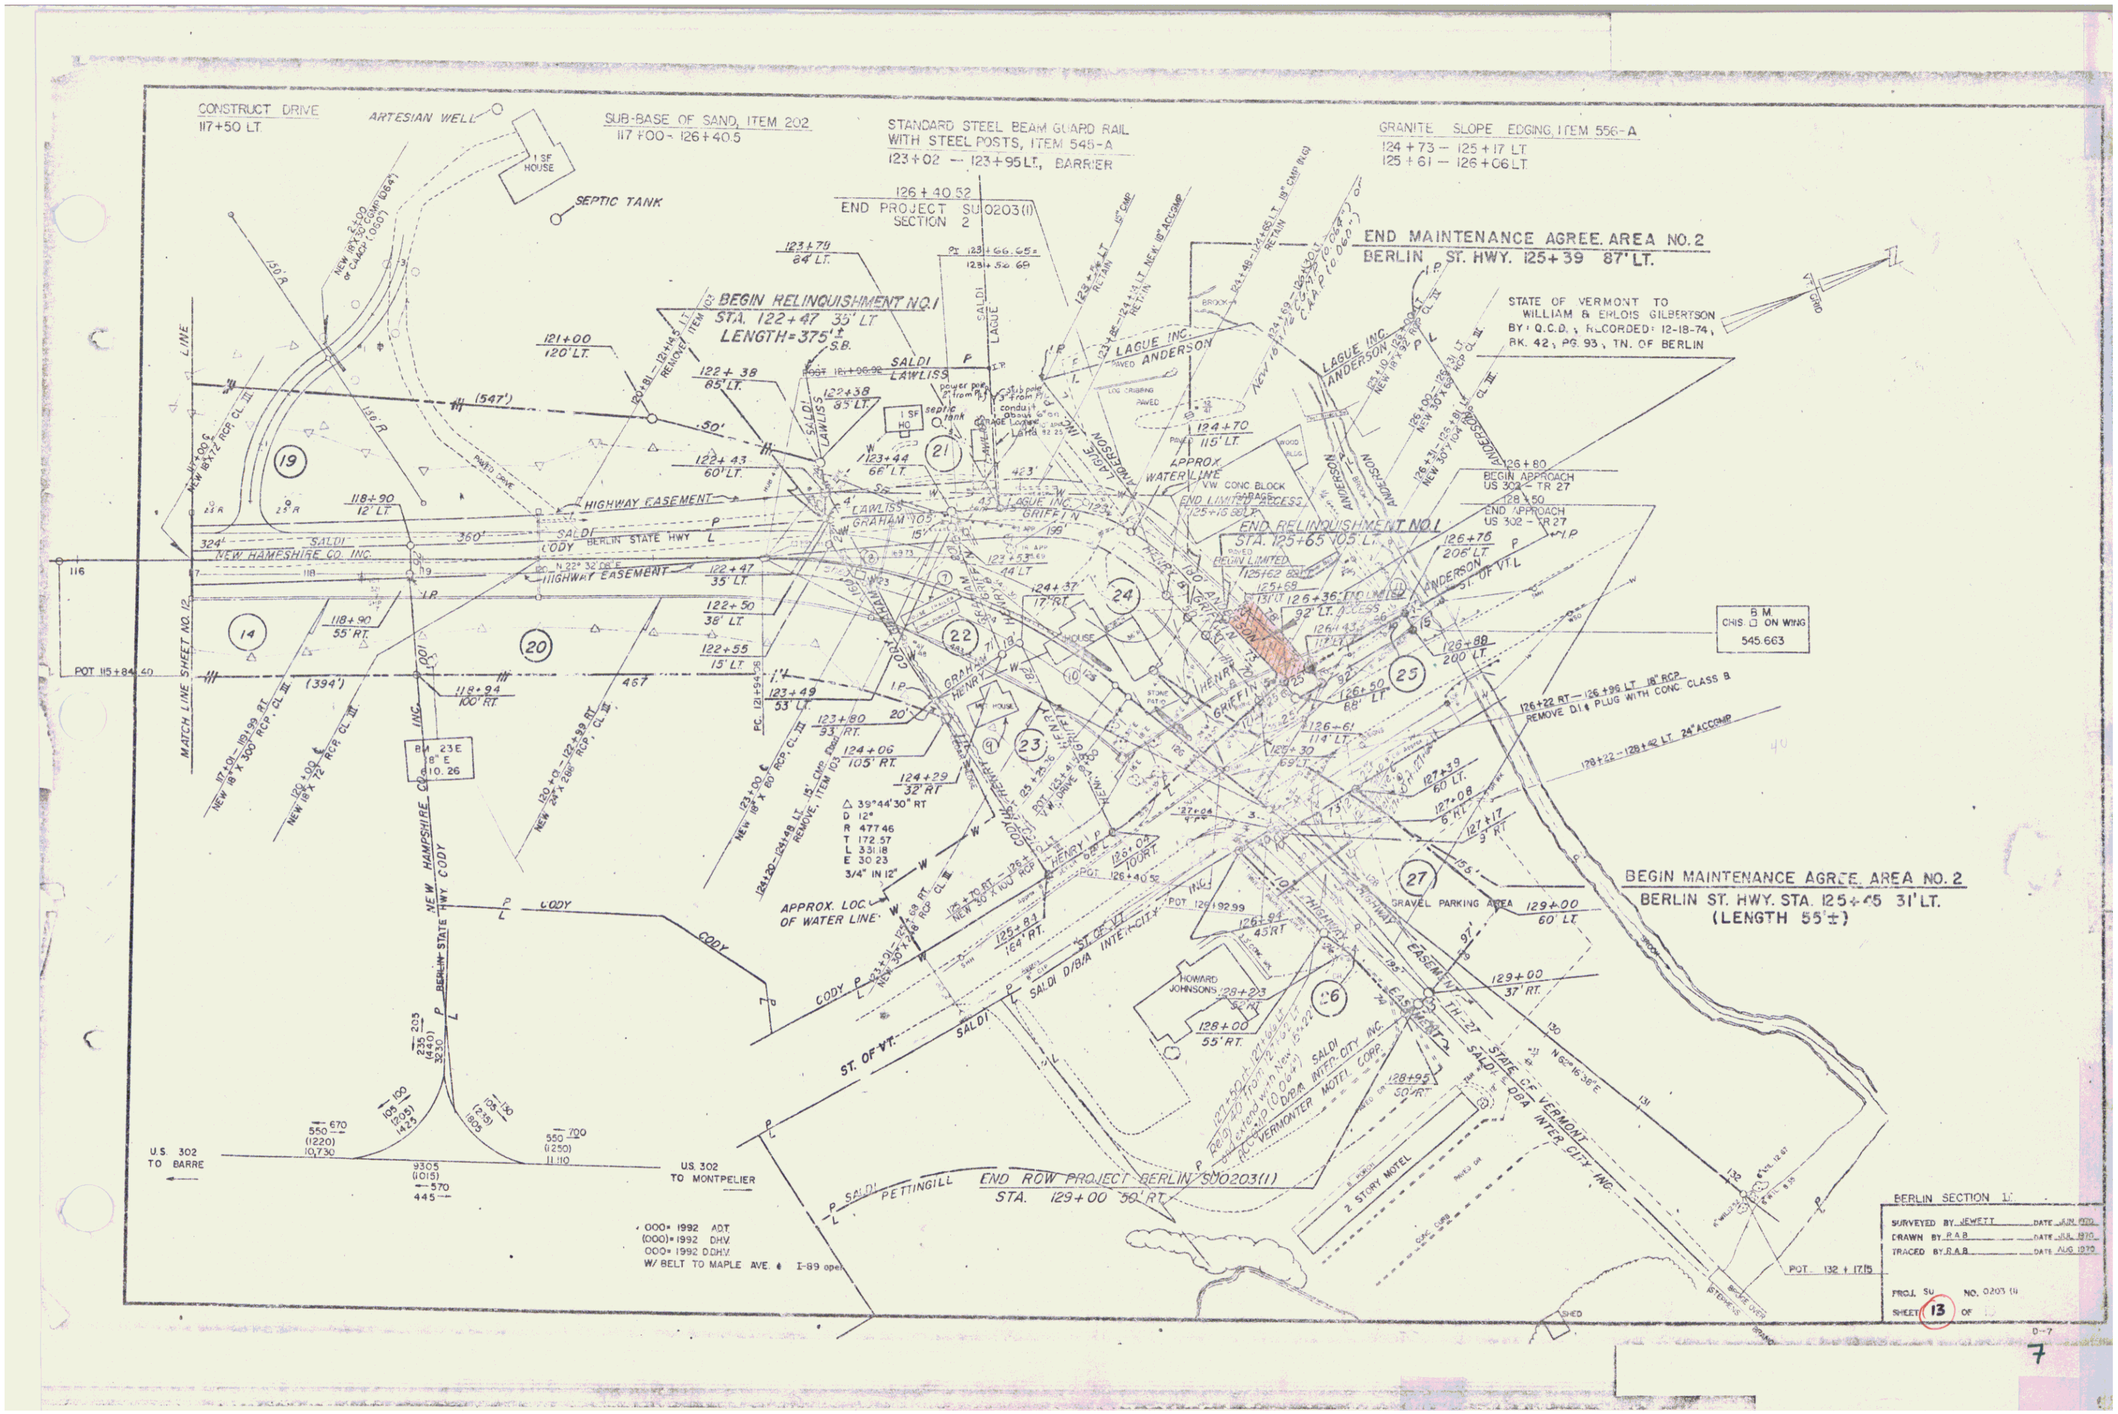
CONSTRUCT DRIVE
117+50 LT.
ARTESIAN WELL
SEPTIC TANK
SUB-BASE OF SAND, ITEM 202
117+00 - 126+40.5
STANDARD STEEL BEAM GUARD RAIL
WITH STEEL POSTS, ITEM 545-A
123+02 — 123+95 LT., BARRIER
GRANITE SLOPE EDGING, ITEM 556-A
124+73 — 125+17 LT
125+61 — 126+06 LT
126+40.52
END PROJECT SU 0203(1)
SECTION 2
END MAINTENANCE AGREE. AREA NO. 2
BERLIN ST. HWY. 125+39 87' LT.
STATE OF VERMONT TO
WILLIAM & ERLOIS GILBERTSON
BY: Q.C.D., RECORDED: 12-18-74,
BK. 42, PG. 93, TN. OF BERLIN
BEGIN RELINQUISHMENT NO. 1
STA. 122+47 35' LT
LENGTH=375'±
END RELINQUISHMENT NO. 1
STA. 125+65 105' LT.
BEGIN APPROACH
US 302 - TR 27
END APPROACH
US 302 - TR 27
B.M.
CHIS. □ ON WING
545.663
BEGIN MAINTENANCE AGREE. AREA NO. 2
BERLIN ST. HWY. STA. 125+45 31' LT.
(LENGTH 55'±)
GRAVEL PARKING AREA
HOWARD JOHNSONS
2 STORY MOTEL
END ROW PROJECT BERLIN SU0203(1)
STA. 129+00 50' RT.
APPROX. LOC. OF WATER LINE
MATCH LINE SHEET NO. 12
NEW HAMPSHIRE CO. INC.
HIGHWAY EASEMENT
BERLIN STATE HWY
U.S. 302
TO BARRE
U.S. 302
TO MONTPELIER
BERLIN SECTION 1
SURVEYED BY JEWETT
DRAWN BY R.A.B.
TRACED BY R.A.B.
PROJ. SU NO. 0203 (1)
SHEET 13 OF
7