| PARCEL | INSTRUMENT | DATE | GRANTOR | GRANTEE | RECORDED LOWELL BOOK | PAGE | DATE | REMARKS |
|---|---|---|---|---|---|---|---|---|
| #3 A | W.D.O.E. | 8-30-46 | A.M. & IDEL BONNEAU | ST. OF VT. | 21 | 121 | 10-10-46 | |

79(B) 1946 6 117

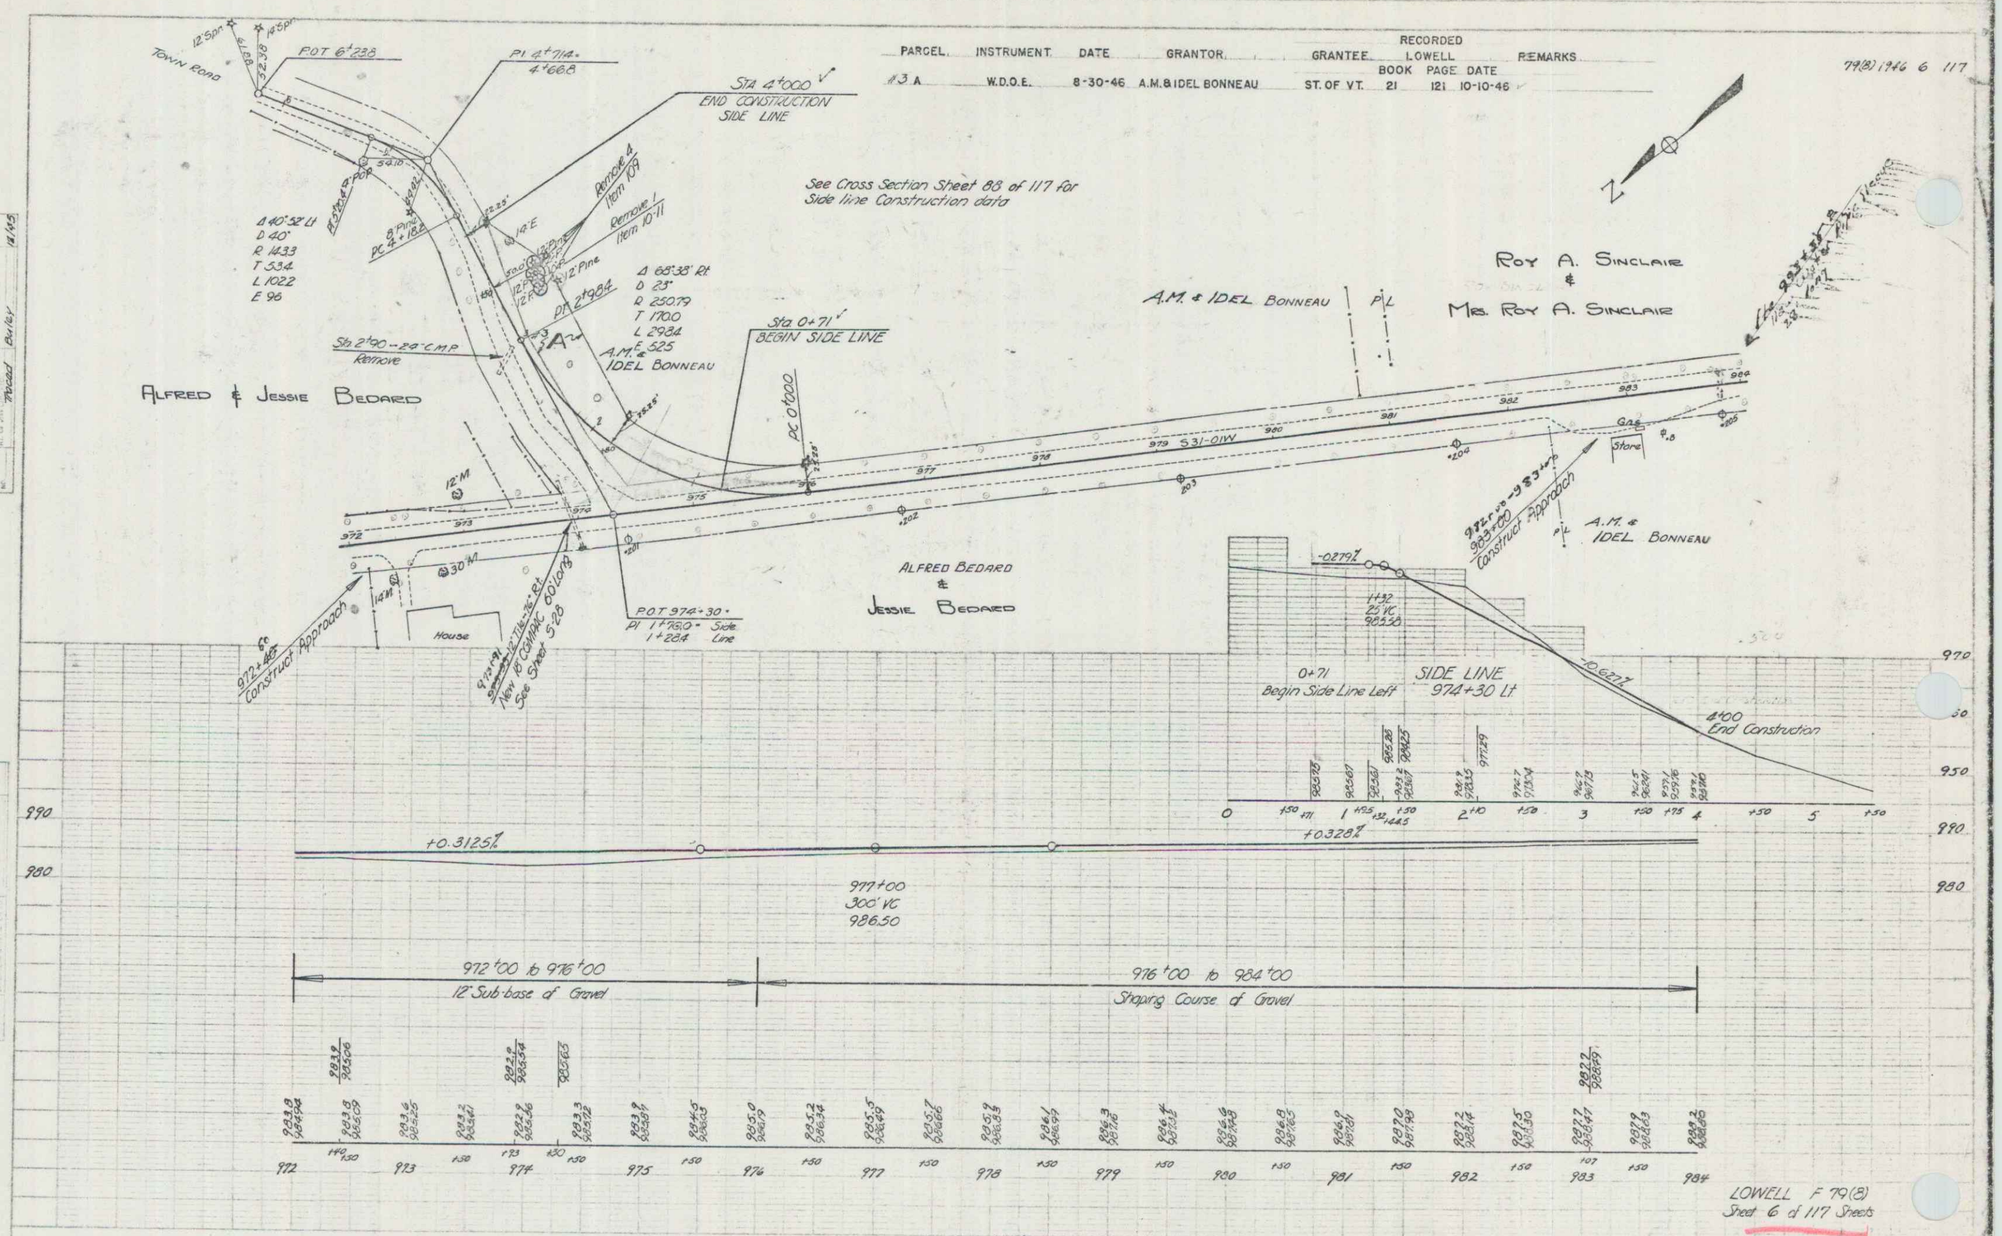


LOWELL F 79(B)
Sheet 6 of 117 Sheets

4