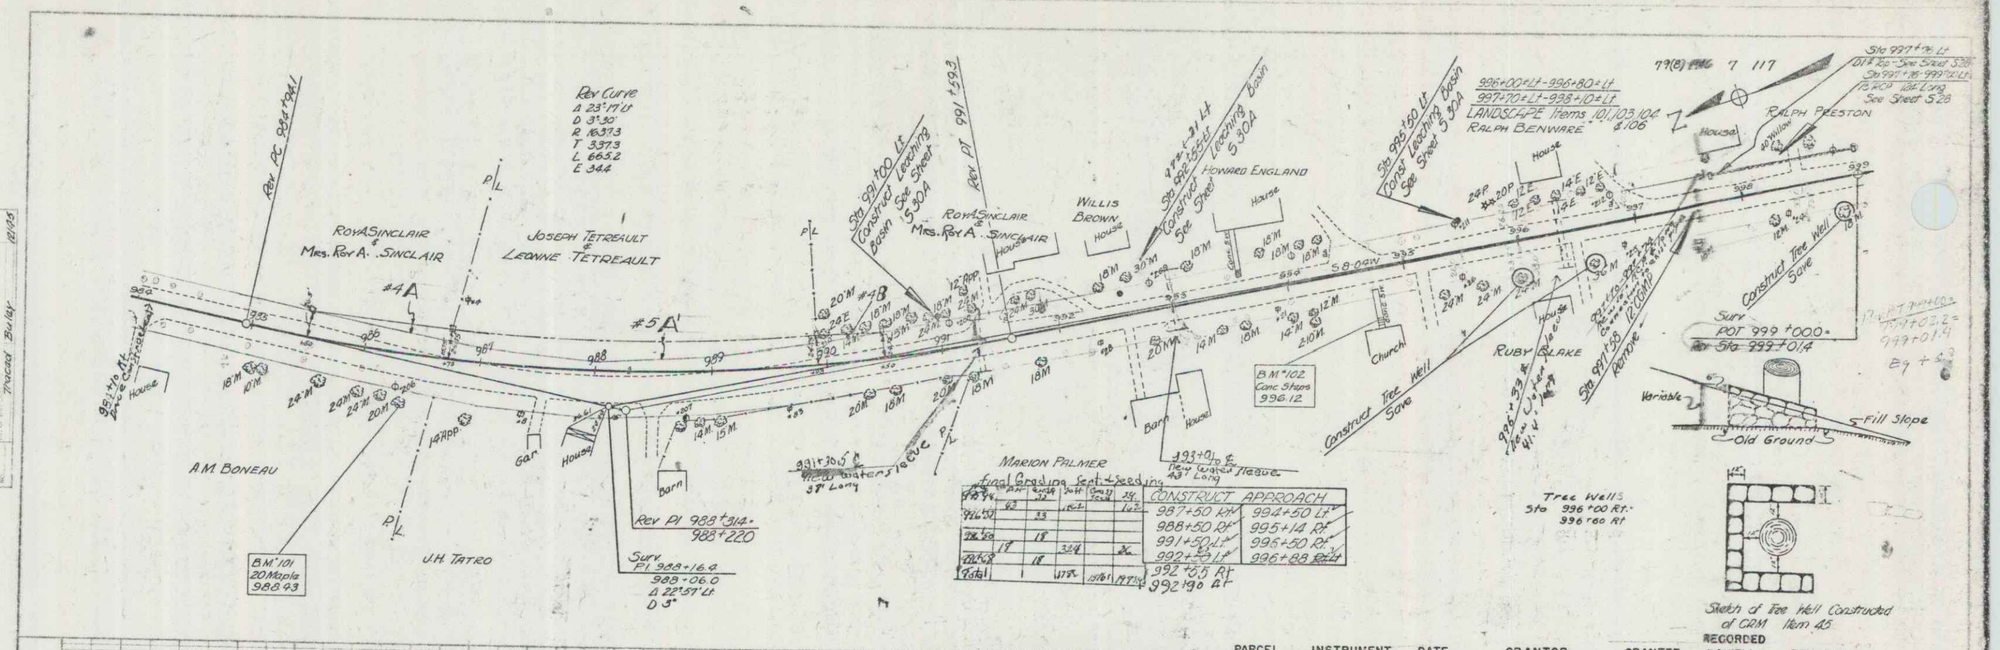

PARCEL	INSTRUMENT	DATE	GRANTOR	GRANTEE	RECORDED LOWELL BOOK	PAGE	DATE	REMARKS
#4 A&B	W.D.O.E.	9-23-46	ROY A. & DELLA S. SINCLAIR	ST. OF VT.		127	10-10-46	
#5 A'	W.D.O.E.	9-3-46	JOSEPH & LEONNE TETREAULT	ST. OF VT.		123	10-10-46	