PARCEL	INSTRUMENT	DATE	GRANTOR	GRANTEE	RECORDED LOWELL BOOK	PAGE	DATE	REMARKS
# 5 A	W.D.O.E.	9-23-46	BARTON B. & JANE L. HOADLEY	ST. OF VT.	21	131	10-10-46	

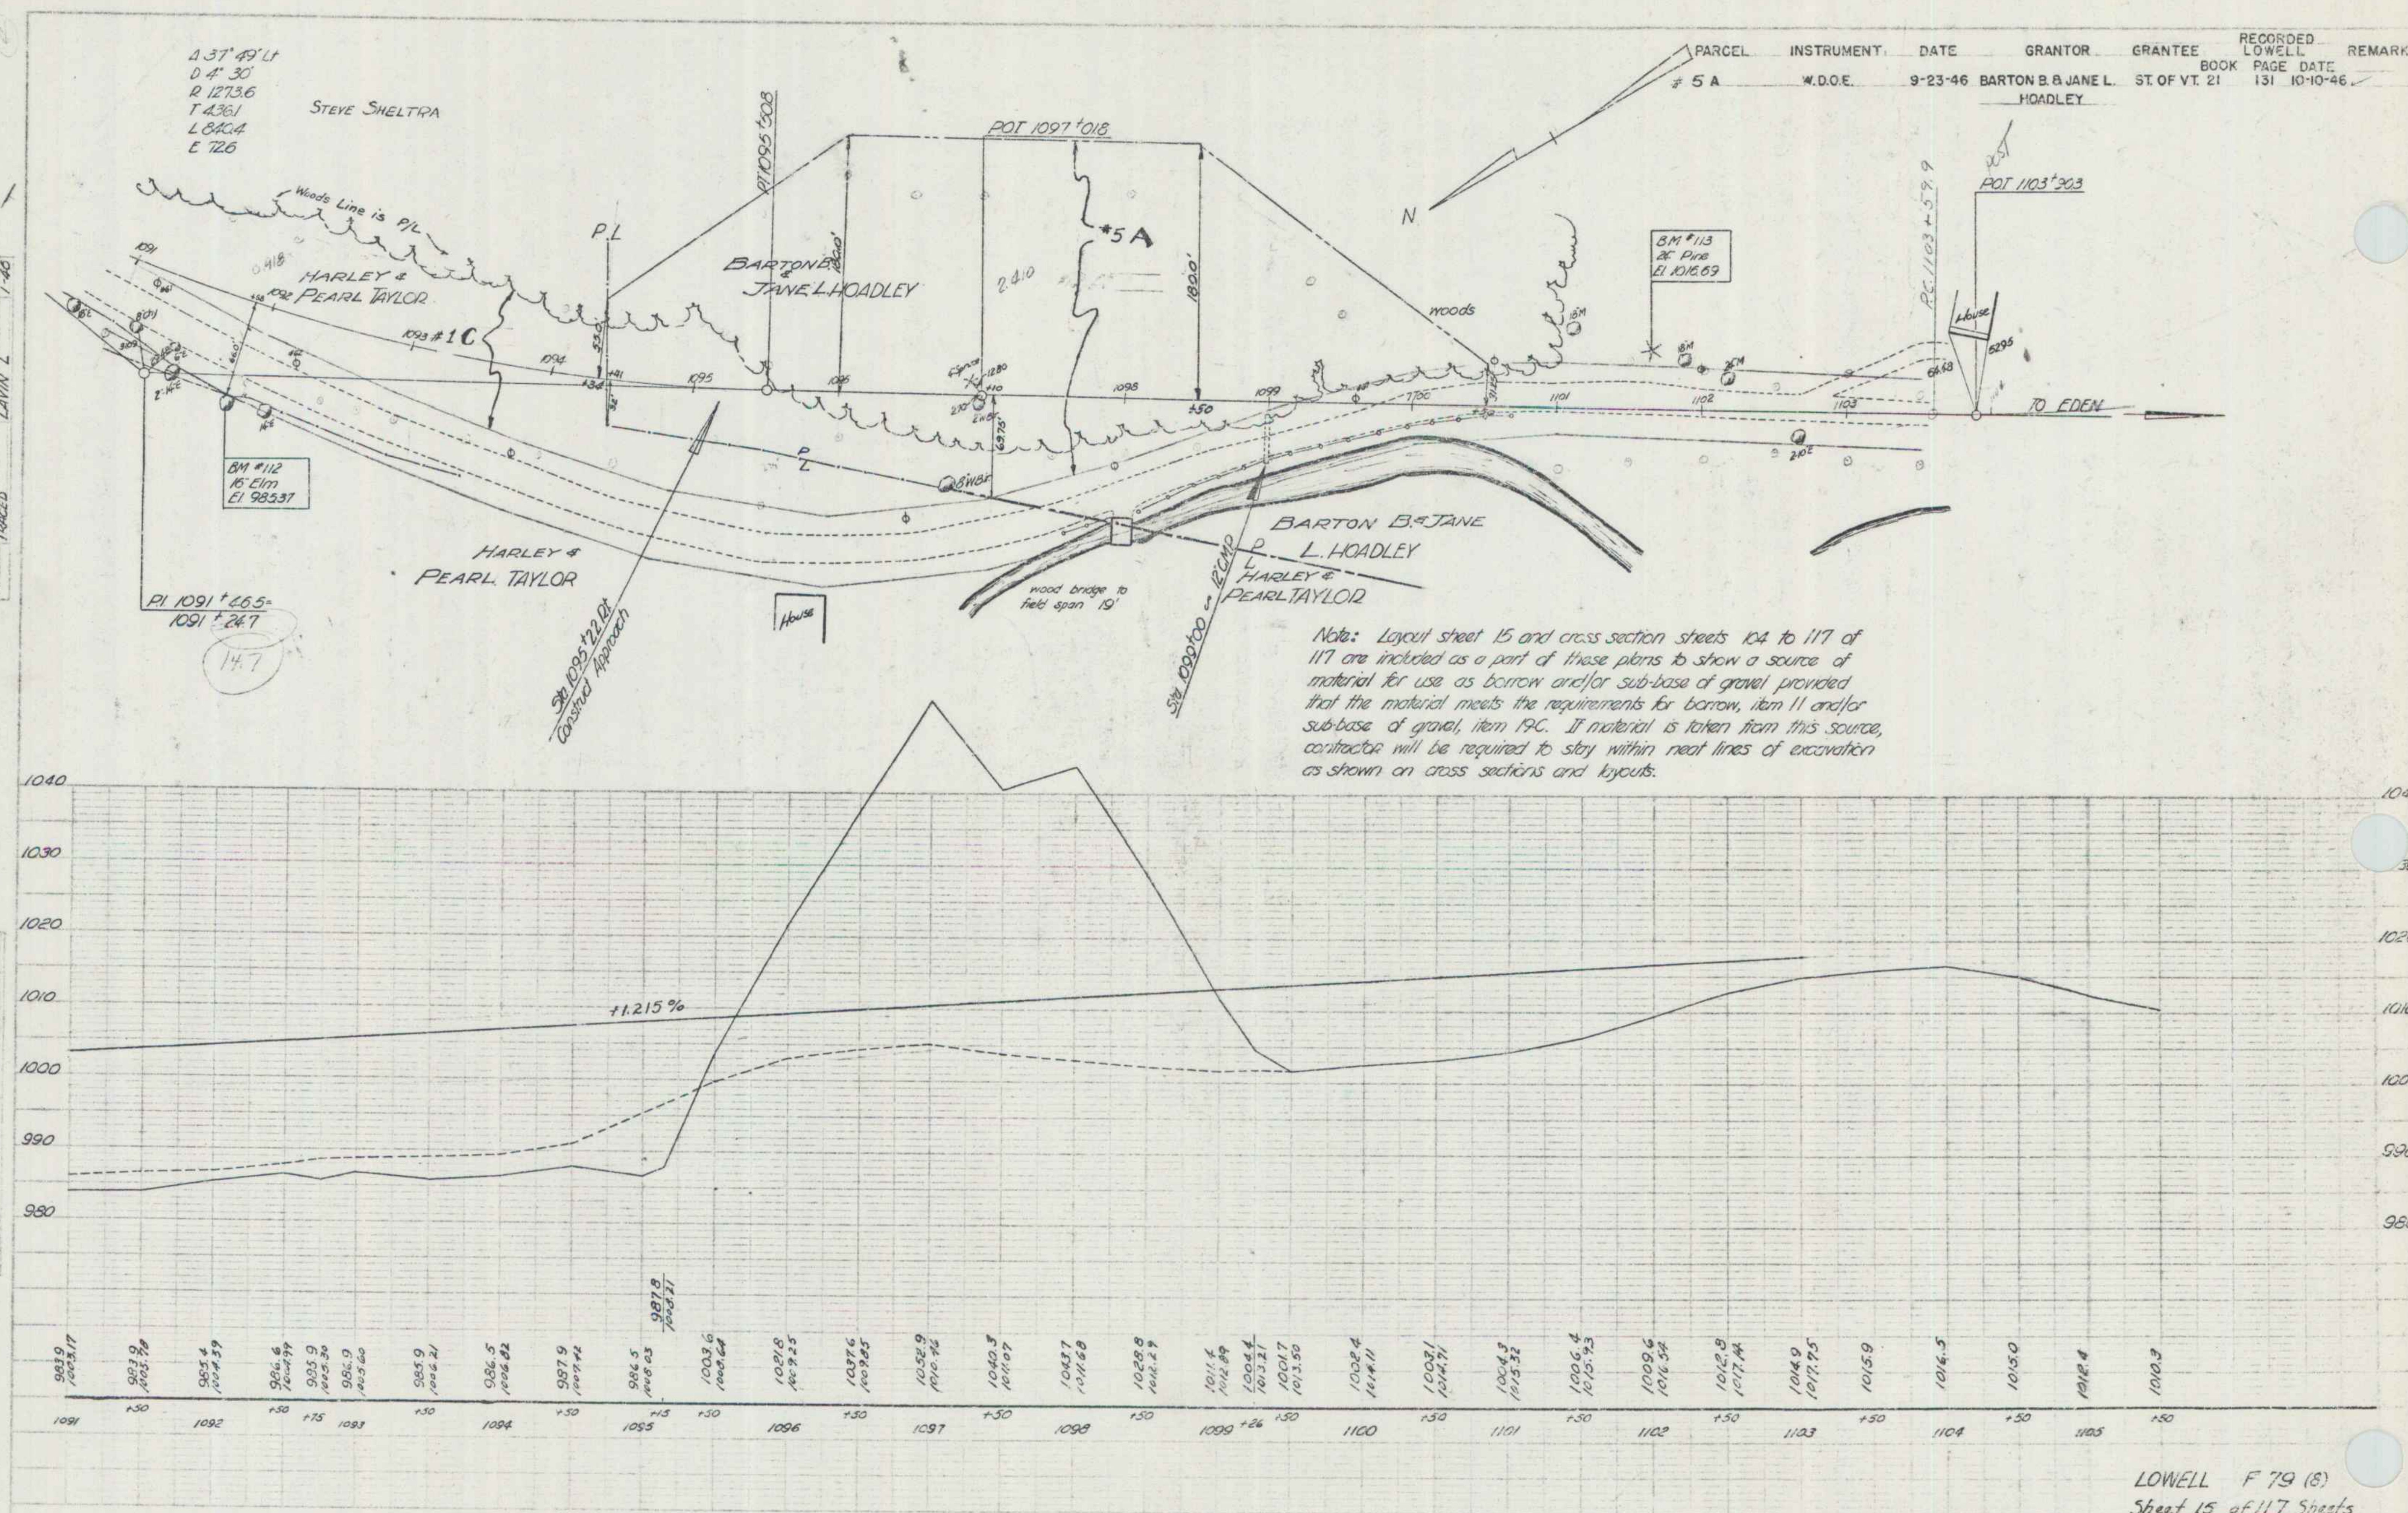

Note: Layout sheet 15 and cross section sheets 104 to 117 of 117 are included as a part of these plans to show a source of material for use as borrow and/or sub-base of gravel provided that the material meets the requirements for borrow, item 11 and/or sub-base of gravel, item 19C. If material is taken from this source, contractor will be required to stay within neat lines of excavation as shown on cross sections and layouts.