POOR ORIGINAL COPY

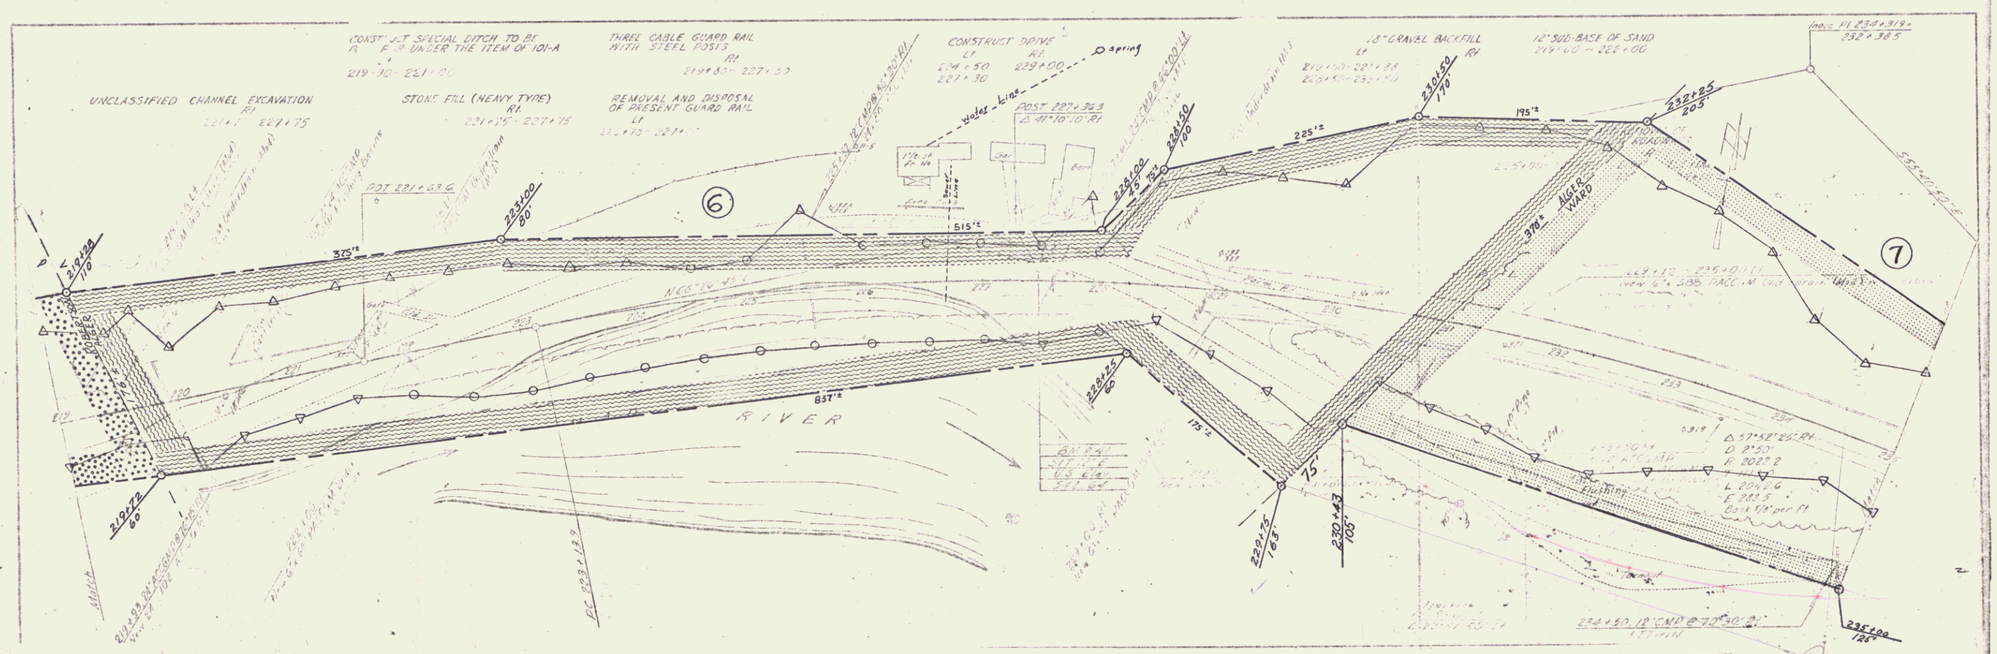

VERMONT DEPARTMENT OF HIGHWAYS
RIGHT-OF-WAY PLANS
PROJECT: MORETOWN
No. S 0167(3)
SHEET 11 OF 16

6