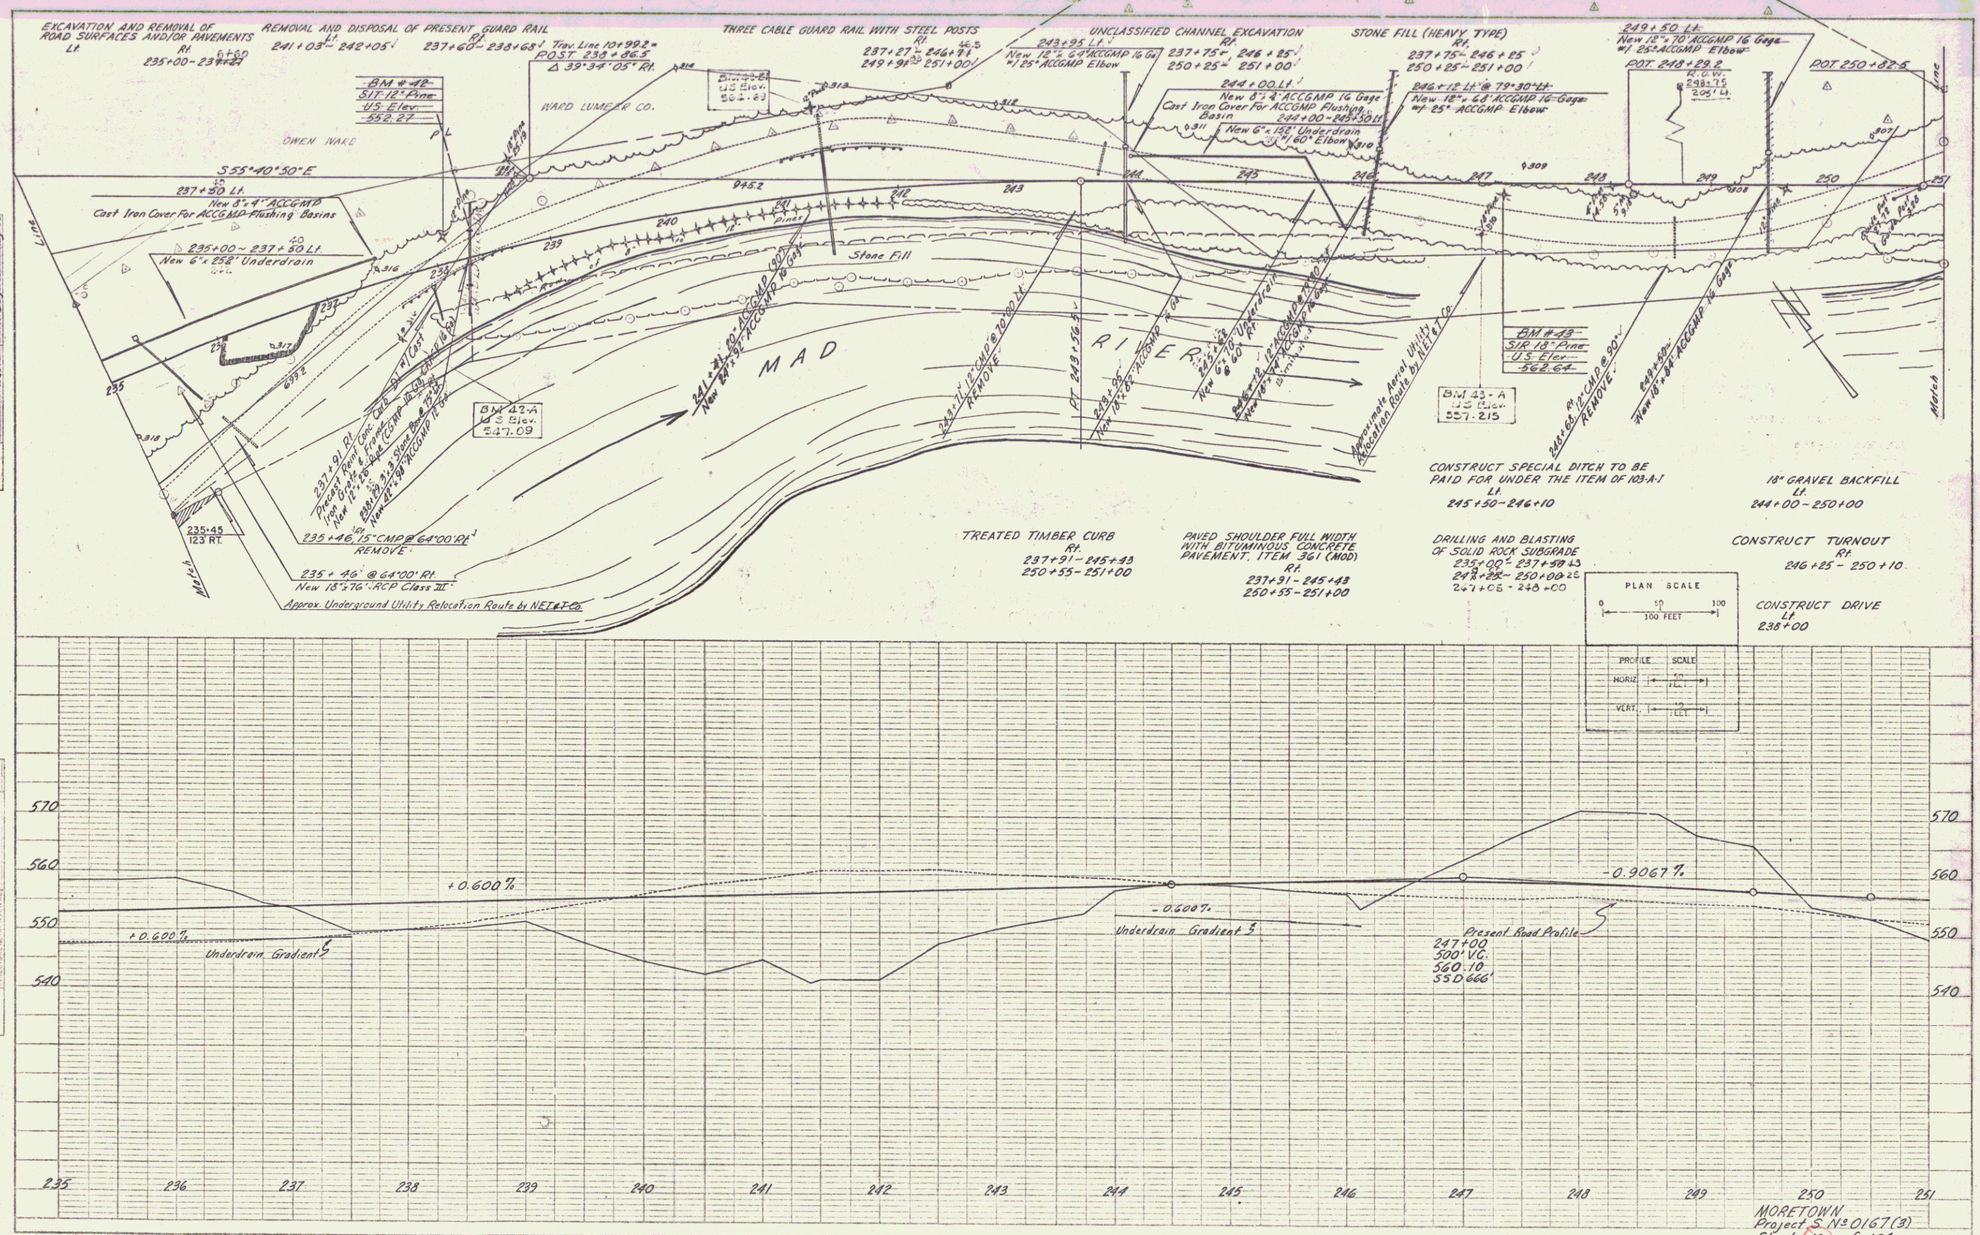

PLATE 1 PLAN-PROFILE D.P.W. & N.E. STANDARD
HOUSTON & HEELEY CO. NEW YORK