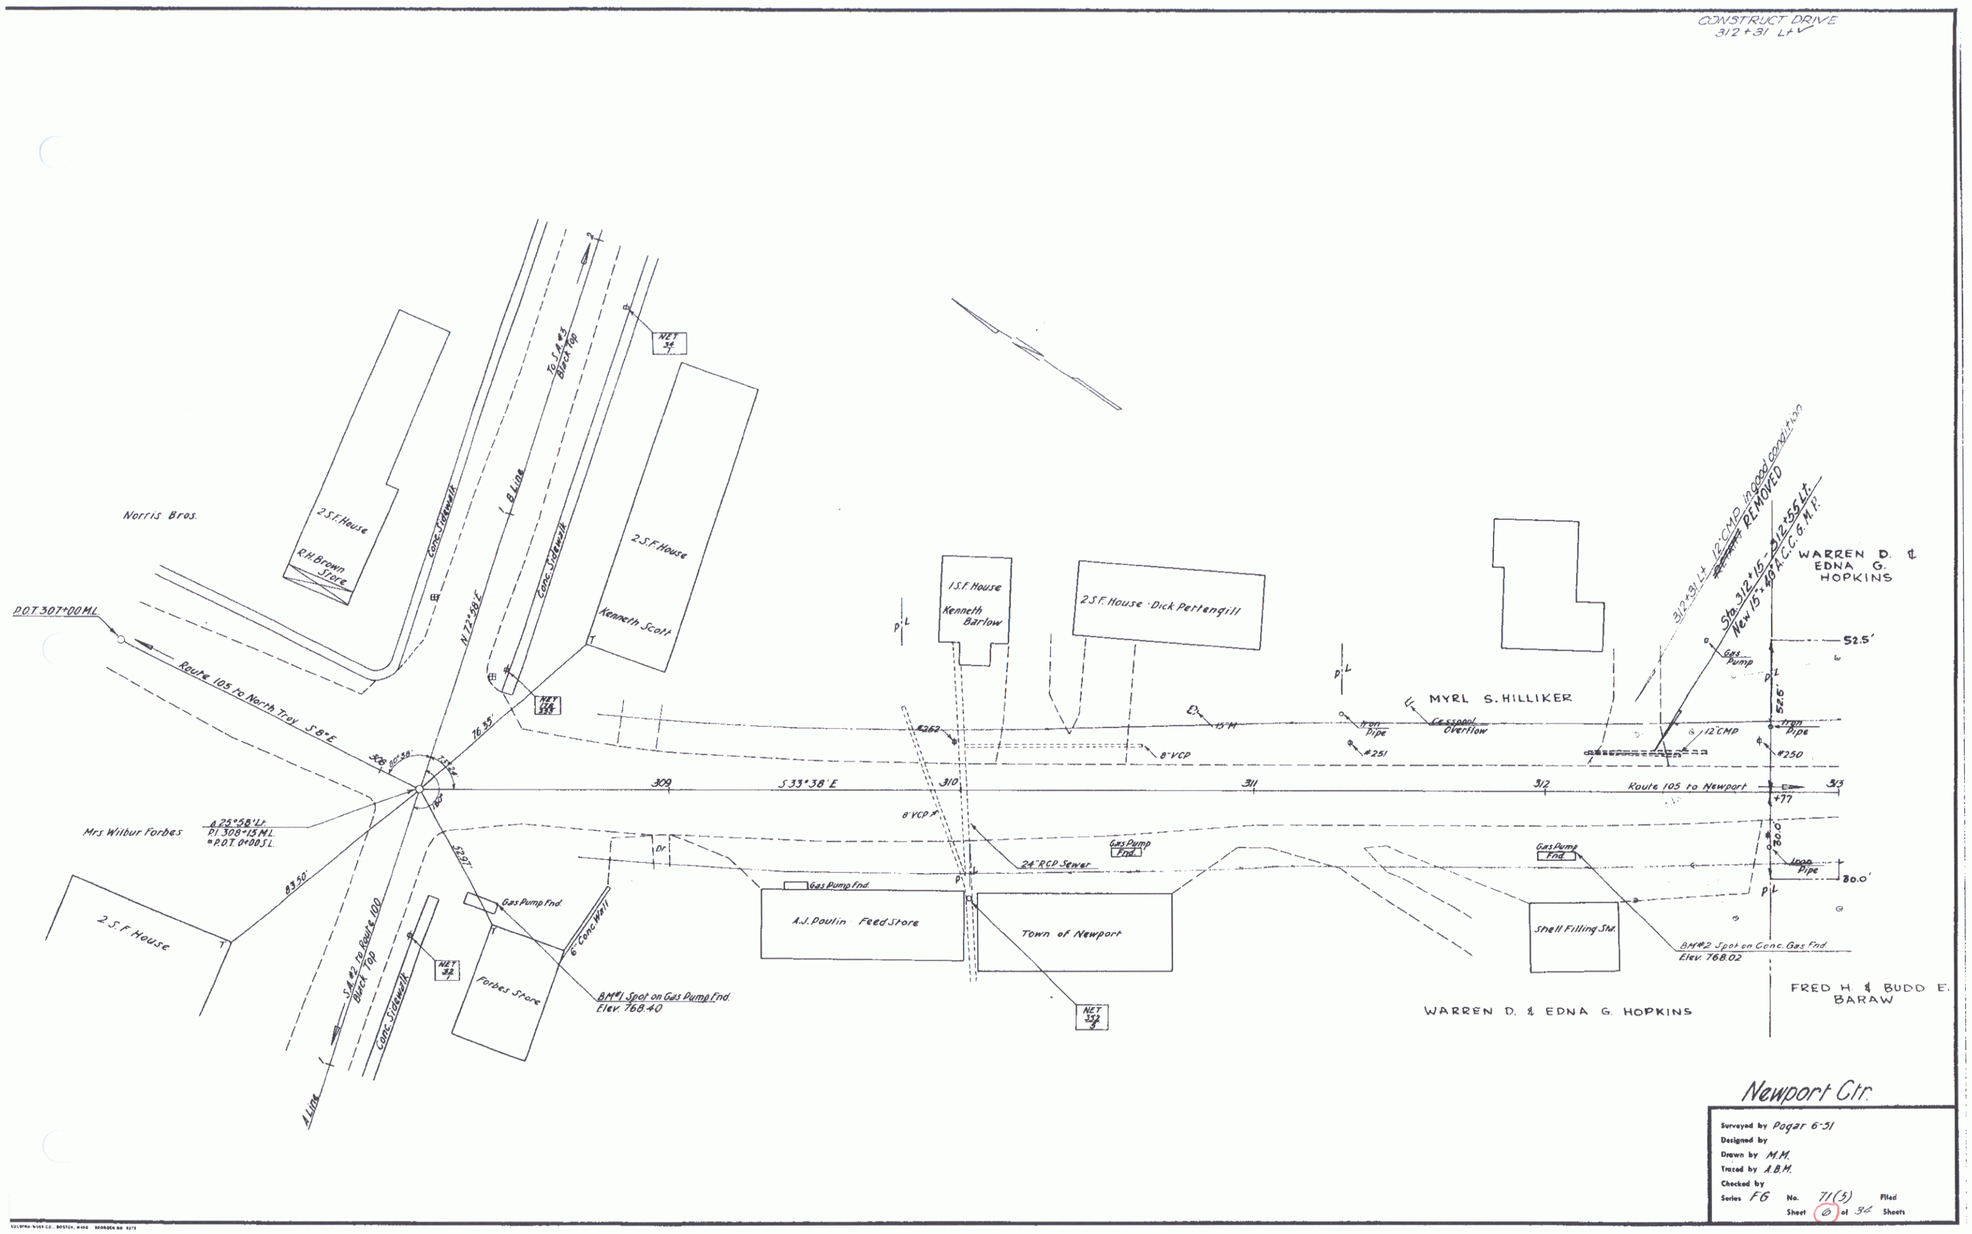
CONSTRUCT DRIVE
312+31 Lt
Norris Bros.
2 S.F. House
R.H. Brown Store
Conc. Sidewalk
B.L.I.C.R.
To I.R.R. Black Top
2 S.F. House
Kenneth Scott
NET 34
NET 33
P.O.T. 307+00 ML
Route 105 to North Troy S 8° E
N 72°58' E
76.35'
308
309
S 33°38' E
310
311
312
Route 105 to Newport
313
+77
Mrs. Wilbur Forbes
A. 25°58' Lt.
Bl. 308+15 ML
= P.O.T. 0+00 S.L.
83.50'
2 S.F. House
S.A.R.R. to Rock 100 Black Top
Conc. Sidewalk
B.L.I.C.R.
Gas Pump Fnd.
6" Conc. Wall
Forbes Store
BM#1 Spot on Gas Pump Fnd.
Elev. 768.40
NET 32
1 S.F. House
Kenneth Barlow
2 S.F. House - Dick Pettengill
8" VCP
24" RCP Sewer
Gas Pump Fnd.
A.J. Poulin Feed Store
Town of Newport
NET 32
MYRL S. HILLIKER
Cesspool Overflow
Iron Pipe
#251
#252
#250
12" CMP
Shell Filling Stn.
BM#2 Spot on Conc. Gas Fnd.
Elev. 768.02
WARREN D. & EDNA G. HOPKINS
312+31 Lt 12" CMP in good condition
Sta. 312+15 - 312.5 Lt.
New 15" 40 ft. C.C.G.M.P.
REMOVED
52.5'
52.6'
30.0'
Gas Pump
Iron Pipe
FRED H. & BUDD E. BARAW
Newport Ctr.
Surveyed by Pagar 6-51
Designed by
Drawn by M.M.
Traced by A.B.M.
Checked by
Series FG No. 71(3) Filed

2