One Course Cement Concrete Sidewalk, Item 560
314+~~[illegible]~~ to 316+~~[illegible]~~ Lt
~~96~~ 98
Granite Curb, Item 566.B
~~314+[illegible] 314+[illegible]~~ Rt
~~314+[illegible] 315+75~~ Rt
~~314+[illegible] 316+[illegible]~~ Lt
~~97~~ 98
Truck Drives
312+~~[illegible]~~ 312+74 Rt
313+~~[illegible]~~ Rt
314+~~[illegible]~~ Rt
310+20 Rt
1+18 Lt (Appr. 314+56.8)
Construct Approaches
314+56.8 Lt
316+50.0 Lt
Sodding, Item 612.E Topsoil, Item 621
313+~~[illegible]~~ to 314+~~[illegible]~~ Rt
314+~~[illegible]~~ to ~~[illegible]~~ Rt
~~34~~ 315+75
314+97 to 316+18 Lt

■ = Boundary Markers

NOTE: Roadway Excavation, sta 314+93.0-315+76.5, to be paid for as Channel Excavation, Item 106, to the limits of the shaded area shown on the plan.

NON-GOV'T PARTICIPATION
Install Sleeve for Water Pipe, across roadway
Item 103-A Sleeve to be furnished by Property Owner. 317+00 approx

Parcel	Instrument	Date	Grantor	Grantee	Recorded Town	Book	Page	Date	Remarks
1	WDOE	6-3-53	Fred H. & Budd E. Baraw	St. of Vt.	Newport	5	491	6-6-53	
2	WDOE	6-3-53	Warren D. & Edna G. Hopkins	"	"	5	493	6-6-53	
3	W.D.	6-3-53	Homer Coburn	"	"	5	492	6-6-53	
4	WDOE	6-3-53	Milton H. & Silverine T. Wright	"	"	5	495	6-6-53	
5	WDOE	7-23-53	Celina A. Cammett	"		6	5	8-1-53	
6	WDOE	6-3-53	Gideon T. & Josephine Rollins	"	"	5	496	6-6-53	
7	WDOE	6-3-53	Adeline L. Camber	"	"	5	490	6-6-53	

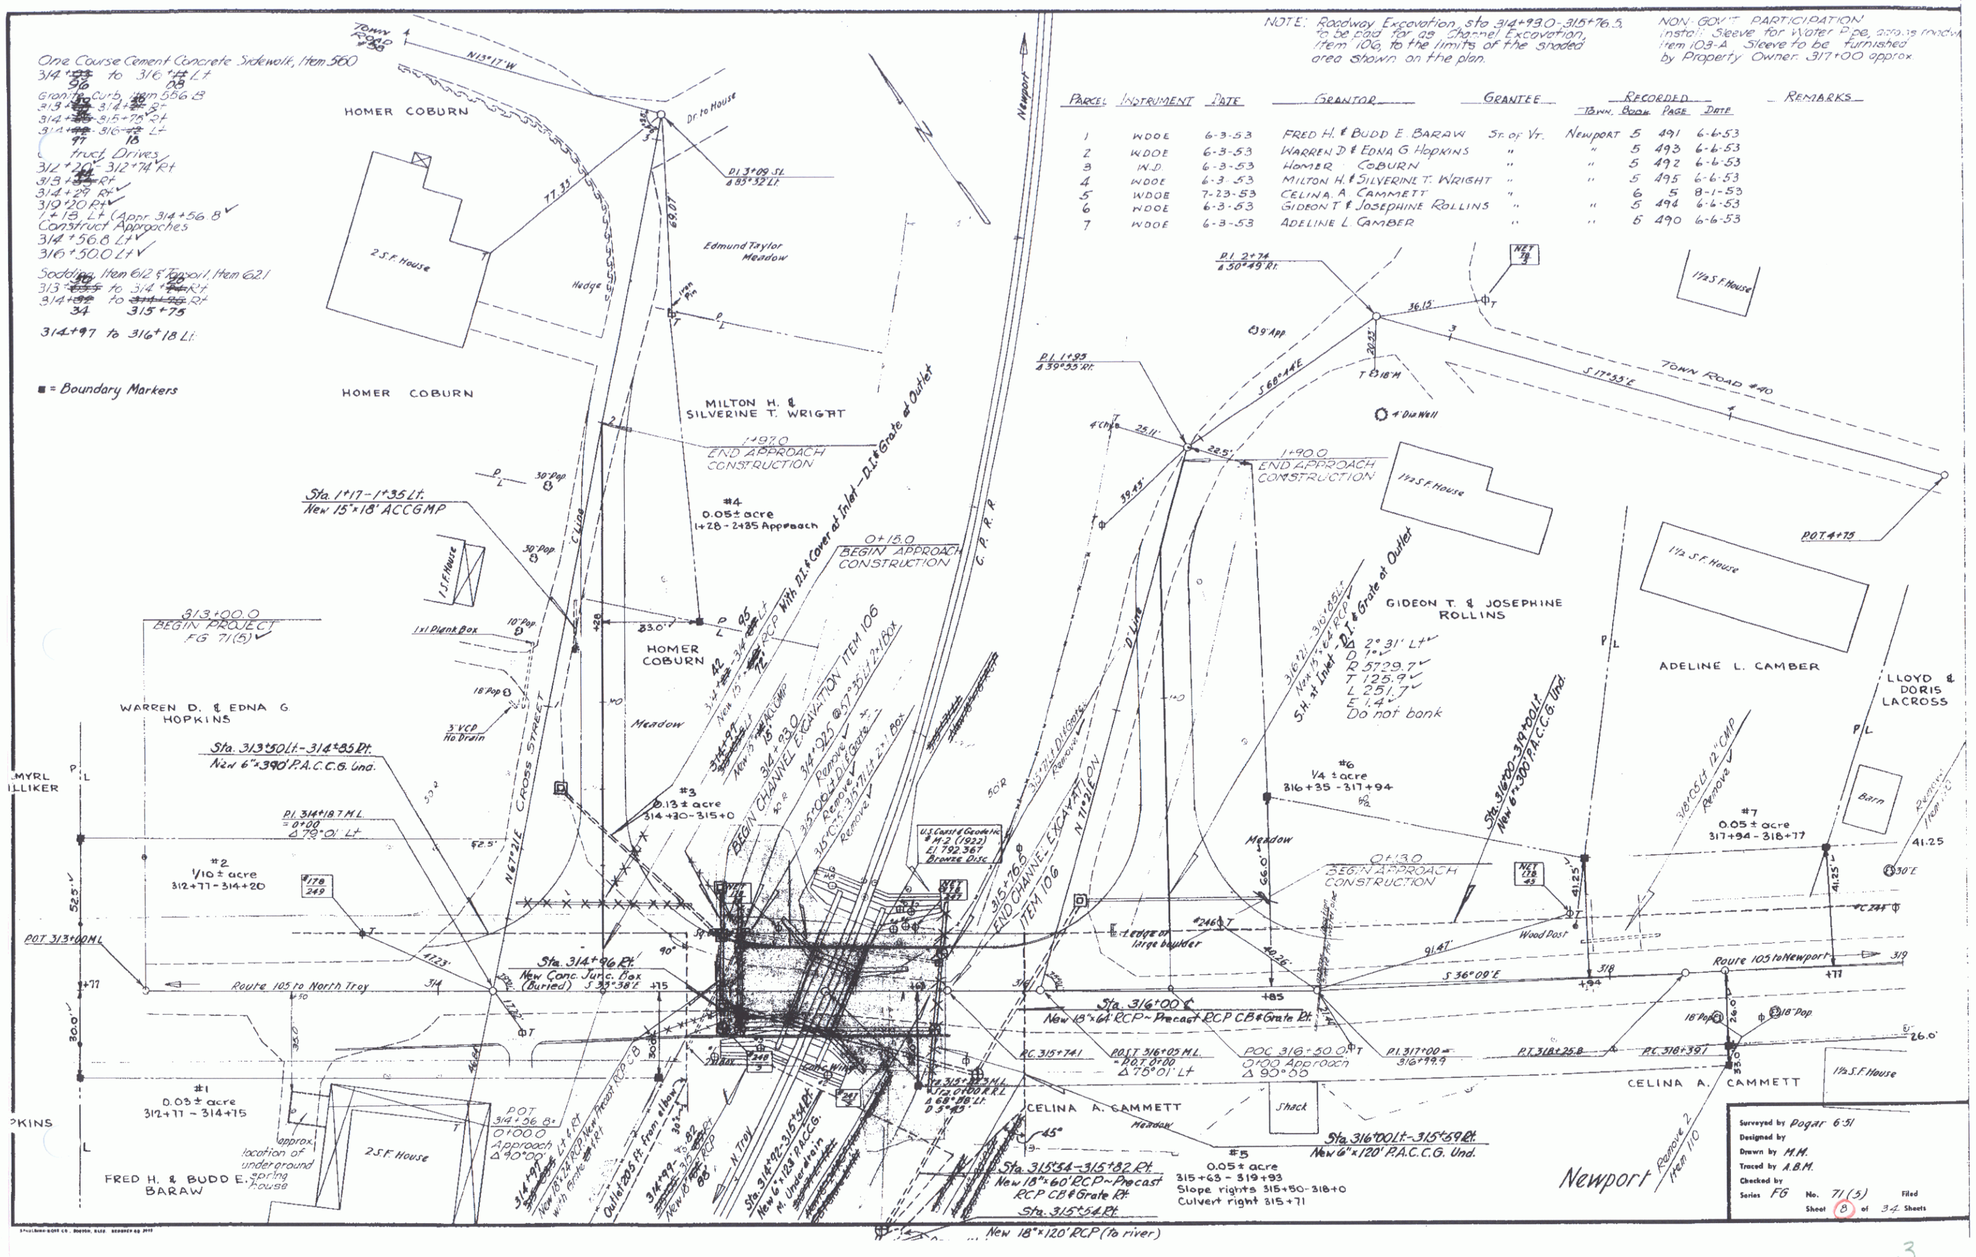

3