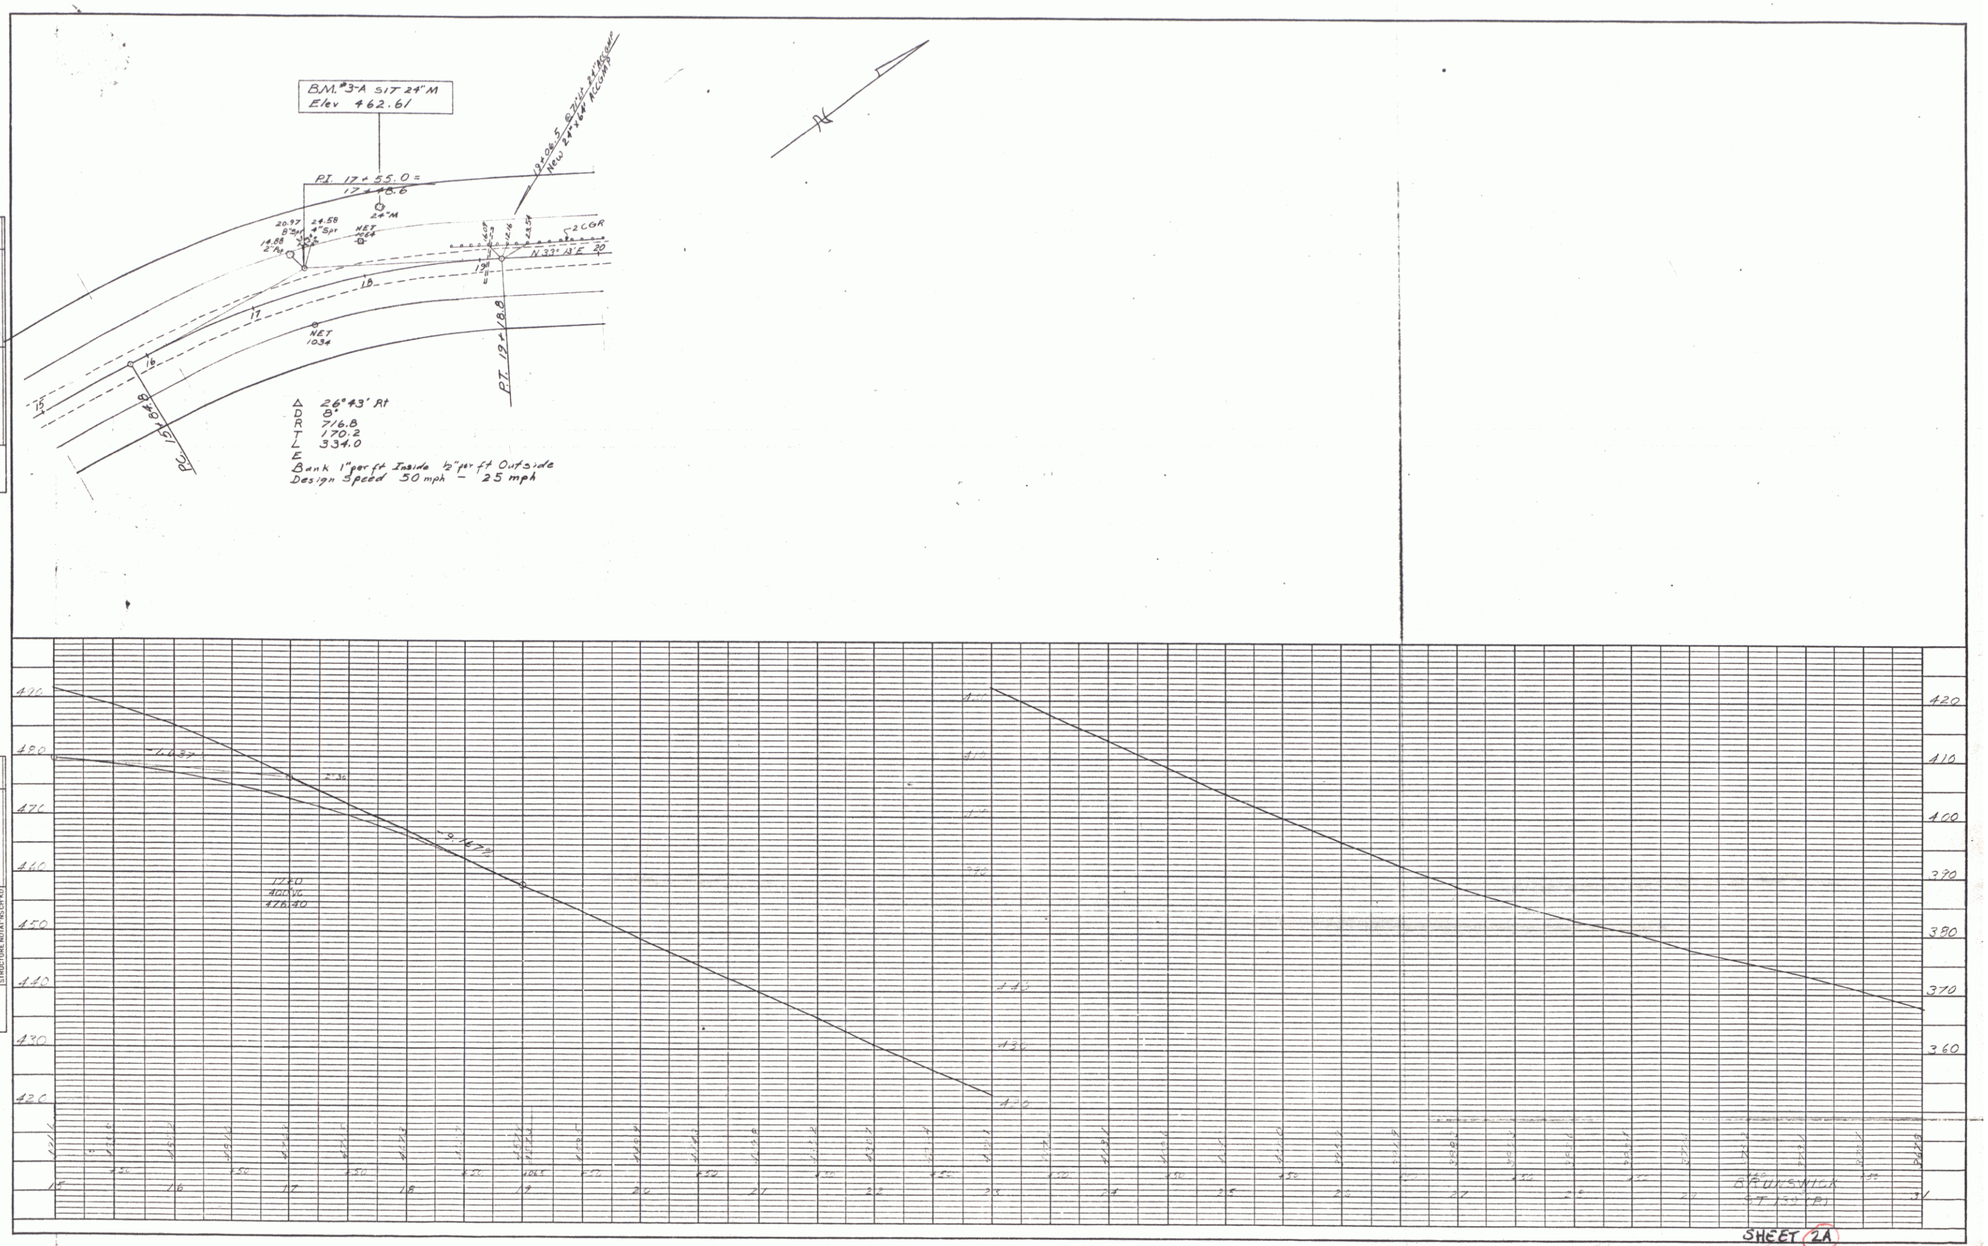

PLAN

SURVEYED		DATE
PLOTTED		
ALIGNMENT CHECKED		
RT. OF WAY CHECKED		
NOTE BOOK		BY
NO.		

PROFILE

SURVEYED		DATE
PLOTTED		
GRADES CHECKED		
STRUCTURE NOTATIONS CHKD		
NOTE BOOK		BY
NO.		

PLATE 1 - PLAN-PROFILE O.P.R.&R.E. STANDARD
KEUFFEL & ESSER CO., NEW YORK.
K & E CO. NO. 345-1 MADE IN U.S.A. 1970A