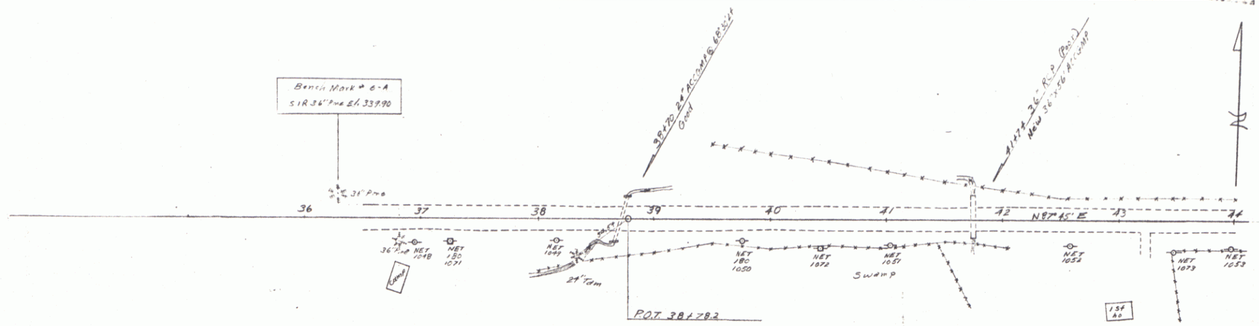

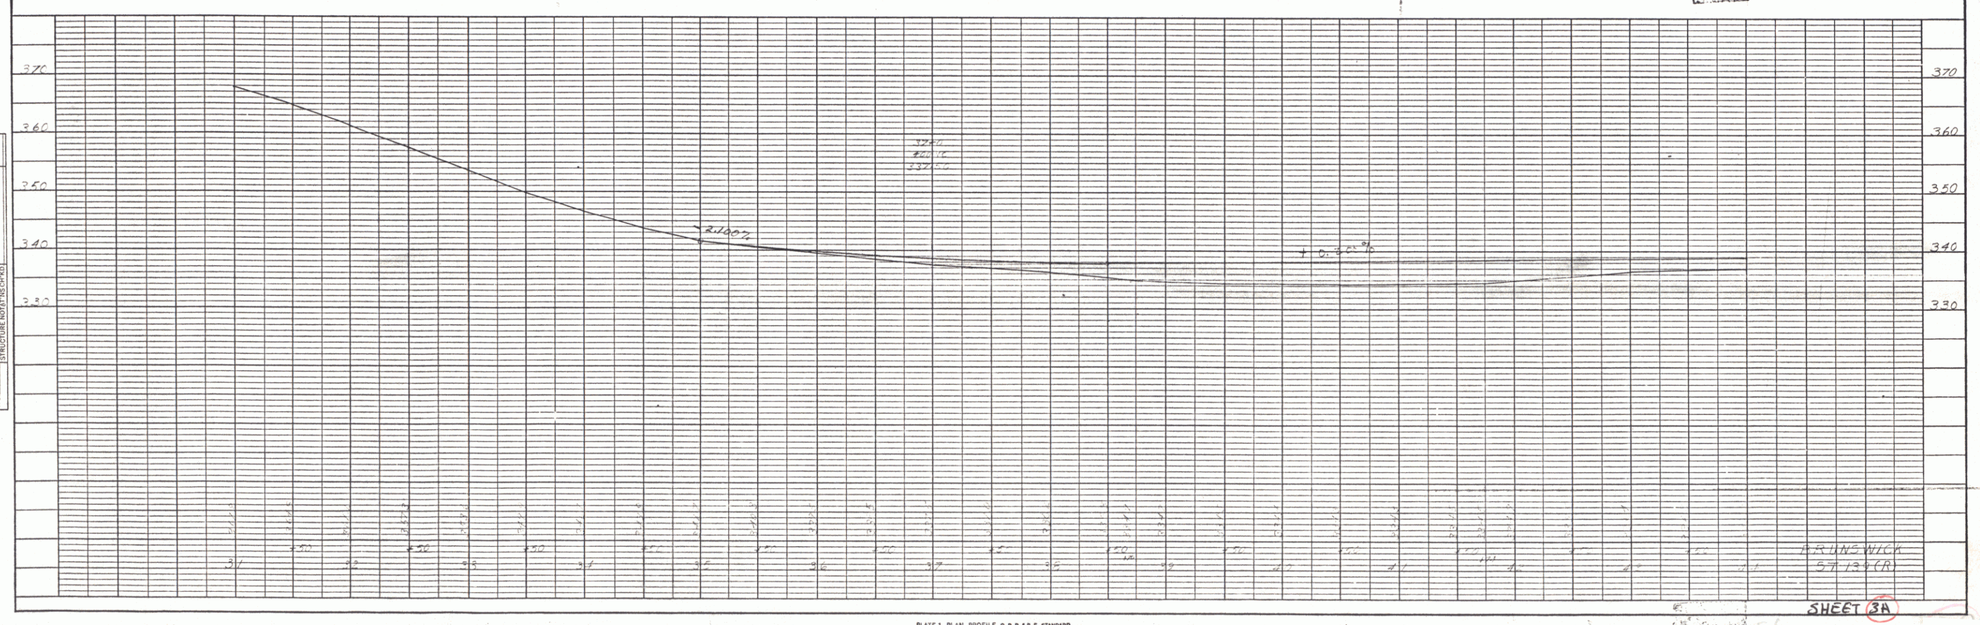

PLAN

NOTE BOOK NO.	SURVEYED	
	PLOTTED	
	ALIGNMENT CHECKED	
	RT. OF WAY CHECKED	
	BY	
	DATE	

PROFILE

NOTE BOOK NO.	SURVEYED	
	PLOTTED	
	GRADES CHECKED	
	B. M. NOTED	
	STRUCTURE NOTES (TOS CHKD.)	
	BY	
	DATE	

PLATE 1 - PLAN - PROFILE D. P. R. & R. E. STANDARD
KEUFFEL & ESSER CO., NEW YORK.
K & E CO. NO. 345-1 MADE IN U.S.A. 1970

SHEET 3A

Sheet name
5