STATE OF VERMONT from ~~TO~~ DAVID AND CLAIRE DAGGETT
BY VDOE ON 7/14/77 IN BK 77/159-60

DAGGETT, DAVID F. & CLAIRE M.
PARCEL 1A 0.09 A± (4000 S.F.±)
BEG. STA. 12+00 LT. — END STA. 14+50 LT.
STA. 12+40 LT. — STA. 13+00 LT. — CHANNEL RT. (P) 0.06 A± (2600 S.F.±)
STA. 14+05 LT. DRIVE (T)
STA. 16+40 LT. DRIVE (T)

PARCEL 1B 0.04 A± (1950 S.F.±)
BEG. STA. 12+50 RT. — END STA. 14+00 RT.
STA. 12+50 RT. — STA. 13+02 RT. — CHANNEL RT. (P) 0.1 A± (4650 S.F.±)
STA. 12+00 RT. DRIVE (T)
STA. 14+90 RT. DRIVE (T)
STA. 16+90 RT. DRIVE (T)

MP ~~0256~~ 0354

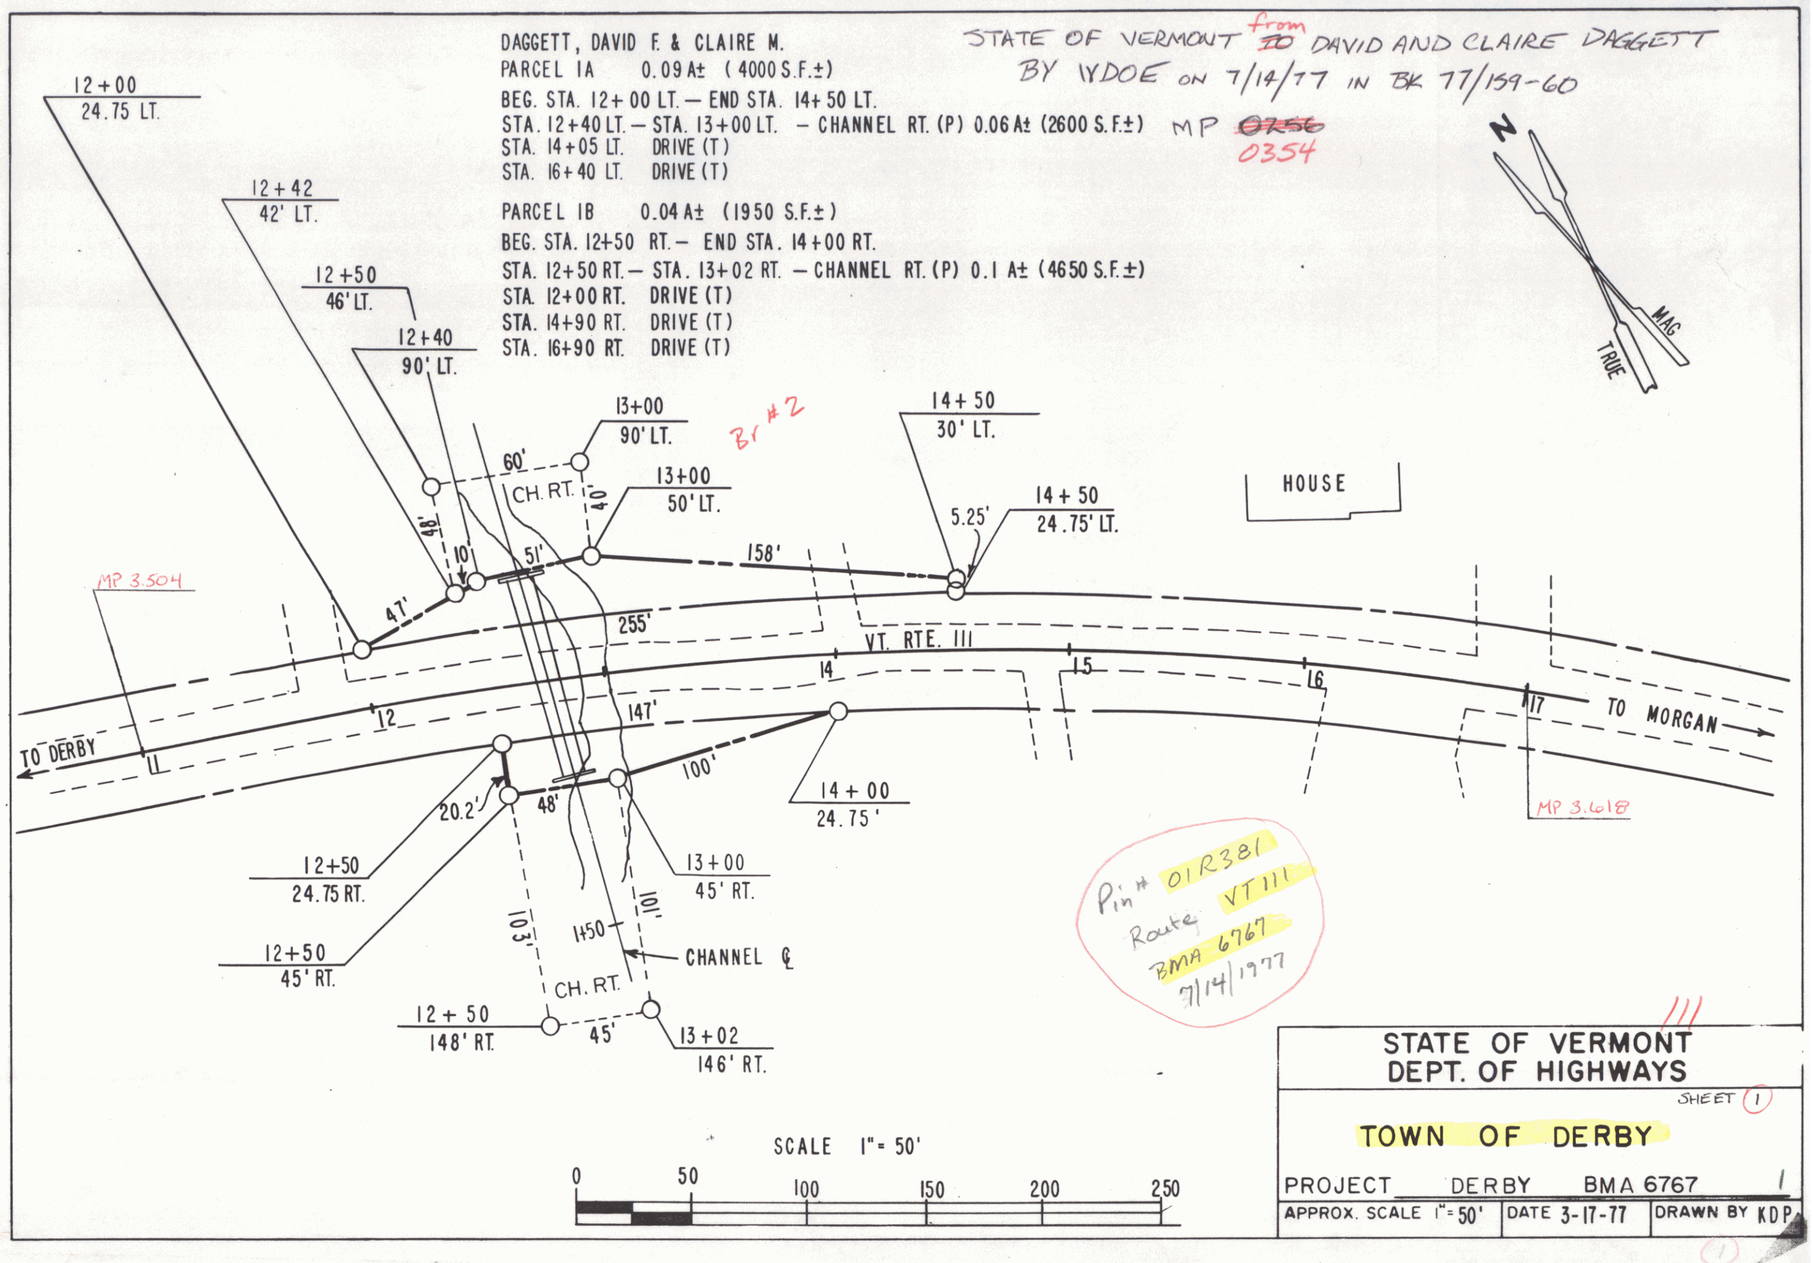

STATE OF VERMONT
DEPT. OF HIGHWAYS

SHEET 1

TOWN OF DERBY

PROJECT DERBY BMA 6767

APPROX. SCALE 1" = 50'	DATE 3-17-77	DRAWN BY KDP