


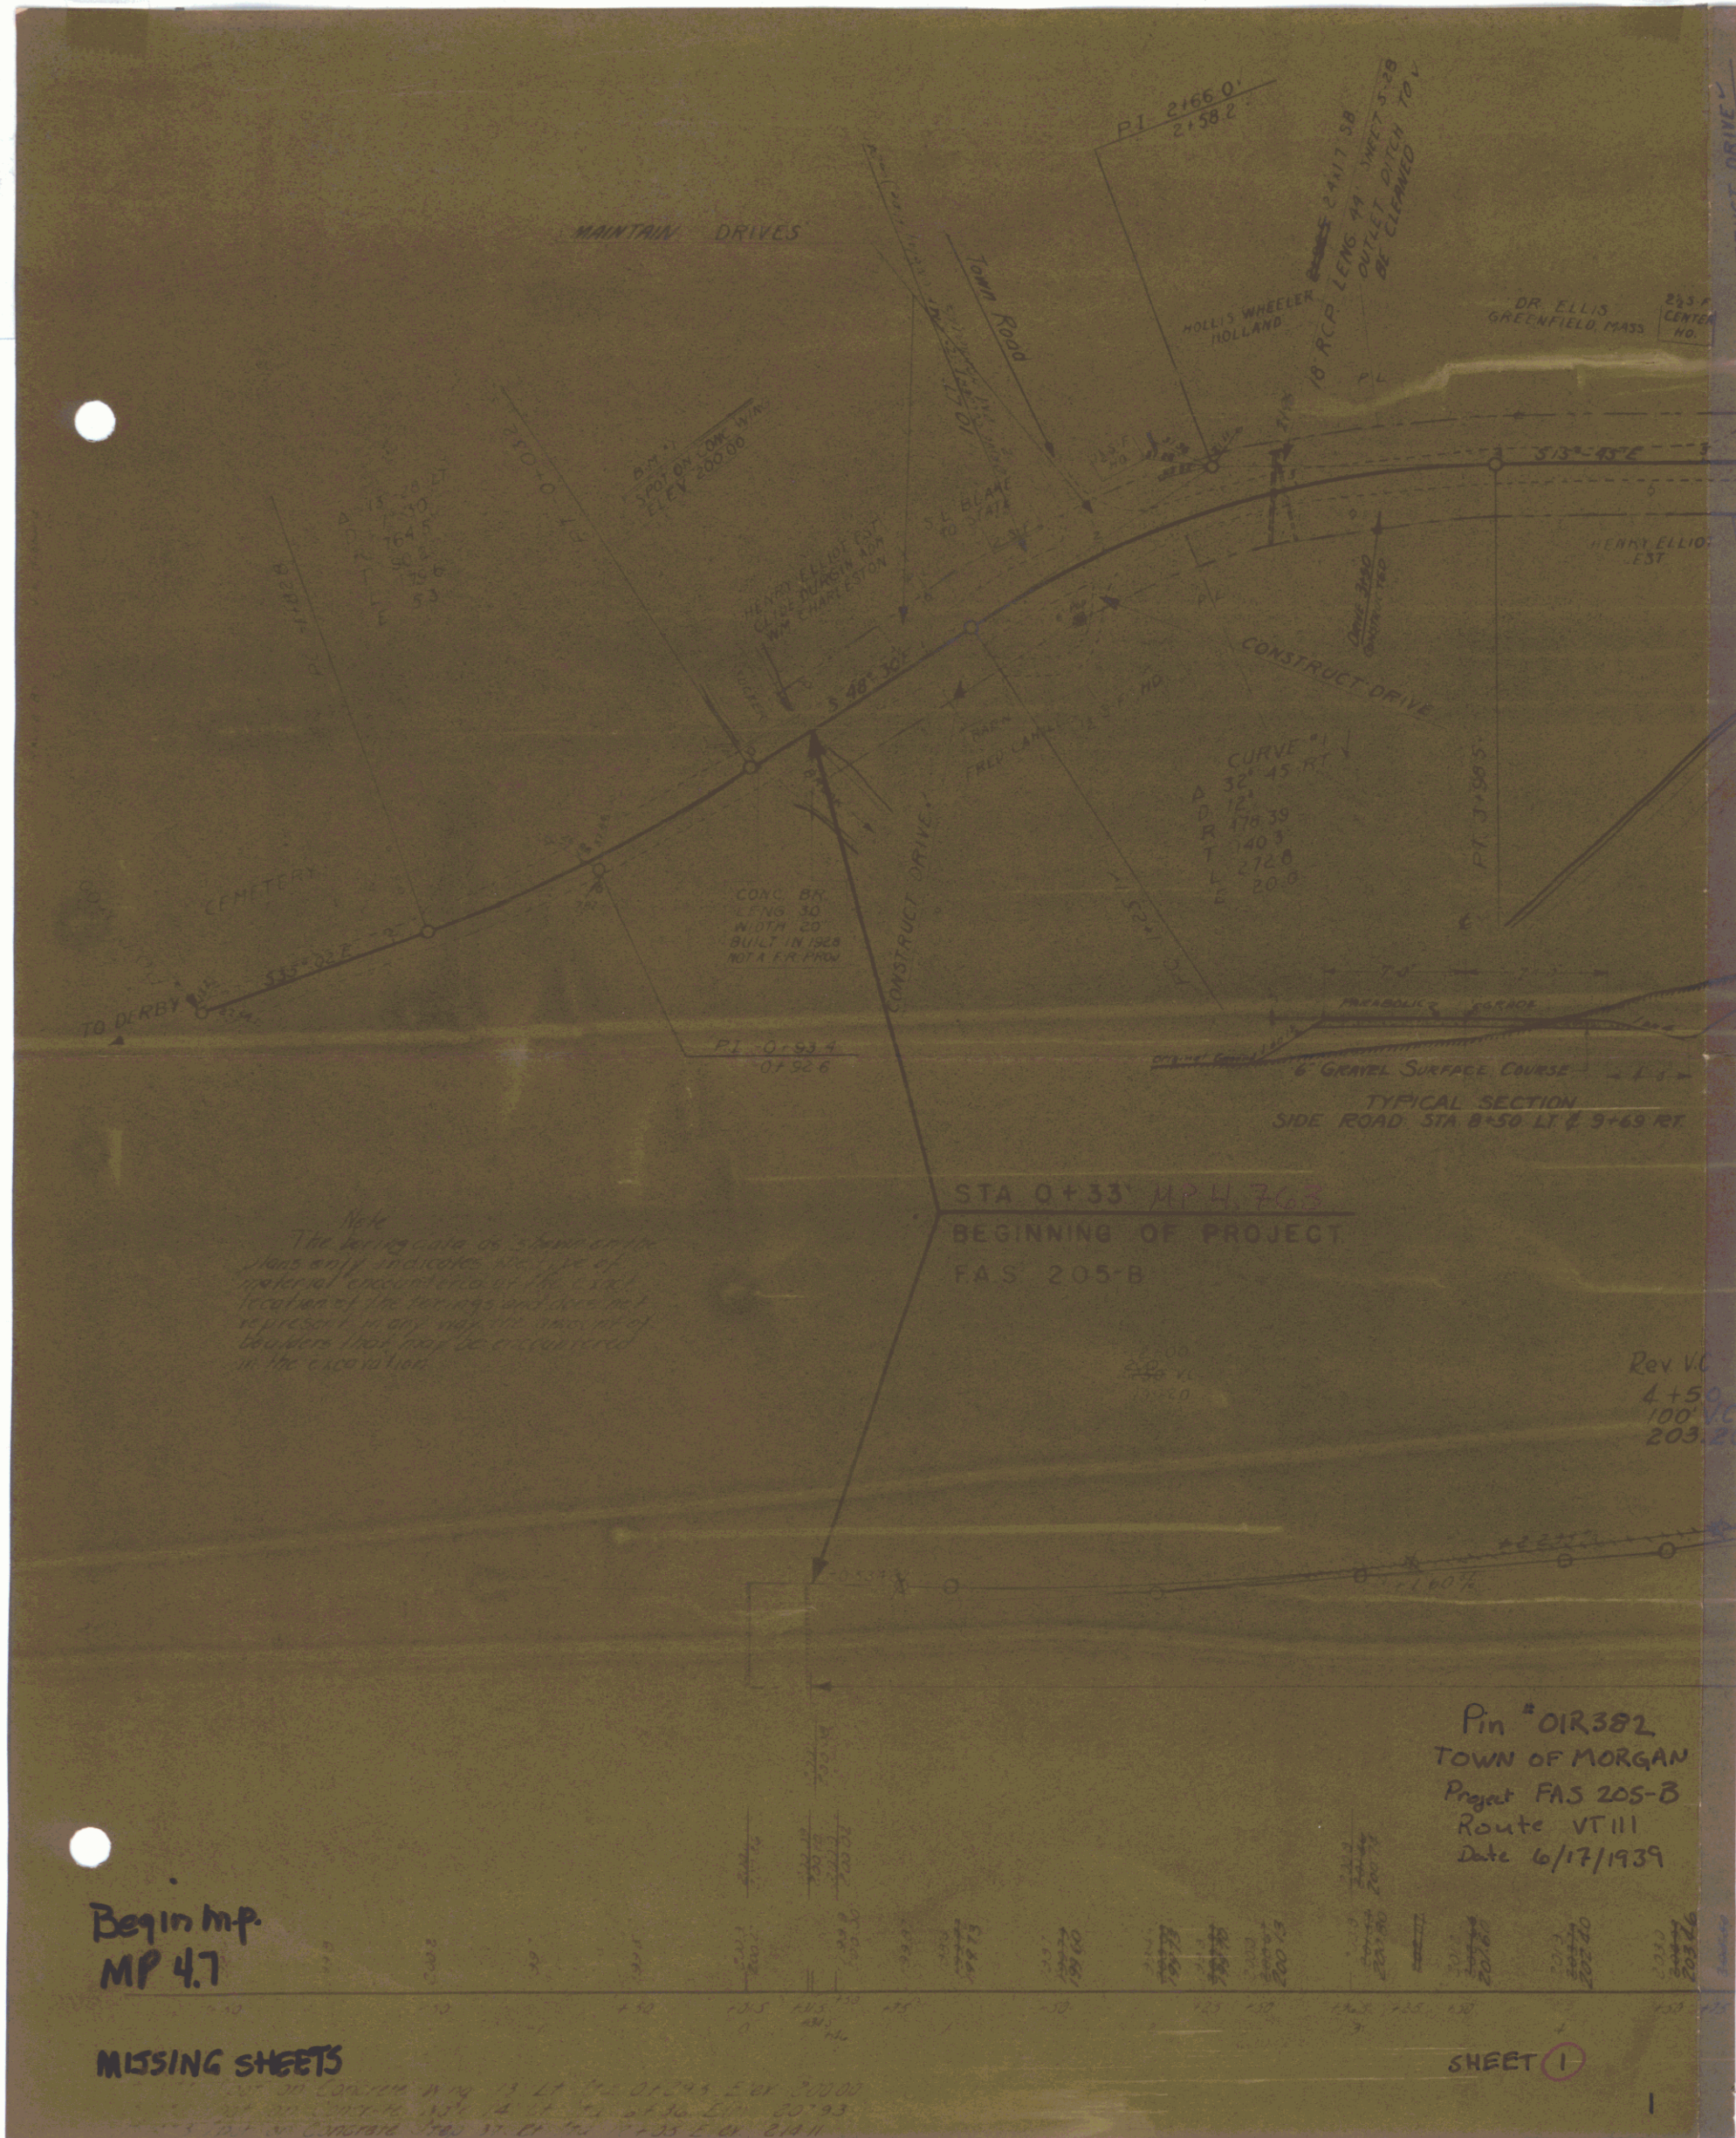

Begin mp
MP 4.7

MISSING SHEETS

Pin #01R382
TOWN OF MORGAN
Project FAS 205-B
Route VT111
Date 6/17/1939

SHEET 1