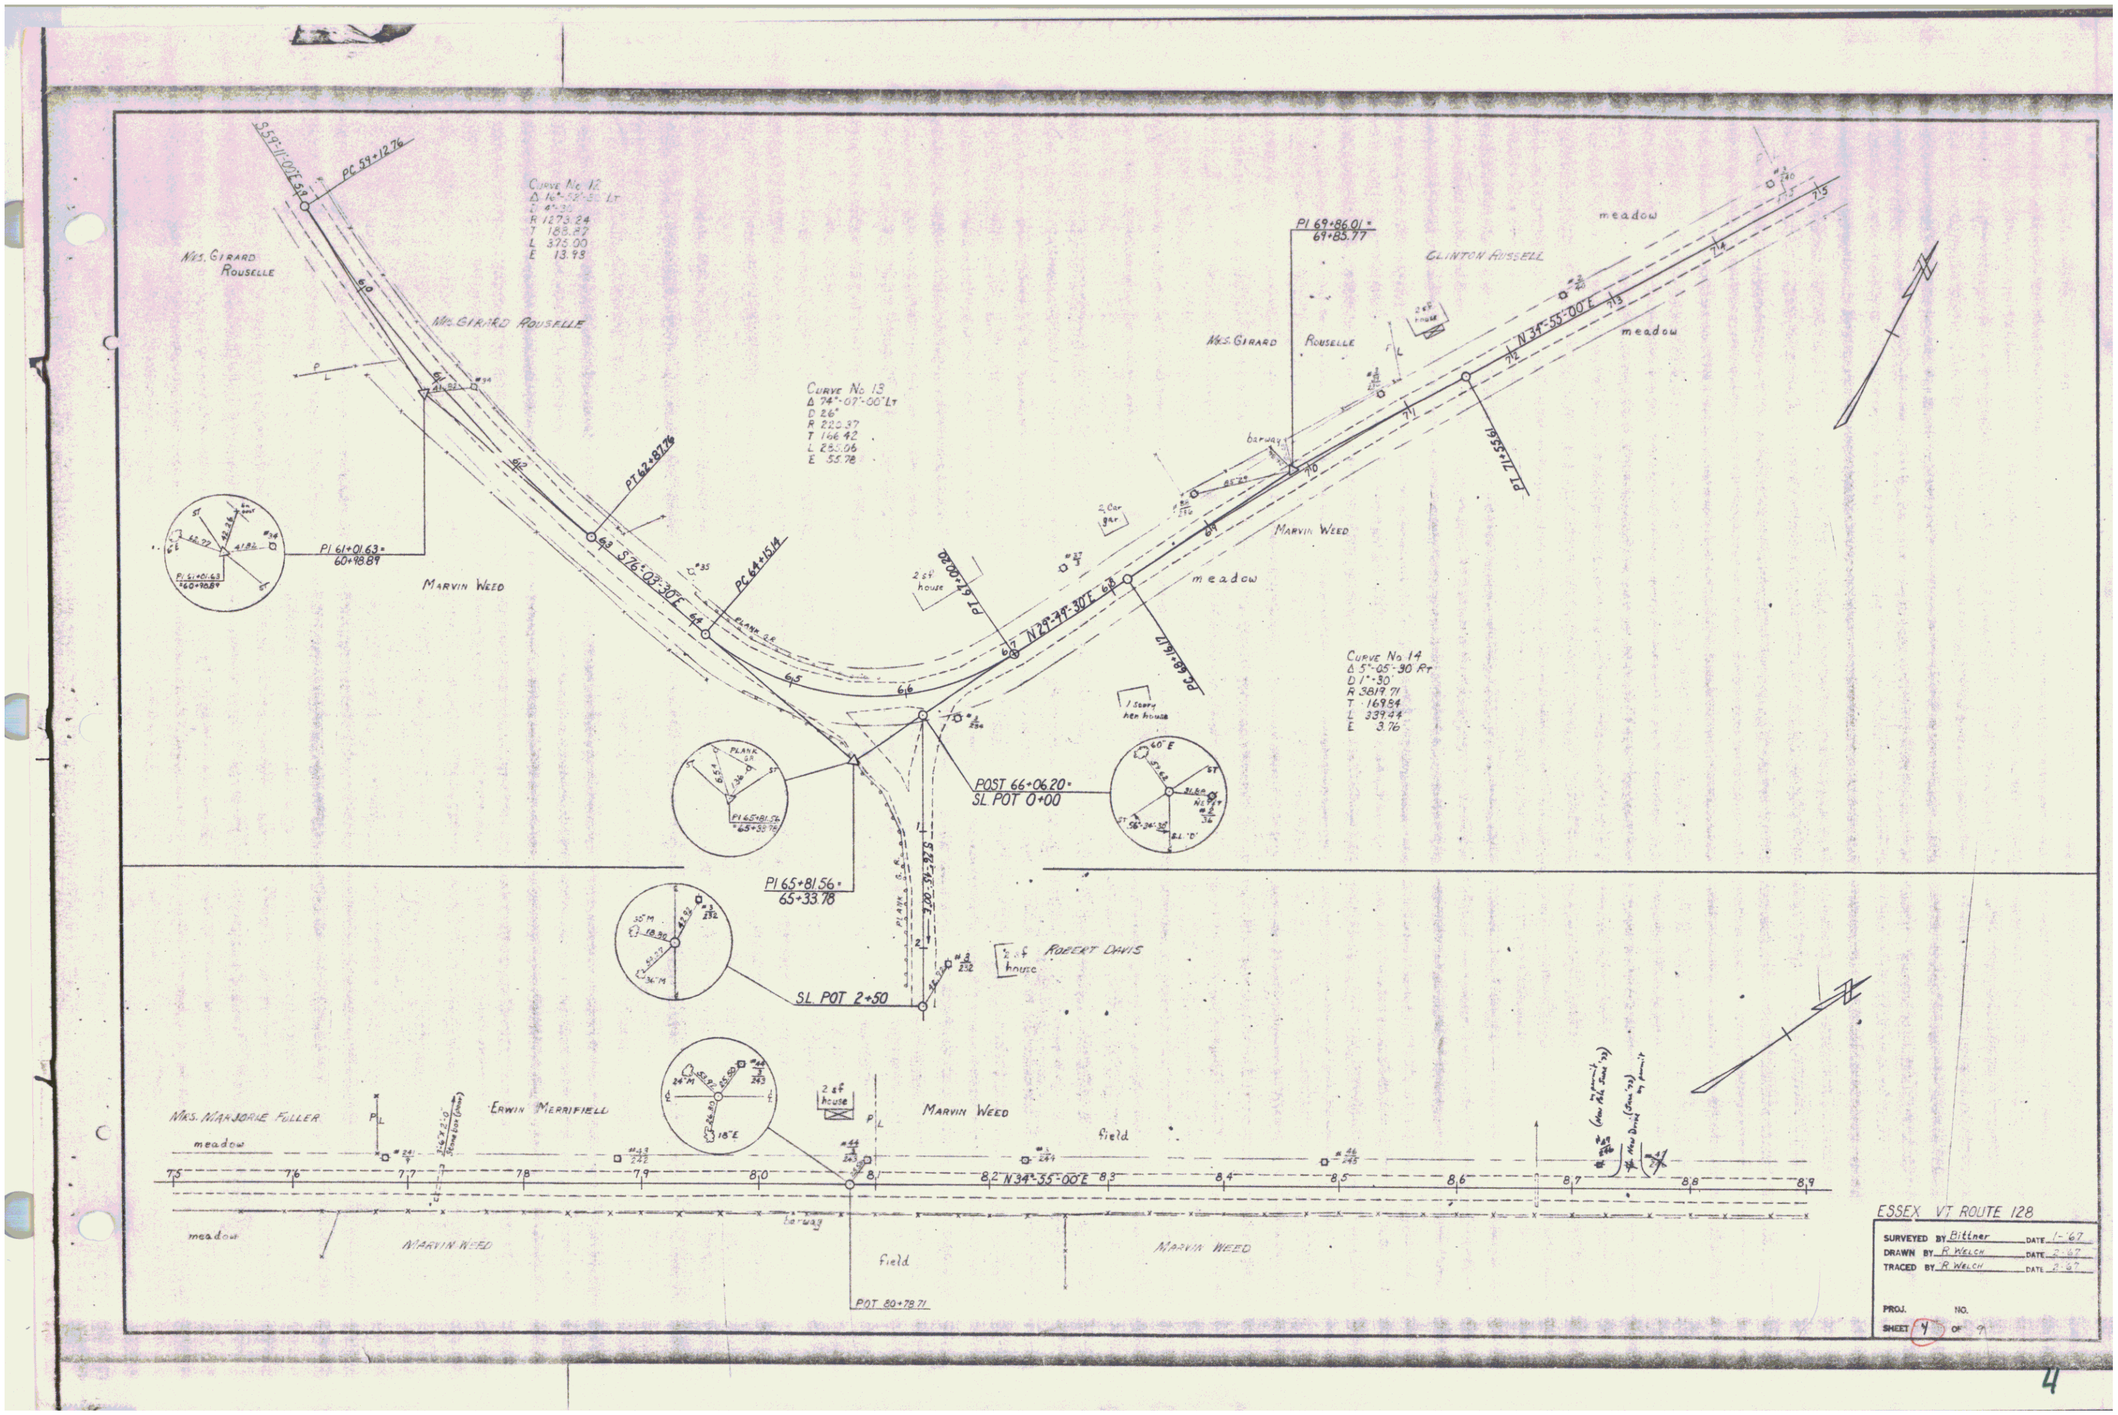
S 57°-11-00°E 59
PC 59+12.76
Curve No. 12
Δ 16°-52-50 Lt
D 4°-30'
R 1273.24
T 188.27
L 375.00
E 13.98
Mrs. Girard Rouselle
Mrs. Girard Rouselle
Curve No. 13
Δ 74°-07'-00" Lt
D 26°
R 220.37
T 166.42
L 285.06
E 55.78
PI 62+87.76
PI 61+01.63 =
60+98.89
Marvin Weed
S 76°-03'-30"E 64
PC 64+15.14
PLANK S.R.
PI 69+86.01 =
69+85.77
Clinton Russell
meadow
Mrs. Girard Rouselle
N 34°-55-00"E
meadow
driveway
PT 71+55.64
Marvin Weed
meadow
PT 67+00.00
N 27°-39'-30"E 68
PC 68+16.17
Curve No. 14
Δ 5°-05'-30" Rt
D 1°-30'
R 3819.71
T 169.84
L 339.44
E 3.76
POST 66+06.20 =
SL POT 0+00
PI 65+81.56 =
65+33.78
S 56°-34'-00"E
Robert Davis
SL POT 2+50
Mrs. Marjorie Fuller
meadow
Erwin Merrifield
Marvin Weed
field
N 34°-35-00"E
meadow
Marvin Weed
driveway
field
Marvin Weed
POT 80+78.71
ESSEX VT ROUTE 128
SURVEYED BY Bittner DATE 1-67
DRAWN BY R. Welch DATE 2-67
TRACED BY R. Welch DATE 2-67
PROJ. NO.
SHEET 4 OF 9