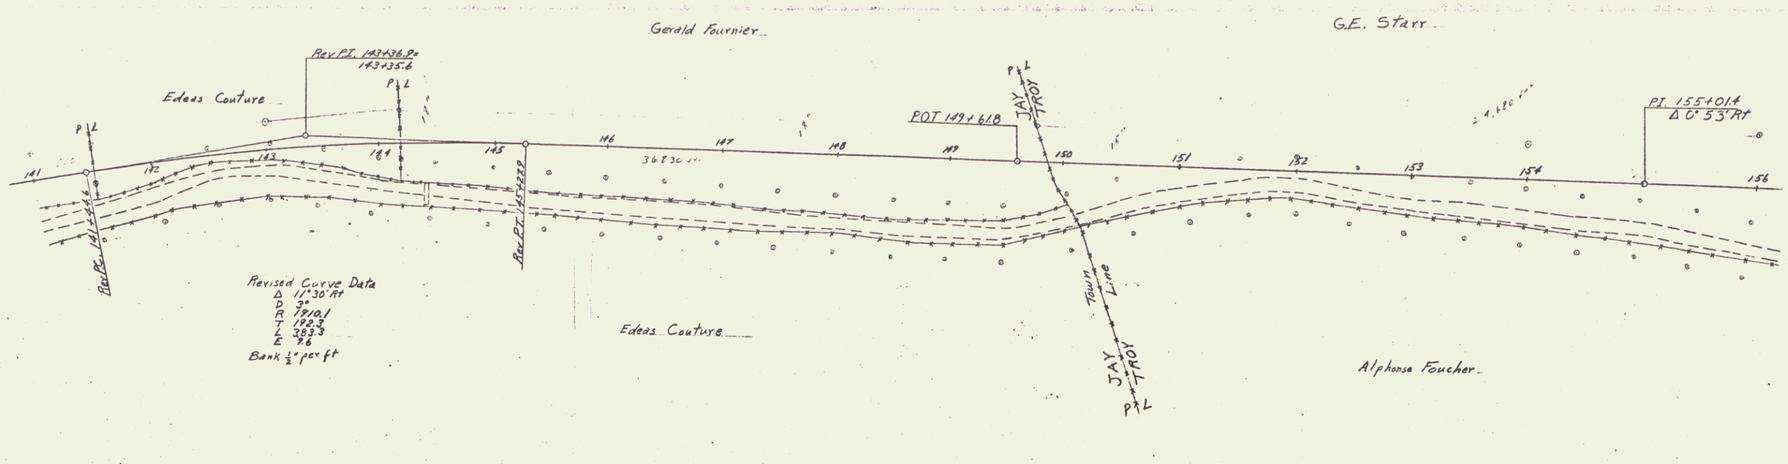

PLAN
SURVEYED
PLOTTED
NOTE BOOK
ALIGNMENT CHECKED
NO.
NO. OF MAP CHECKED
BY
DATE

PROFILE
SURVEY FIELD
PROFILE CHECKED
NOTE BOOK
BY AN. NOTED
NO.
BY ENGINEERING STAFF (SUPVSD)
BY
DATE

PLATE 1 - PLAN - PROFILE G.P.R. & R.E. STANDARD
KEUFFEL & ESSER CO., NEW YORK.
K & E CO. NO. 345-1

11