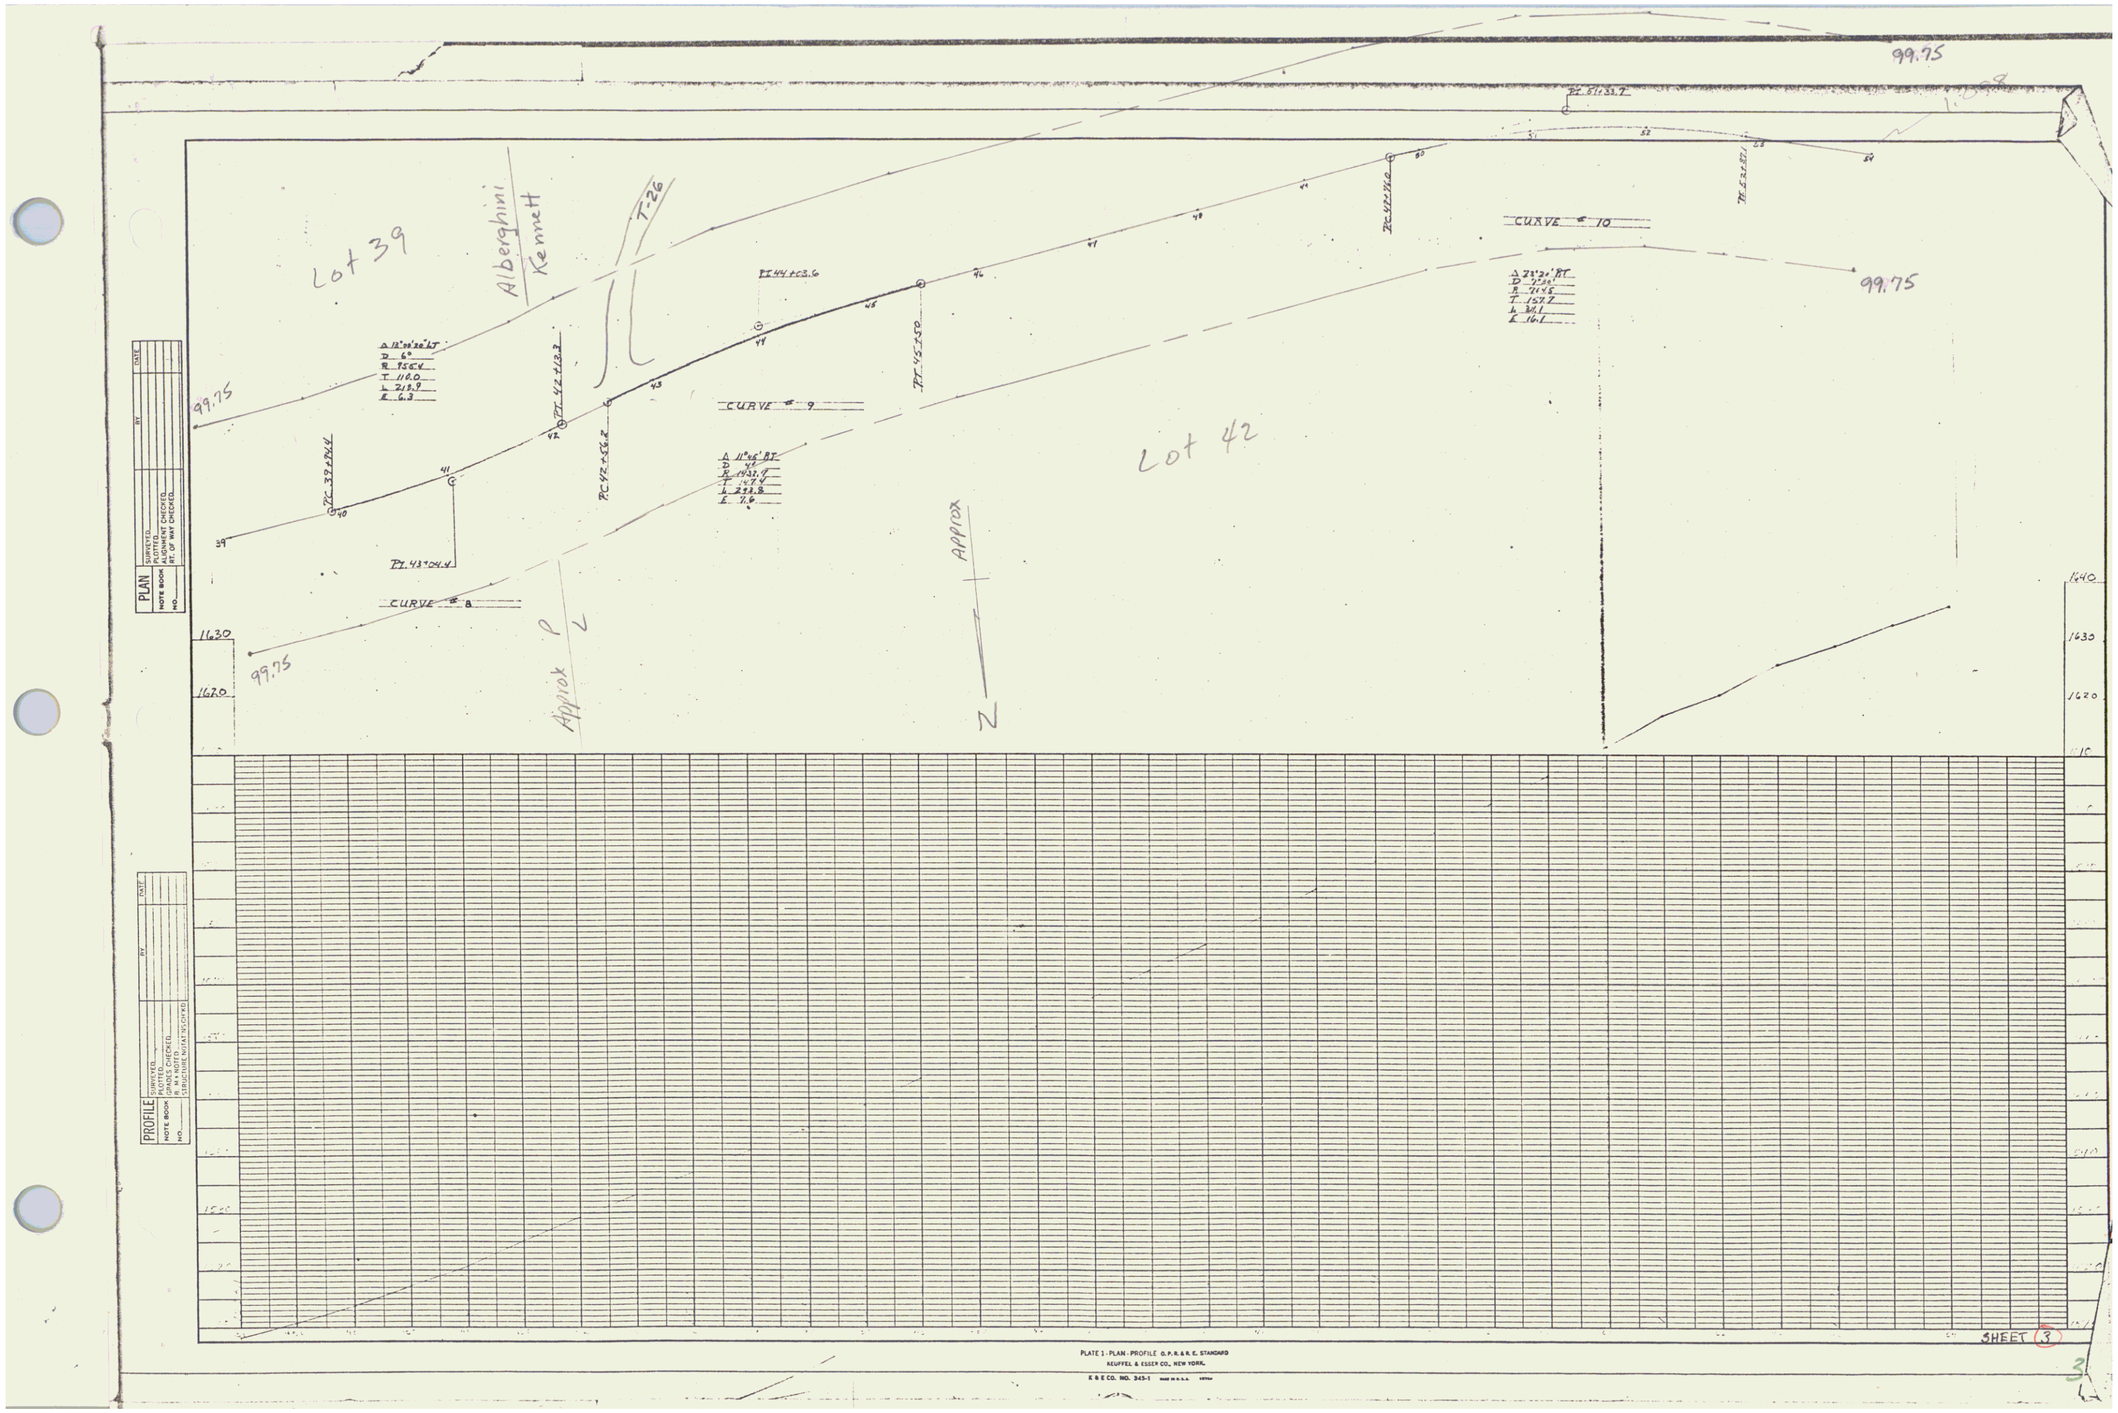

PLATE 1 - PLAN - PROFILE O.P.R.R. & R.E. STANDARD
KEUFFEL & ESSER CO., NEW YORK.
K & E CO. NO. 345-1