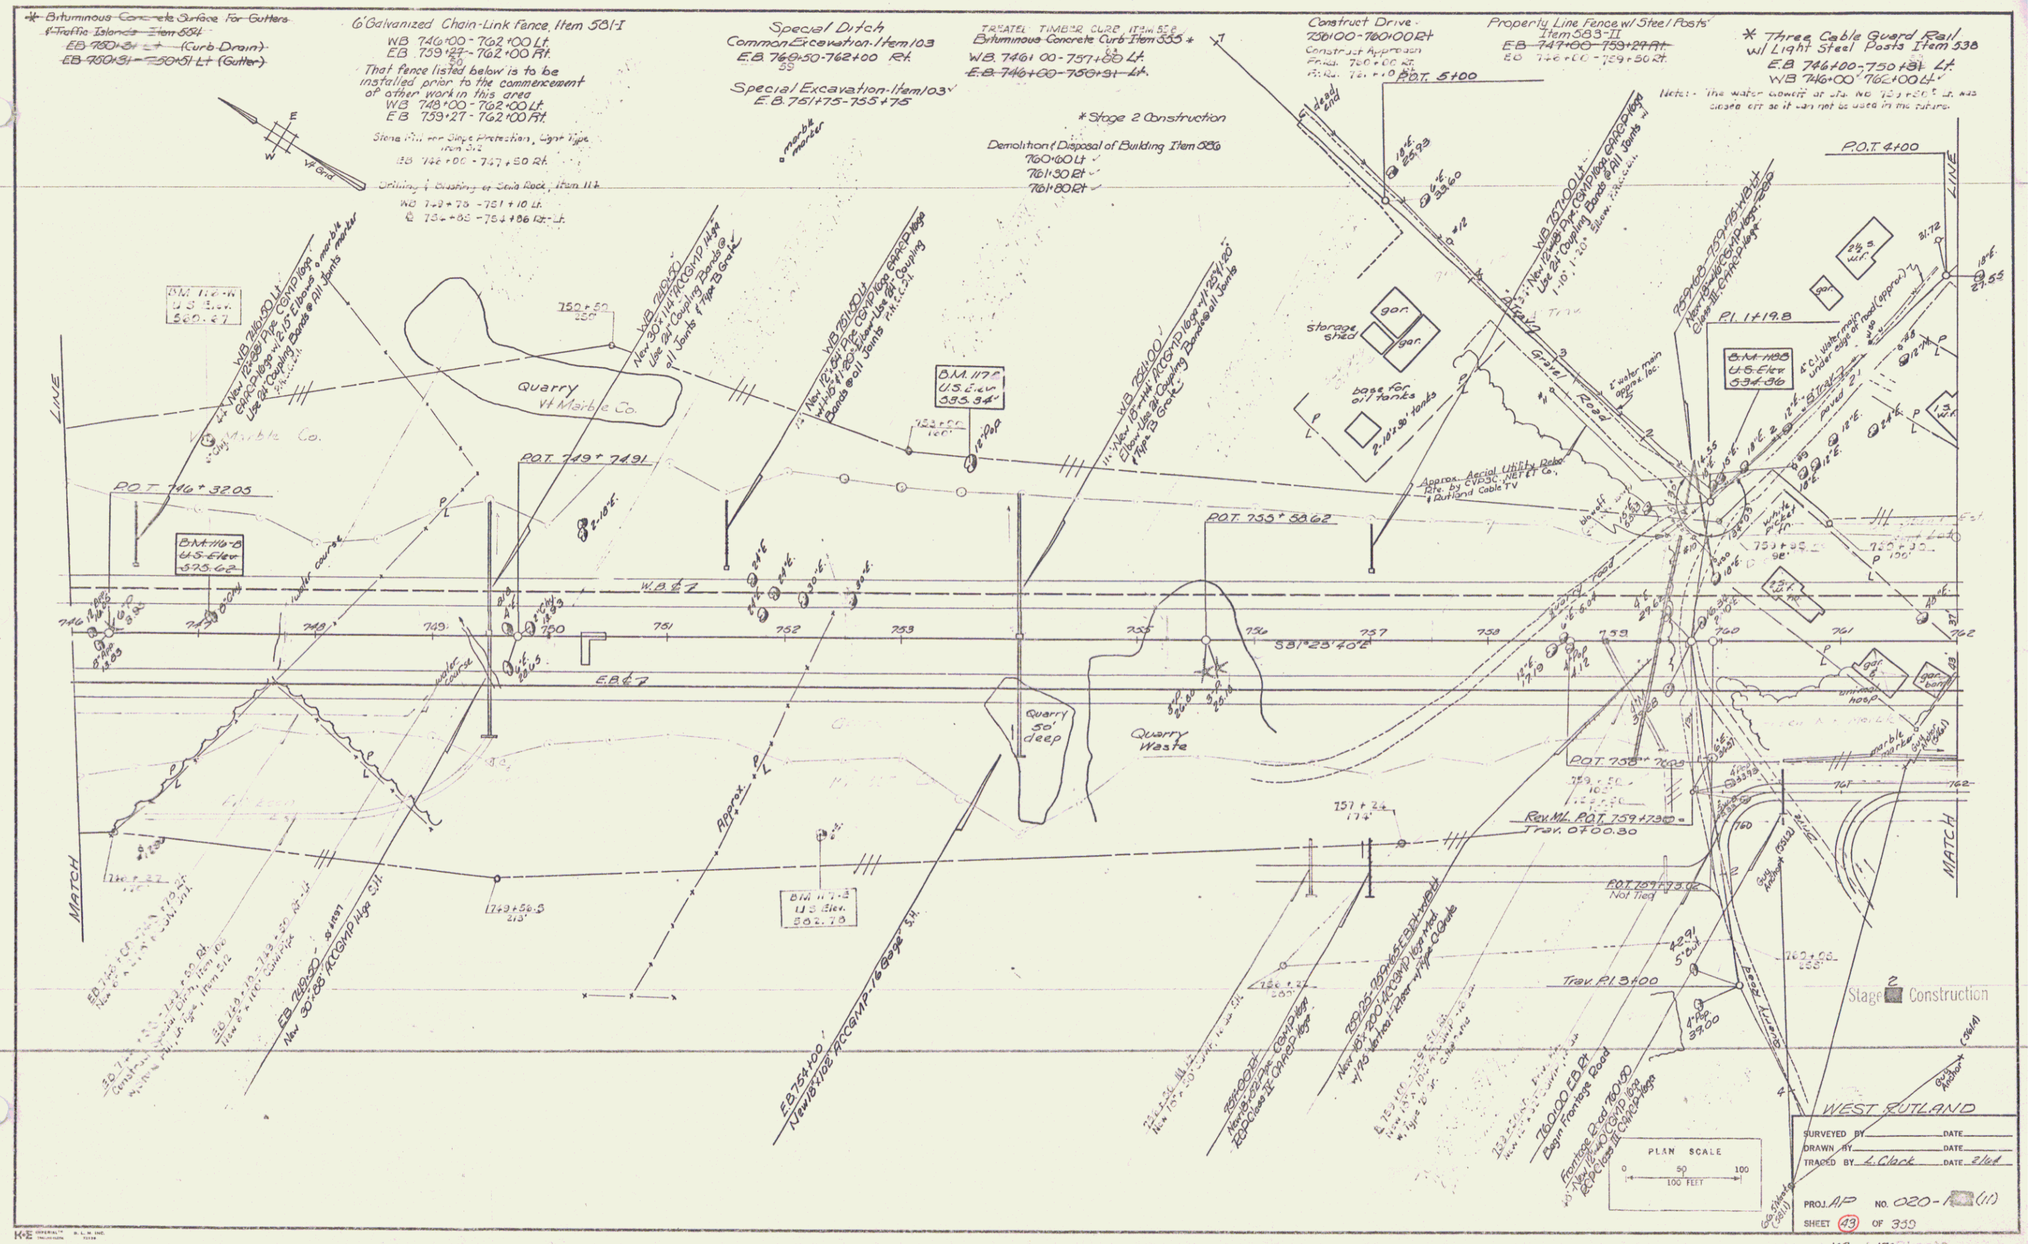
~~* Bituminous Concrete Surface for Gutters & Traffic Islands Item 584~~
~~EB 750+31 Lt (Curb Drain)~~
~~EB 750+31 - 750+51 Lt (Gutter)~~
6' Galvanized Chain-Link Fence, Item 581-I
WB 746+00 - 762+00 Lt.
EB 759+27 - 762+00 Rt.
That fence listed below is to be installed prior to the commencement of other work in this area
WB 749+00 - 762+00 Lt.
EB 759+27 - 762+00 Rt.
Special Ditch
Common Excavation-Item 103
EB 769+50-762+00 Rt.
Special Excavation-Item 103
EB 751+75-755+75
TREATED TIMBER CURB, ITEM 528
Bituminous Concrete Curb Item 535 *
WB 746+00 - 757+50 Lt.
~~EB 746+00-750+31 Lt.~~
* Stage 2 Construction
Demolition & Disposal of Building Item 886
760+60 Lt
761+30 Rt
761+80 Rt
Construct Drive
Property Line Fence w/ Steel Posts
Item 583-II
~~EB 747+00 - 759+27 Rt~~
EB 762+00 - 759+50 Rt.
* Three Cable Guard Rail w/ Light Steel Posts Item 538
EB 746+00-750+31 Lt.
WB 746+00 - 762+00 Lt.
Note: The water curbs at sta. No. 759+50 Lt. was cleared off so it was not be used in the future.
P.O.T. 5+00
P.O.T. 4+00
P.I. 1+19.8
Quarry
Vt Marble Co.
P.O.T. 746+32.05
P.O.T. 749+74.91
P.O.T. 753+58.62
P.O.T. 758+76.09
Rev. Ml. P.O.T. 759+73.00
Trav. 0+00.30
P.O.T. 767+73.00
Not Req
Trav. P.I. 3+00
storage shed
gar.
base for oil tanks
Approx. Aerial Utility Poles Rts. by CVPSC, NE Tel Co., & Rutland Cable TV
Quarry 50' deep
Quarry Waste
Approx. ℄
Gravel Road
W.B. ℄
E.B. ℄
S81°23'40"E
LINE
MATCH
Stage 2 Construction
WEST RUTLAND
SURVEYED BY
DRAWN BY
TRACED BY L. Clack
DATE
PLAN SCALE
0 50 100
100 FEET
PROJ. AP
NO. 020-
SHEET 43 OF 359

10