Cable Guard Rail Required		
Stations	Left	Right
11+50-14+62	-	312 ft
19+20-20+00	80 ft.	-
21+65-22+00	37 ft.	-

Wood Guard Rail Required		
Stations	Left Lin. Ft.	Right Lin. Ft.
14+38-14+62	24	-

New Reinf. Conc. Pipe Culverts Required					
Station	Diam.	Length Lin. Ft.	Conc. B cu. yds.	Steel lbs.
14+50	18"	36	3.0	33

Grouted Cobble Gutter Required				
Stations	Width	Long. Lin. Ft.	Area Sq. yds.
19+95-20+25 Rt.	4 ft.	30	13.3

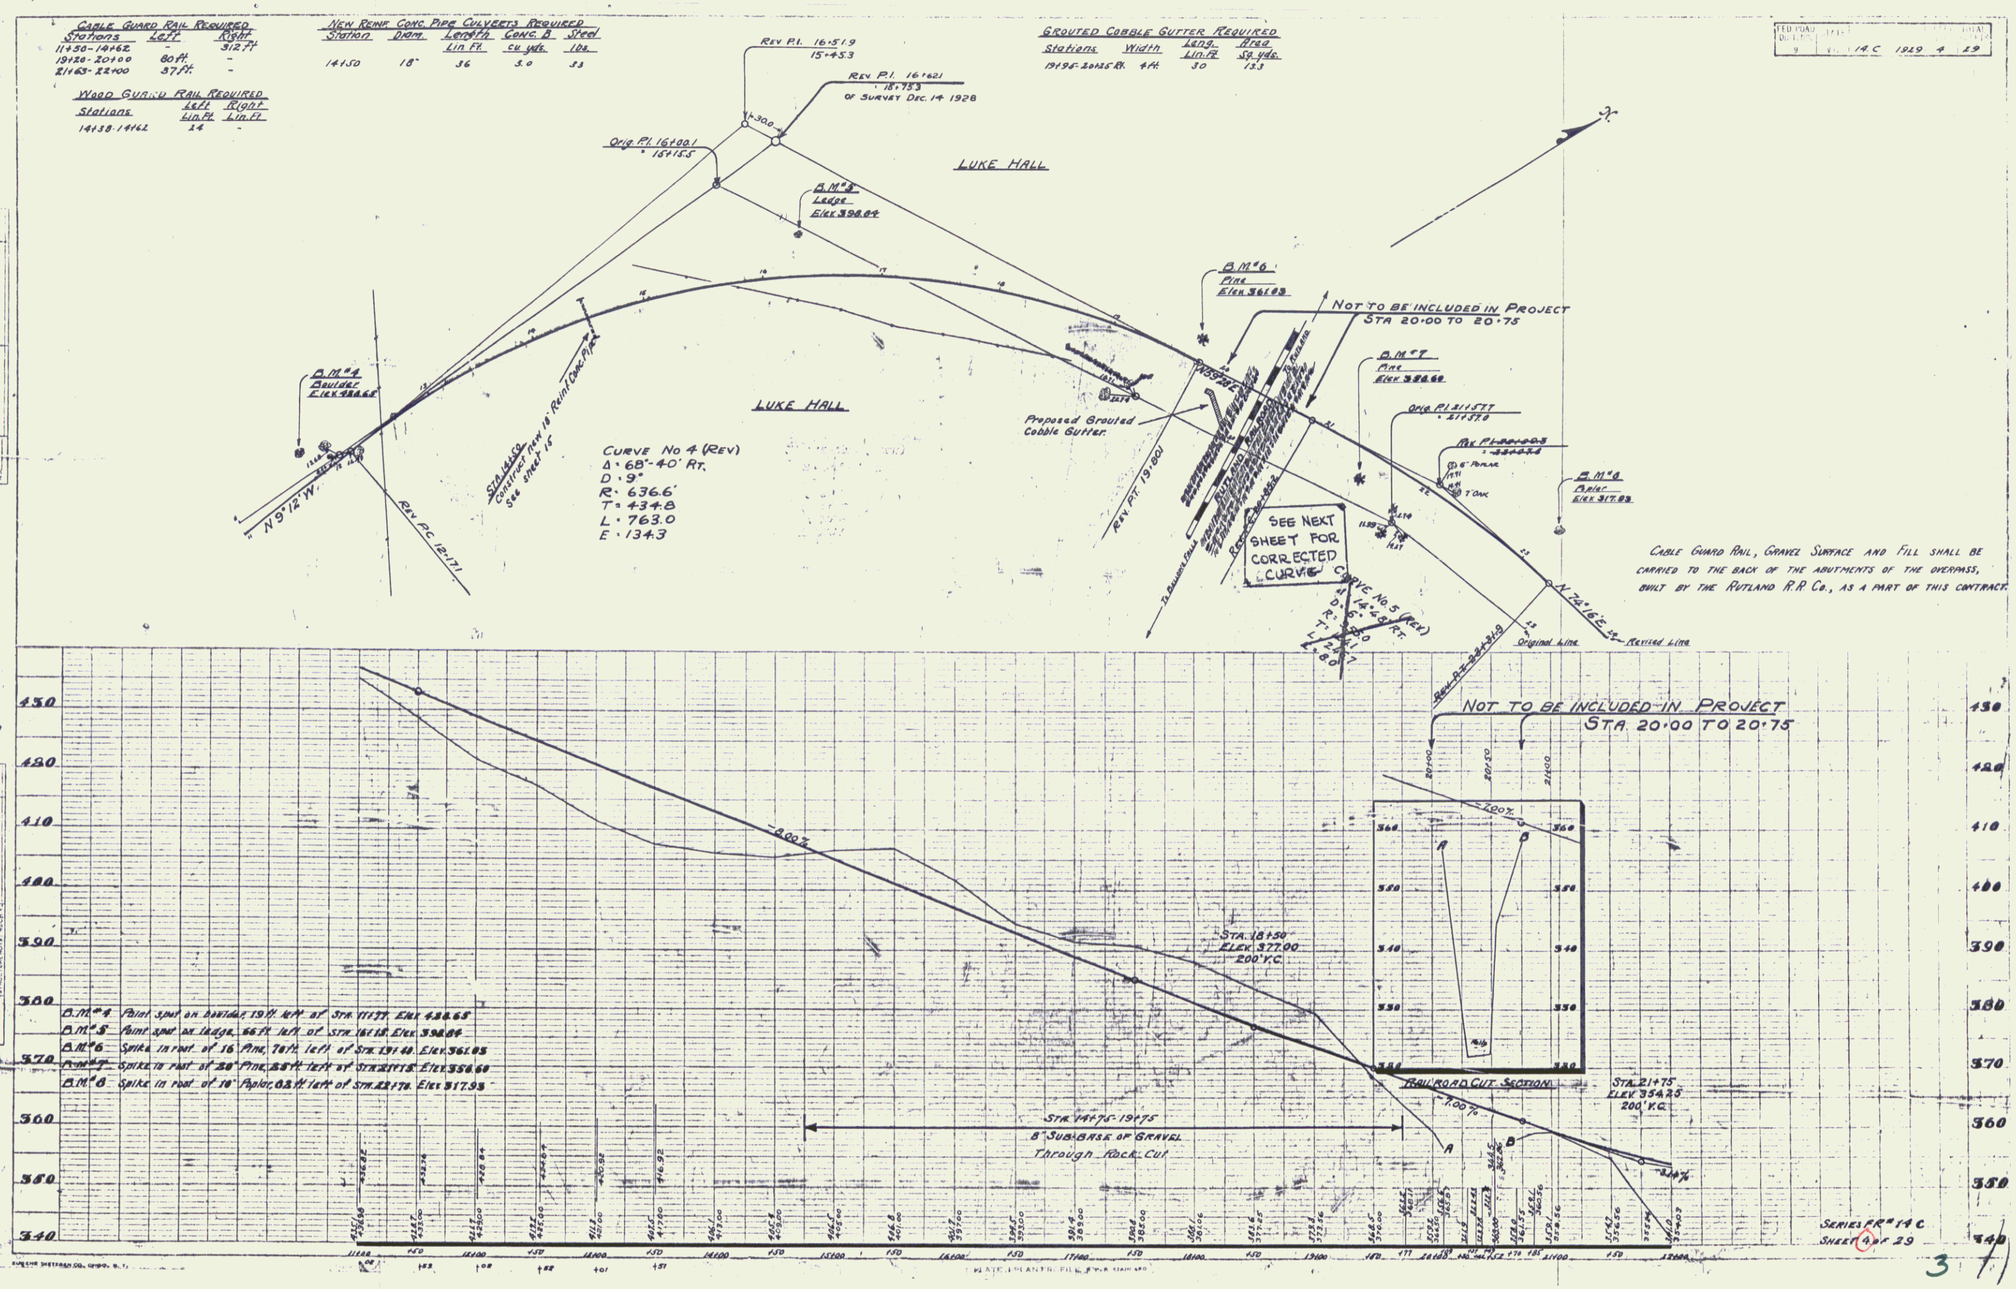

3