FED. ROAD DIST. NO.	STATE	FED. AID PROJ. NO.	FISCAL YEAR	SHEET NO.	TOTAL SHEETS
9	VT.	14-C	1929	6	29

CABLE GUARD RAIL REQUIRED

Stations	Lin. Ft. Left	Lin. Ft. Right
36+00-39+12	312	
36+00-41+04	-	504

NEW REINF. CONC. BOX CULVERTS REQUIRED

Station	Size	Conc. ft cu yds	Steel lbs.
39+00	5'x3'	218	1463

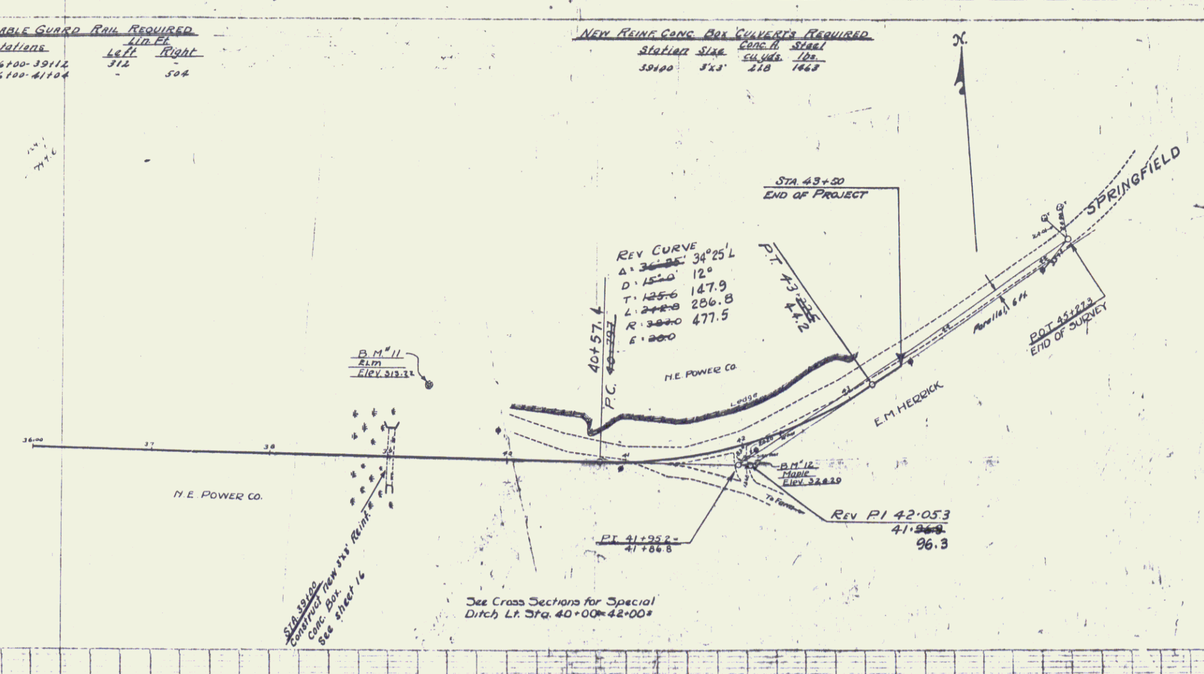

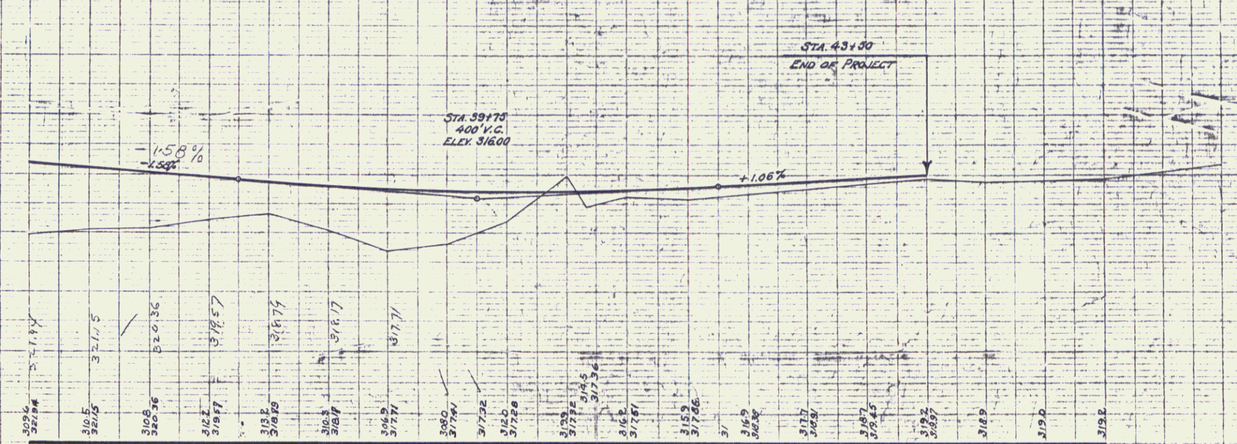

B.M. 11 SPIKE IN ROOT OF ELM CLUMP, 60 FT. LEFT OF STA. 39+28 - ELEV. 315.32

B.M. 12 SPIKE IN TRUNK OF 18" MAPLE, 15 FT. RIGHT OF STA. 42+93 - ELEV. 320.20

PLATE I PLAN & PROFILE

Sheet 6 of 29