


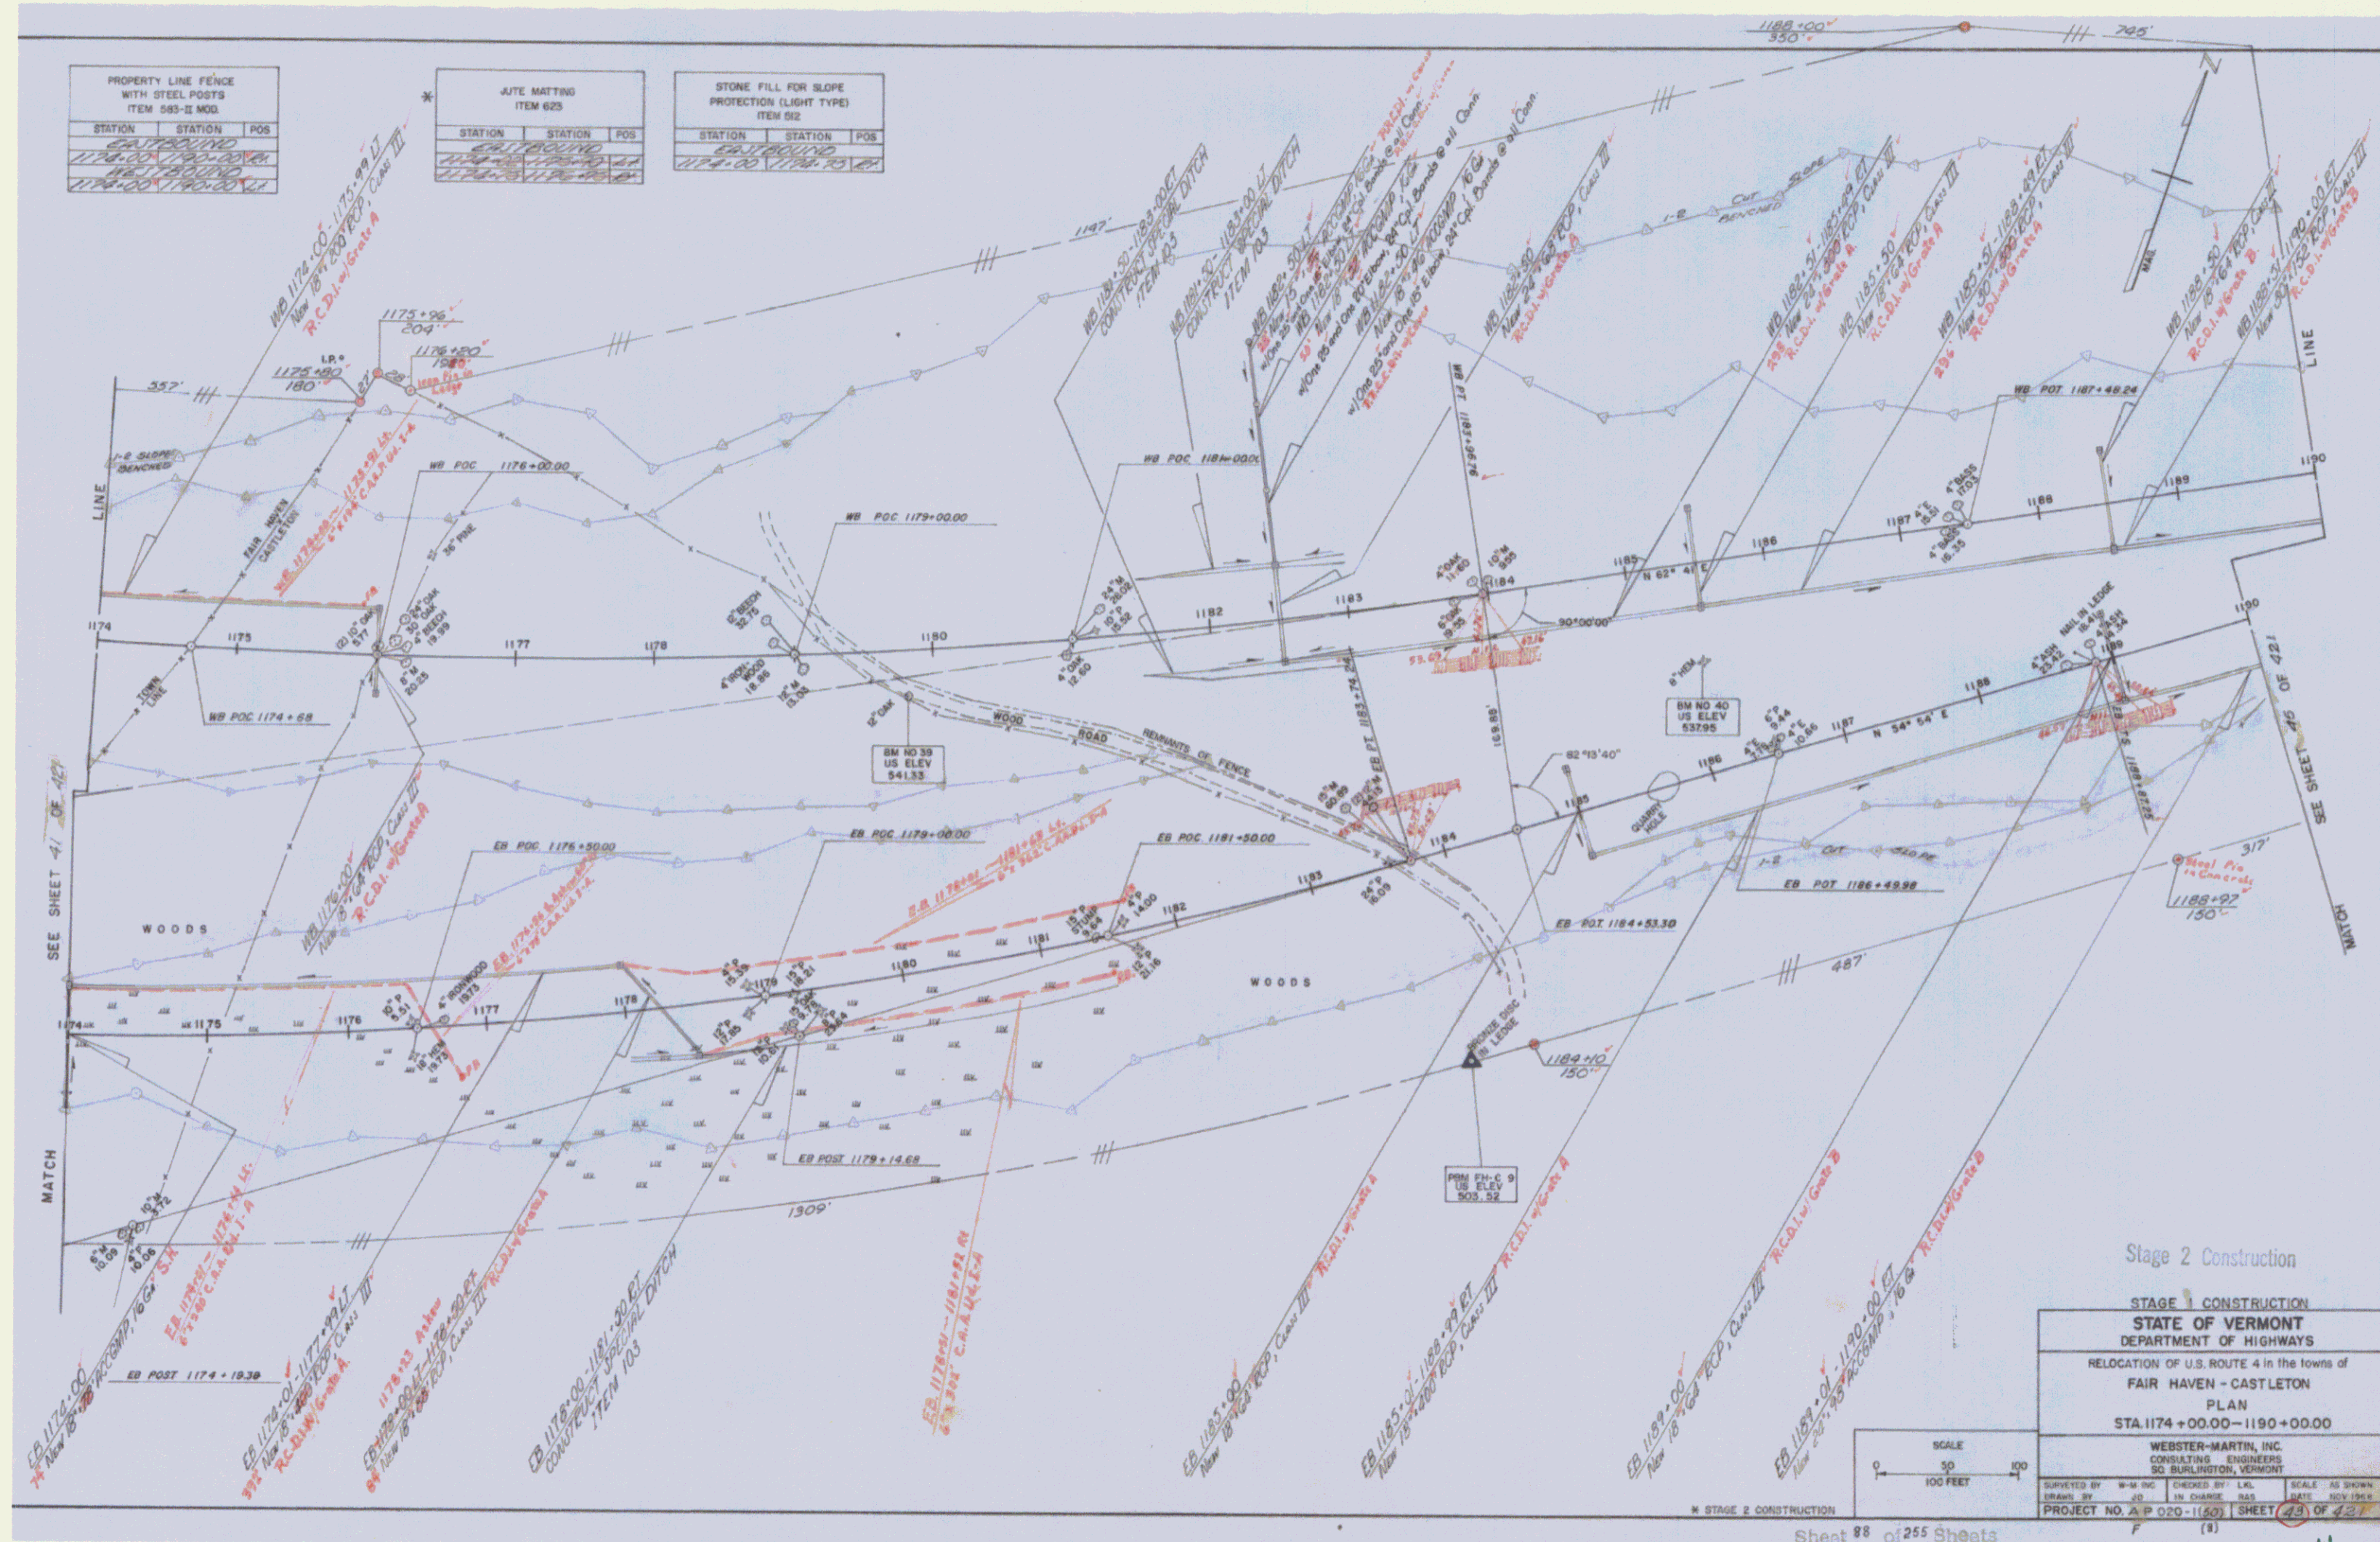

STAGE 2 CONSTRUCTION			
STATE OF VERMONT			
DEPARTMENT OF HIGHWAYS			
RELOCATION OF U.S. ROUTE 4 in the towns of			
FAIR HAVEN - CASTLETON			
PLAN			
STA. 1174+00.00 - 1190+00.00			
WEBSTER-MARTIN, INC.			
CONSULTING ENGINEERS			
50 BURLINGTON, VERMONT			
SURVEYED BY	W-M INC.	CHECKED BY	L.M.
DRAWN BY	ED	IN CHARGE	RAS
PROJECT NO.	A.P. 020-1150	DATE	NOV 1964
SHEET 43 OF 43		F (8)	

Sheet 88 of 255 Sheets