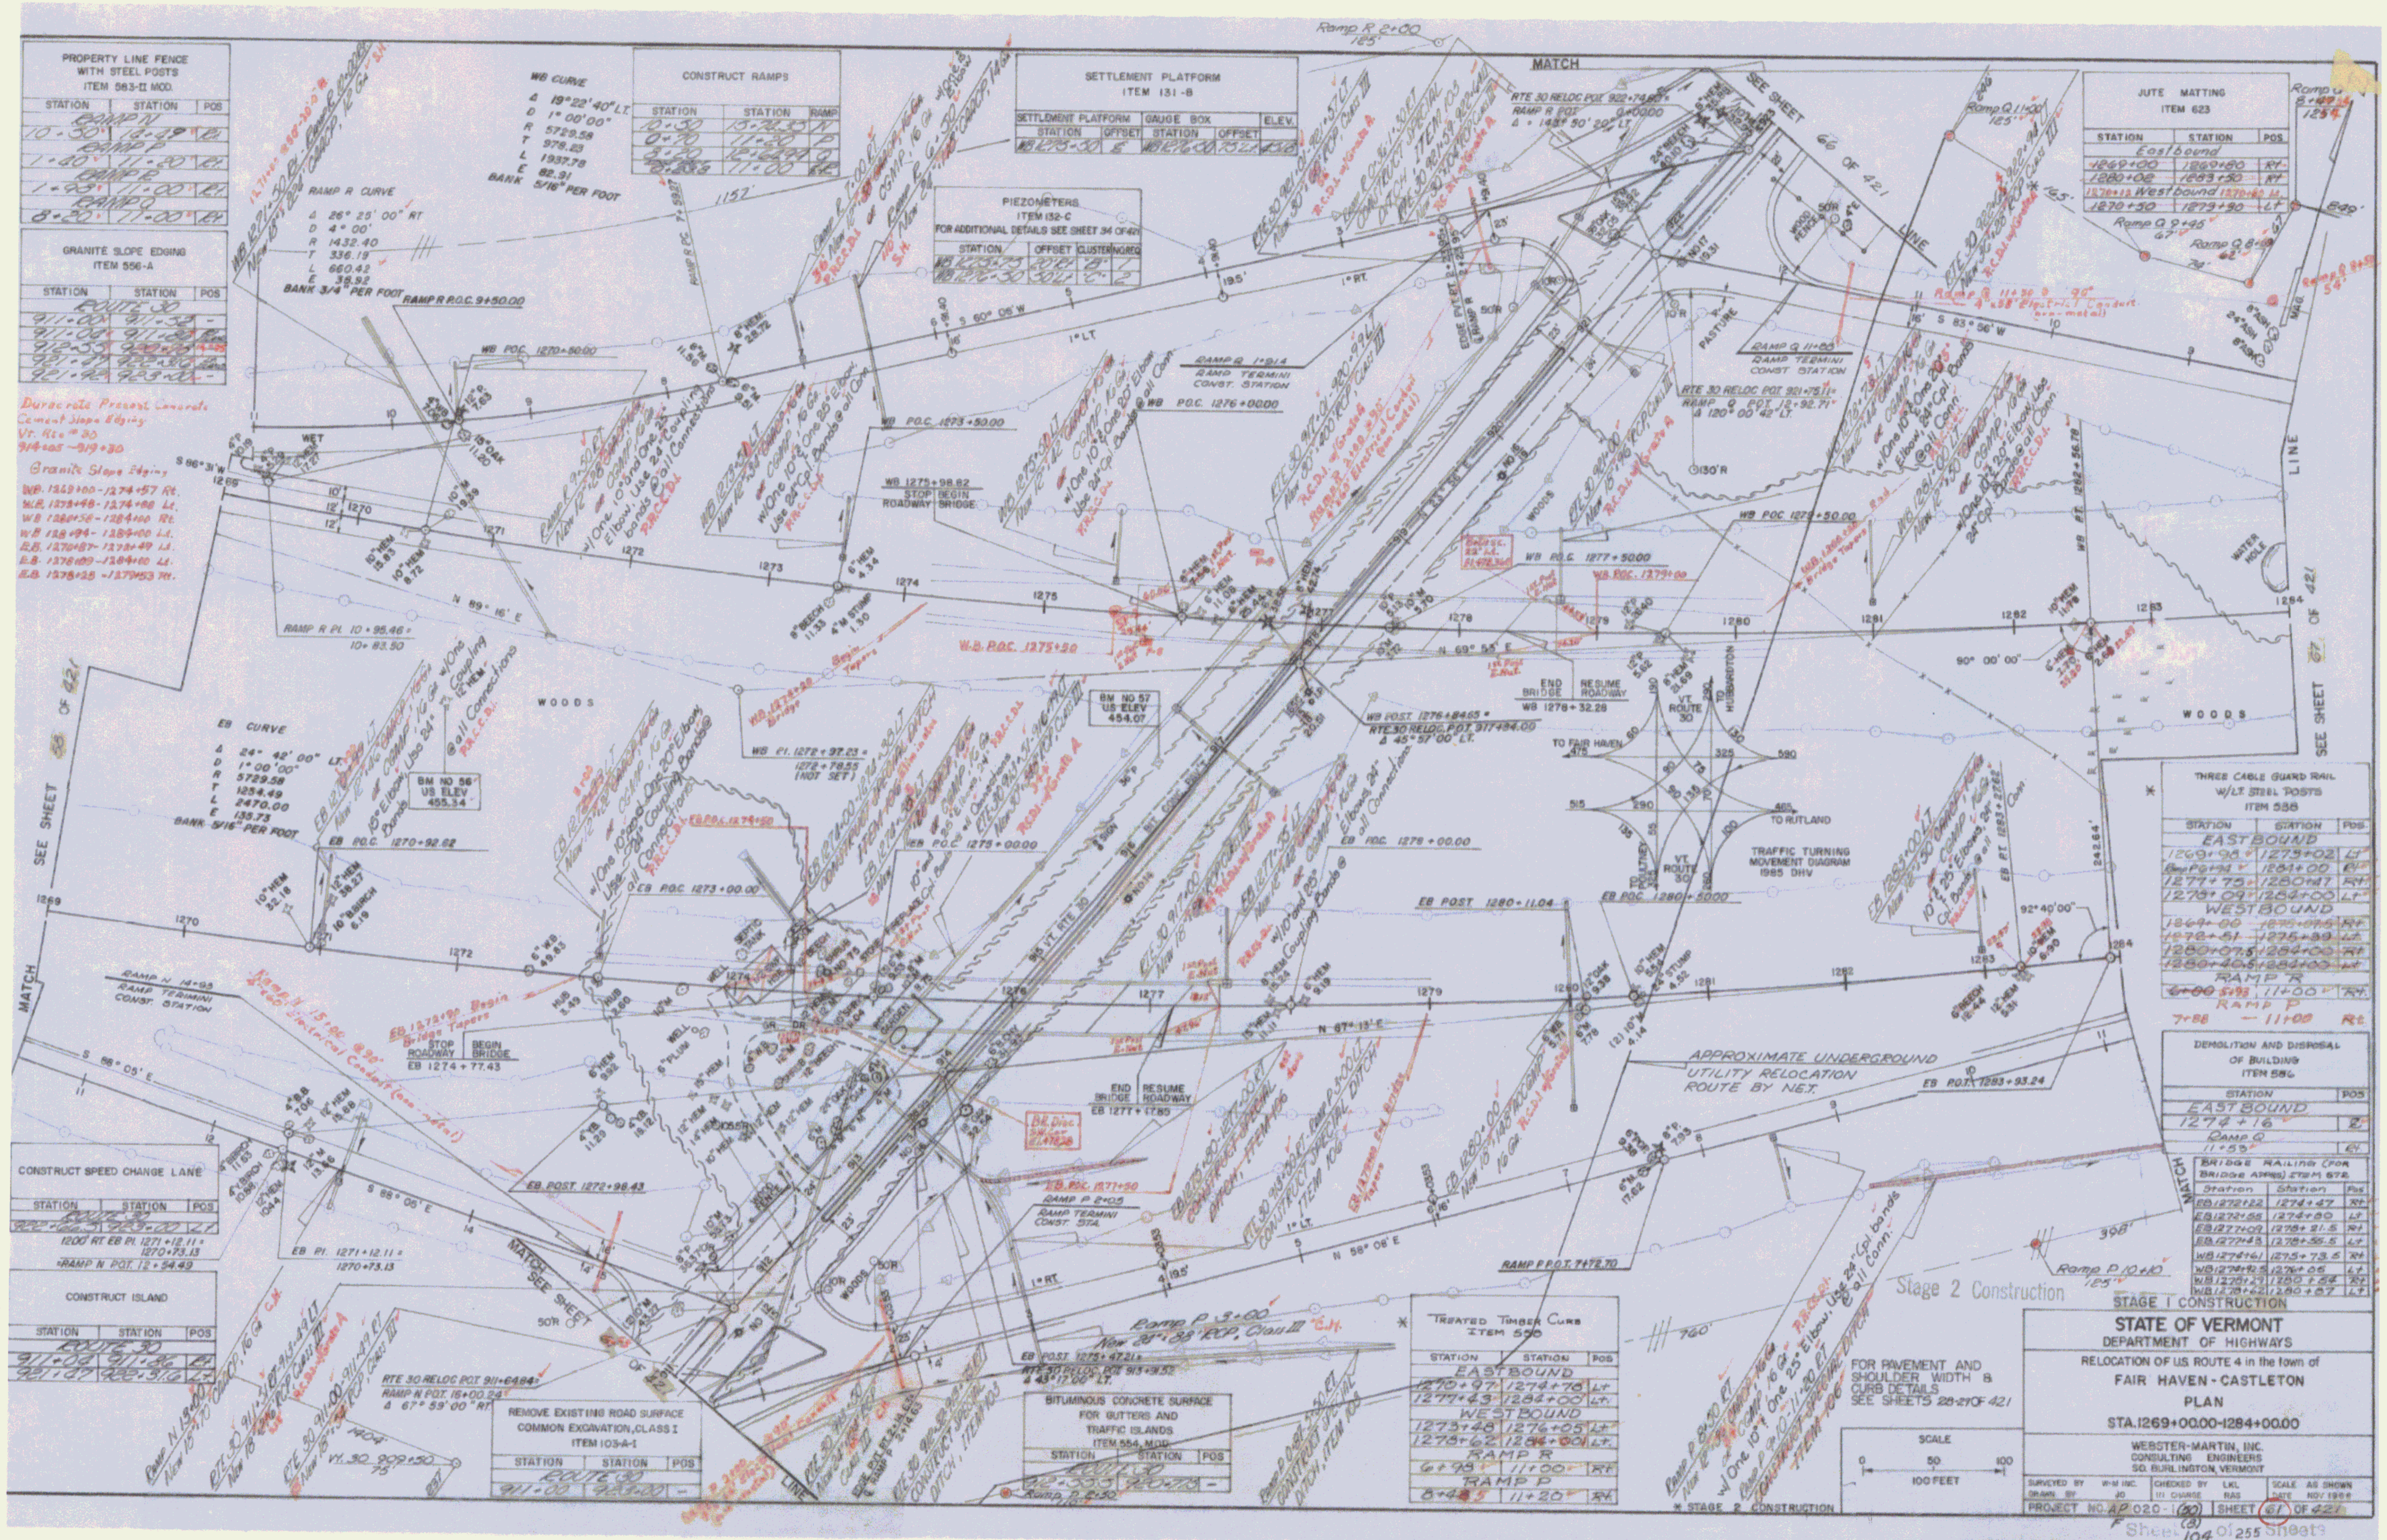
PROPERTY LINE FENCE WITH STEEL POSTS ITEM 563-II MOD.
CONSTRUCT RAMPS
SETTLEMENT PLATFORM ITEM 131-B
JUTE MATTING ITEM 623
GRANITE SLOPE EDGING ITEM 556-A
PIEZOMETERS ITEM 132-C
WB CURVE
RAMP R CURVE
EB CURVE
WOODS
BM NO 57 US ELEV 454.07
BM NO 56 US ELEV 455.34
TRAFFIC TURNING MOVEMENT DIAGRAM 1985 DHV
TO FAIR HAVEN
TO RUTLAND
APPROXIMATE UNDERGROUND UTILITY RELOCATION ROUTE BY NET.
THREE CABLE GUARD RAIL W/LT STEEL POSTS ITEM 538
DEMOLITION AND DISPOSAL OF BUILDING ITEM 586
BRIDGE RAILING (FOR BRIDGE APPRS) ITEM 672
CONSTRUCT SPEED CHANGE LANE
CONSTRUCT ISLAND
REMOVE EXISTING ROAD SURFACE COMMON EXCAVATION, CLASS I ITEM 103-A-1
BITUMINOUS CONCRETE SURFACE FOR GUTTERS AND TRAFFIC ISLANDS ITEM 554 MOD.
TREATED TIMBER CURB ITEM 550
FOR PAVEMENT AND SHOULDER WIDTH & CURB DETAILS SEE SHEETS 28-27 OF 421
SEE SHEET
MATCH
LINE
Stage 2 Construction
STAGE I CONSTRUCTION
STATE OF VERMONT
DEPARTMENT OF HIGHWAYS
RELOCATION OF U.S. ROUTE 4 in the town of
FAIR HAVEN - CASTLETON
PLAN
STA.1269+00.00-1284+00.00
WEBSTER-MARTIN, INC.
CONSULTING ENGINEERS
SO. BURLINGTON, VERMONT
SURVEYED BY W-M INC.
DRAWN BY JO
CHECKED BY LKL
IN CHARGE RAS
SCALE AS SHOWN
SCALE 0 50 100 FEET
PROJECT NO. AP 020-1(30)
SHEET 61 OF 421
Sheet 104 of 255 Sheets
11