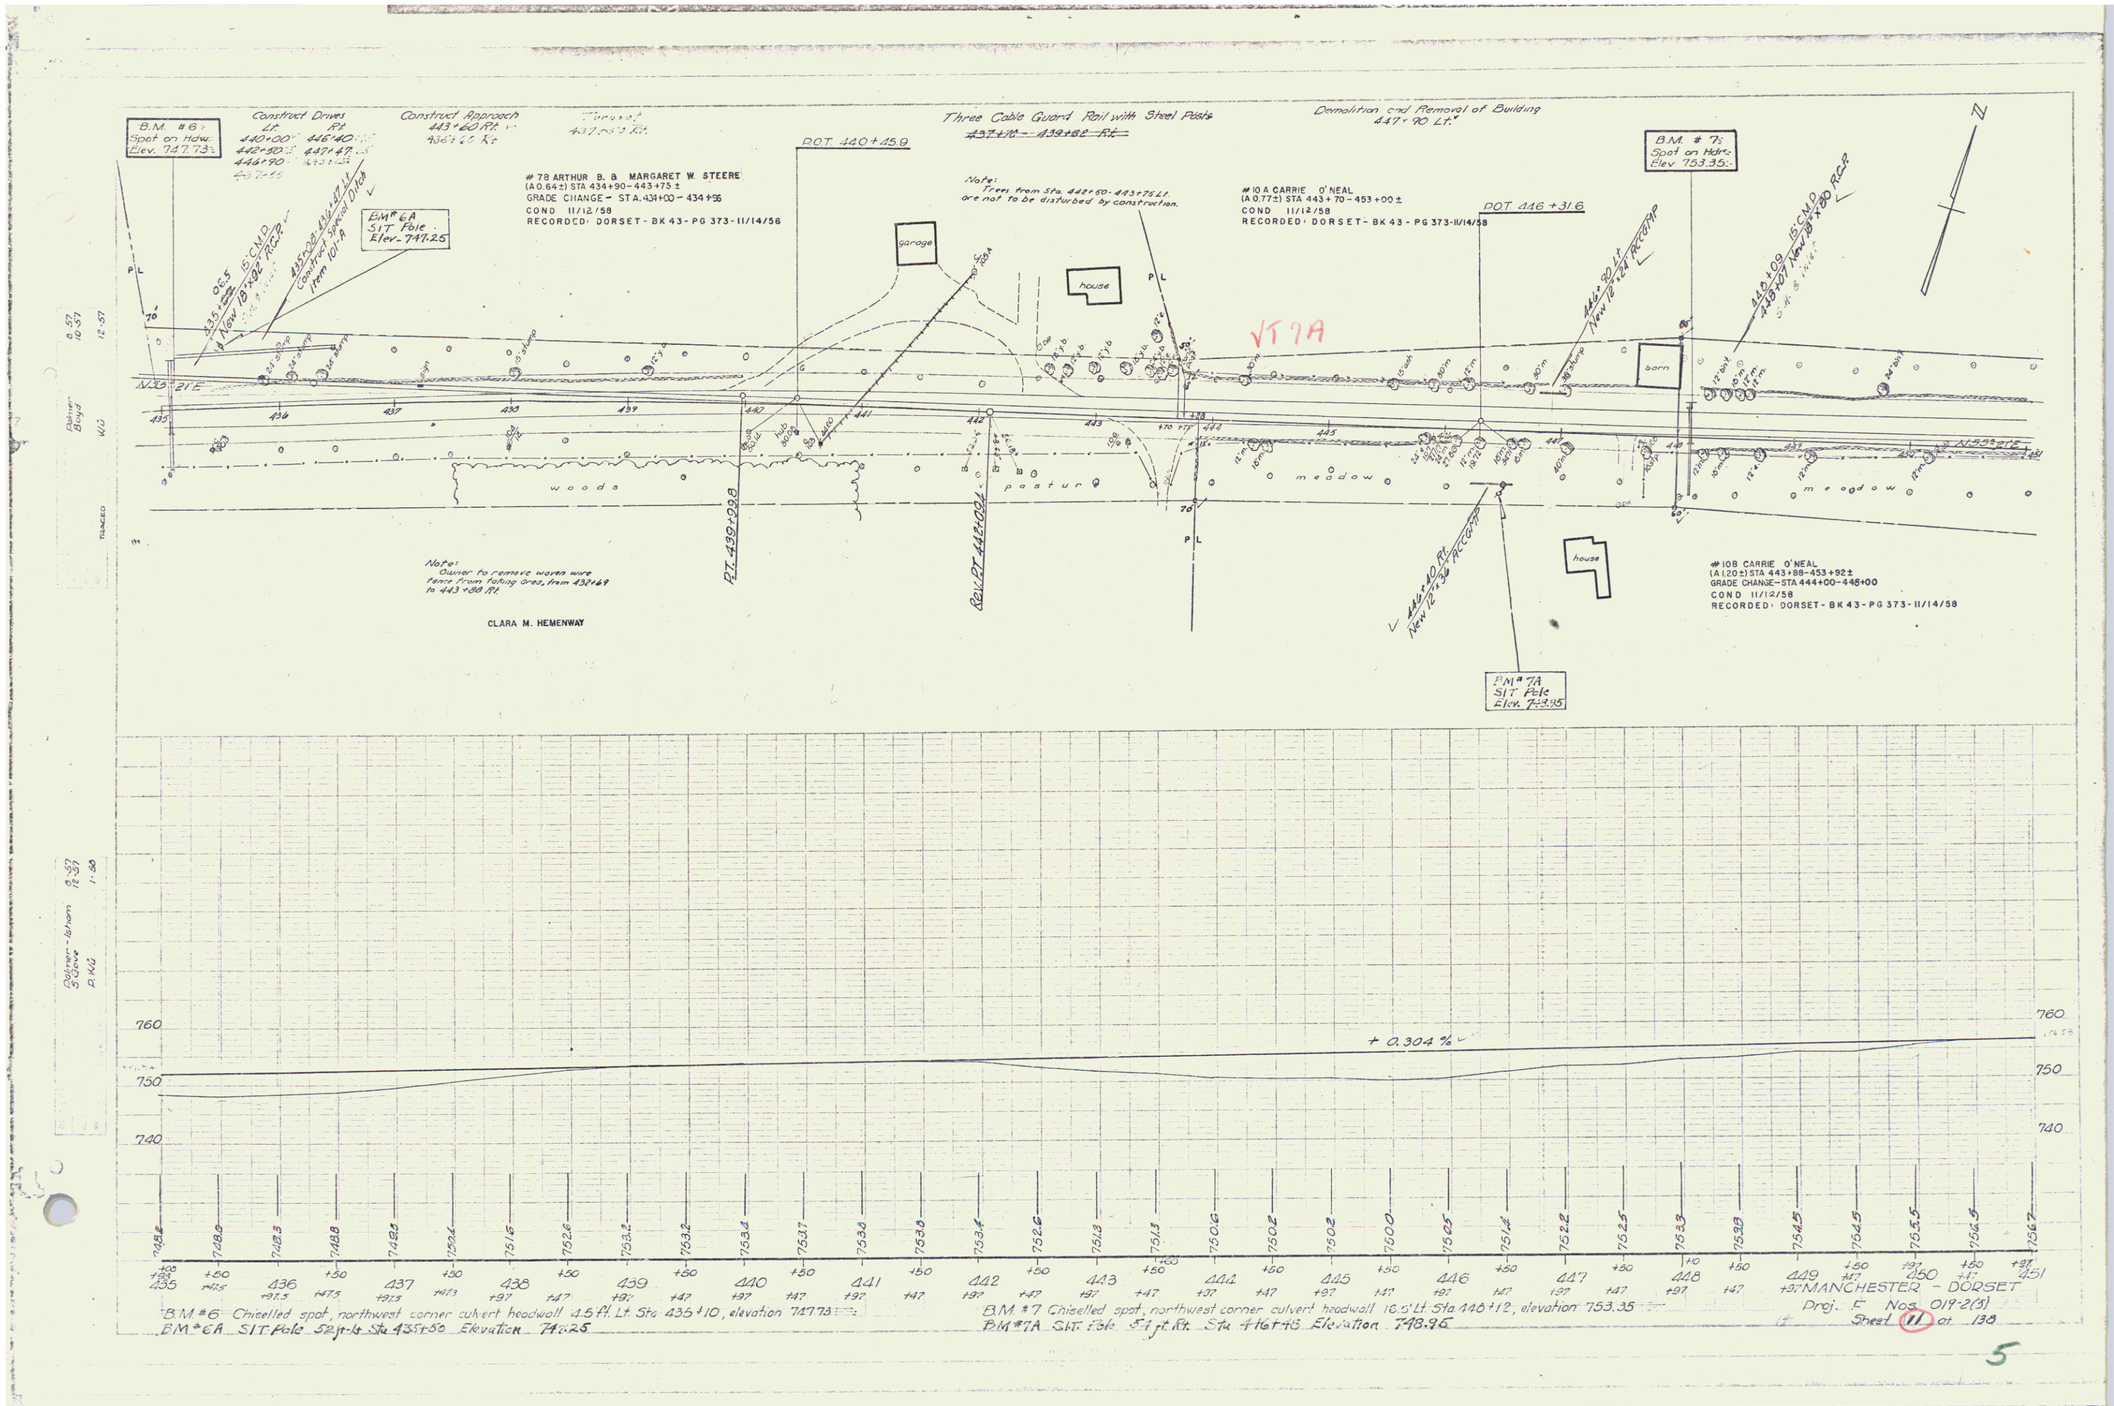
B.M. #6
Spot on Hdw.
Elev. 747.73±
Construct Drives
Lt Rt
440+00 446+40
442+90 447+47
444+90
Construct Approach
443+60 Rt.
436+60 Rt.
Turnout
437+00 Rt.
Three Cable Guard Rail with Steel Posts
~~437+00 - 439+82 Rt.~~
Demolition and Removal of Building
447+90 Lt.
B.M. #7
Spot on Hdrd.
Elev. 753.35±
POT. 440+45.9
POT. 446+31.6
#7B ARTHUR B. & MARGARET W. STEERE
(A0.64±) STA 434+90-443+75±
GRADE CHANGE - STA. 434+00 - 434+95
COND 11/12/58
RECORDED: DORSET - BK 43 - PG 373 - 11/14/58
Note:
Trees from Sta. 442+50-443+75 Lt.
are not to be disturbed by construction.
#10A CARRIE O'NEAL
(A0.77±) STA 443+70-453+00±
COND 11/12/58
RECORDED: DORSET - BK 43 - PG 373 - 11/14/58
BM# 6A
S.I.T. Pole
Elev. 747.25
435+50 15" C.M.P.
New 13+92 R.C.P.
435+00 436+40 Lt.
Construct Special Ditch
Item 101-A
garage
house
barn
house
VT7A
442+90 Lt.
New 12+24 R.C.C.I.P.
442+09 15" C.M.P.
438+01 New 13+80 R.C.P.
N 10° 21' E
N 43° 21' E
woods
pastur
meadow
meadow
PT. 439+09.8
Rev. PT. 441+00.1
442+10 Rt.
New 12+56 R.C.C.I.P.
Note:
Owner to remove worn wire
fence from falling area, from 432+69
to 443+08 Rt.
CLARA M. HEMENWAY
#10B CARRIE O'NEAL
(A1.20±) STA 443+88-453+92±
GRADE CHANGE - STA 444+00-448+00
COND 11/12/58
RECORDED: DORSET - BK 43 - PG 373 - 11/14/58
BM# 7A
S.I.T. Pole
760
750
740
+ 0.304 %
435 436 437 438 439 440 441 442 443 444 445 446 447 448 449 450 451
B.M. #6 Chiselled spot, northwest corner culvert headwall 4.5 ft. Lt. Sta 435+10, elevation 747.73
BM# 6A S.I.T. Pole 52 ft. Lt. Sta 435+50 Elevation 747.25
B.M. #7 Chiselled spot, northwest corner culvert headwall 16.5' Lt. Sta 448+12, elevation 753.35
BM# 7A S.I.T. Pole 57 ft. Rt. Sta 446+48 Elevation 748.96
MANCHESTER - DORSET
Proj. F Nos. 019-2(3)
Sheet 11 of 138

5